




1 Site Plan  
AS001 1/32" = 1'-0"

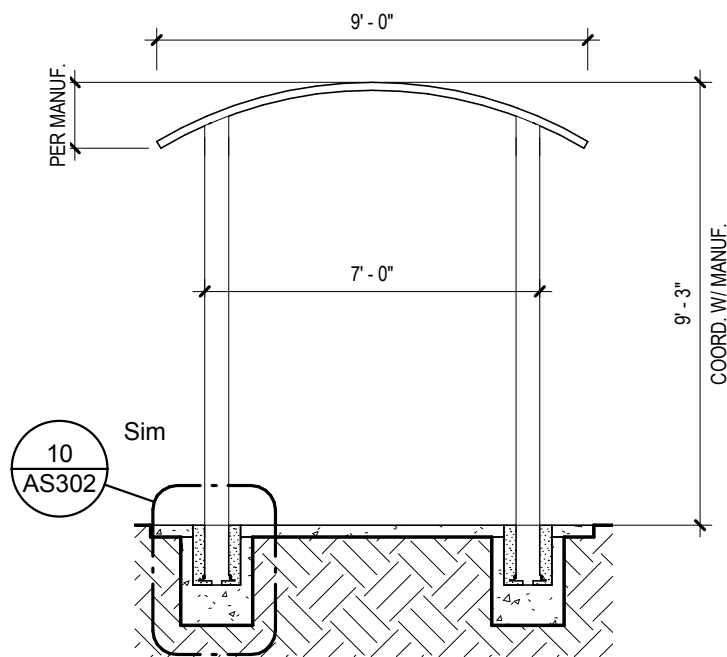

3 Walkway Canopy Section  
AS001 1/4" = 1'-0"

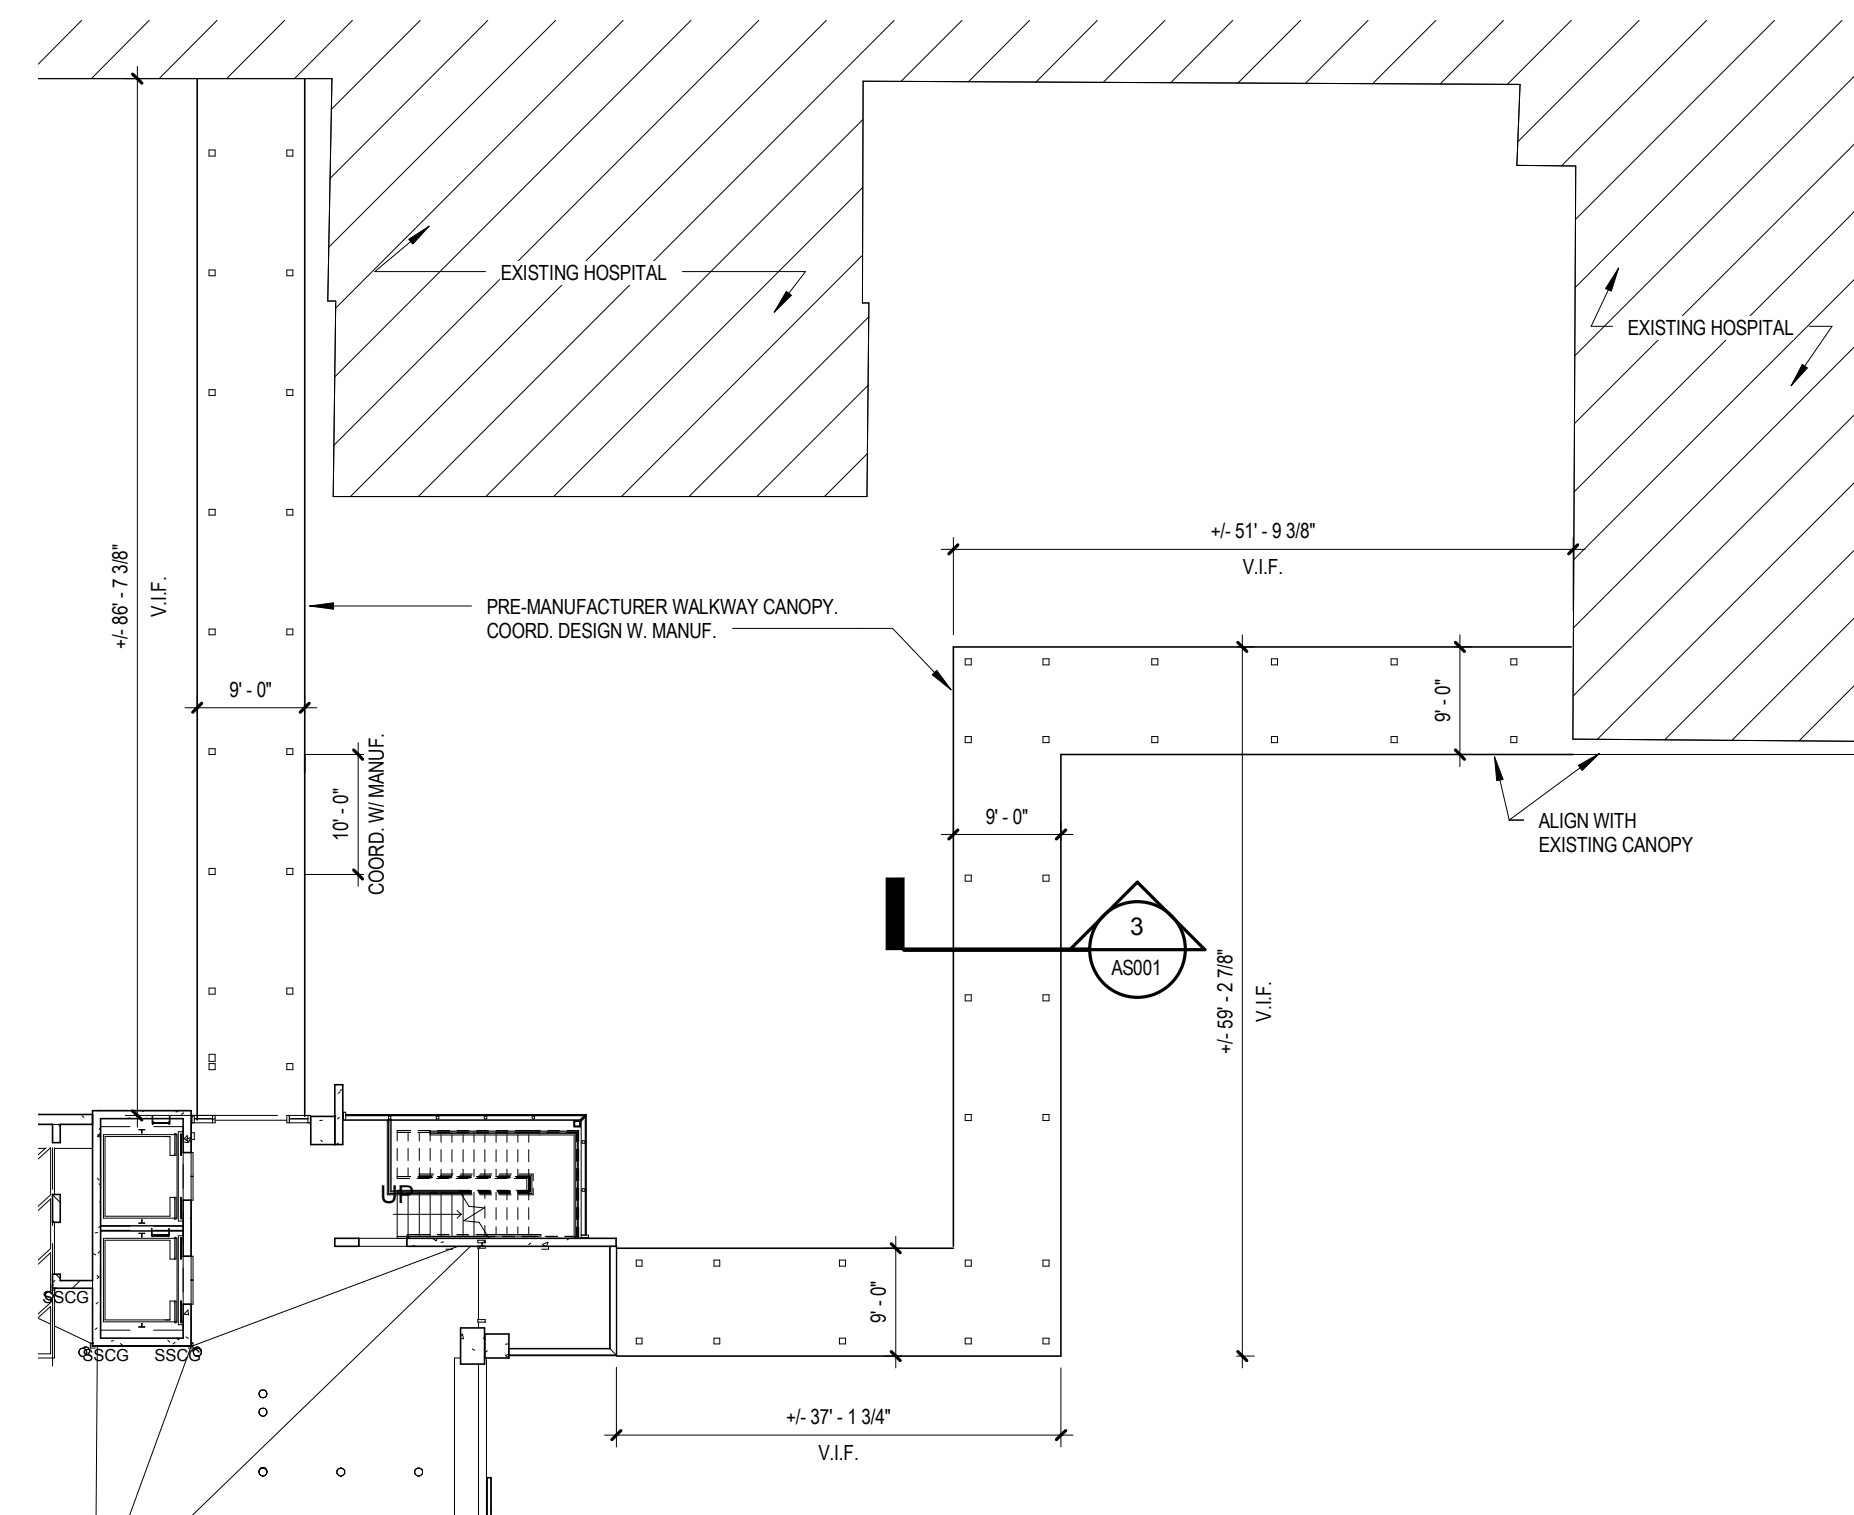

2 Enlarged Walkway Canopy Plan  
AS001 1/16" = 1'-0"

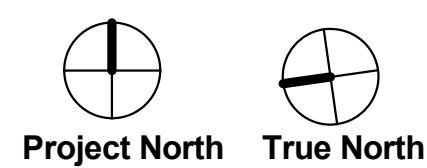

100% CONSTRUCTION DOCUMENT SUBMISSION

				ARCHITECT/ENGINEERS:		Drawing Title		Project Title		VA Project Number		Office of Construction and Facilities Management	
				<div><div></div><div>architecture planning interior design</div><div>IKM Incorporated One PPG Place Pittsburgh, PA 15222 412-281-1337 www.ikmnc.com</div></div>		Site Plan - Architectural		VA Clarksburg Parking Garage		540-320 IKM Project Number 10-163			
						Approved: Project Director		Location VAMC Clarksburg West Virginia		Building Number		AS001	
								Date 13 February 2012		Drawing Number			
EXHIBIT F - CLARIFICATION		04-02-2014										Dwg. of	
Revisions:		Date											
												Department of Veterans Affairs	