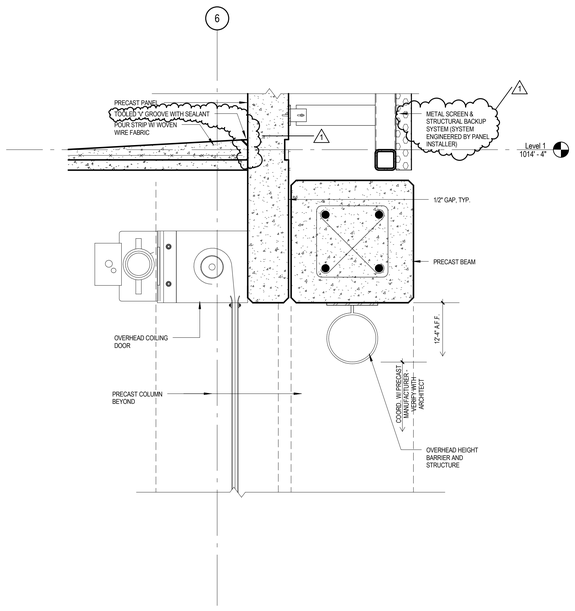

5 AS301 Vehicular Entrance Opening, Typical Both Entrances
1" = 1'-0"

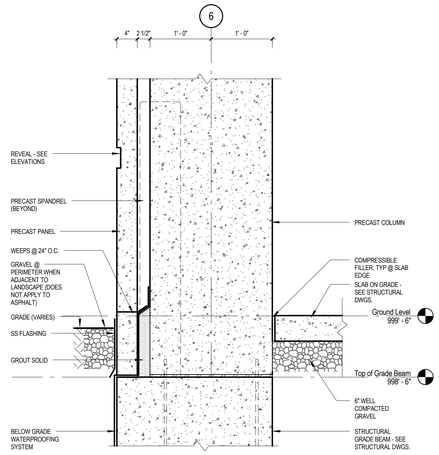

3 AS301 Typical Column Detail @ Grade
1" = 1'-0"

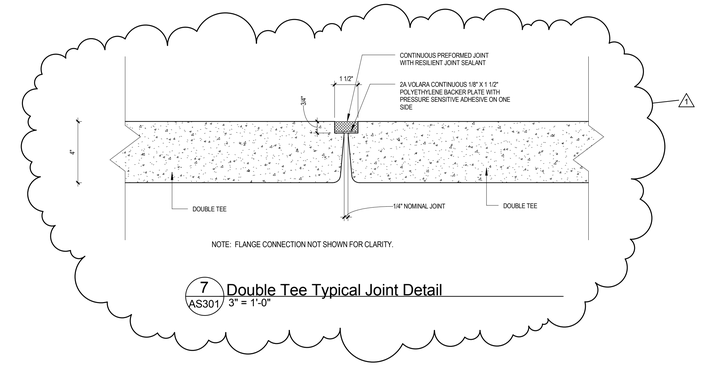

7 AS301 Double Tee Typical Joint Detail
3" = 1'-0"

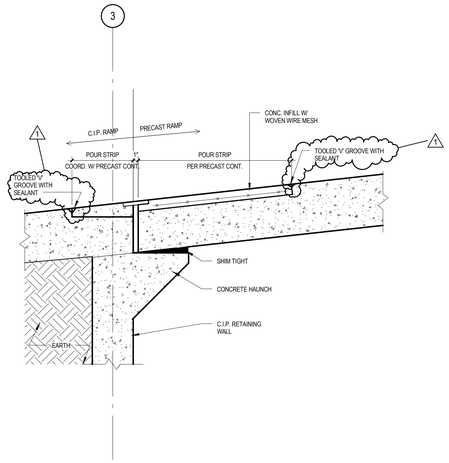

4 AS301 Double Tee to C.I.P Ramp @ Expansion Joint
1" = 1'-0"

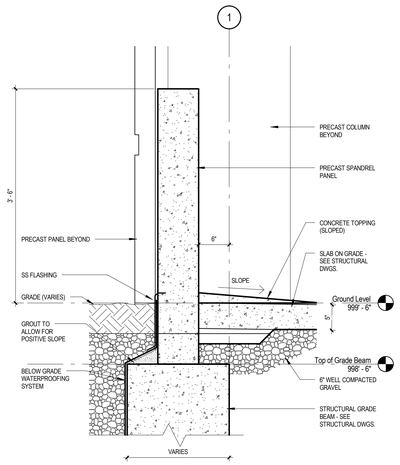

2 AS301 Section @ Grade Beam (Typical)
1" = 1'-0"

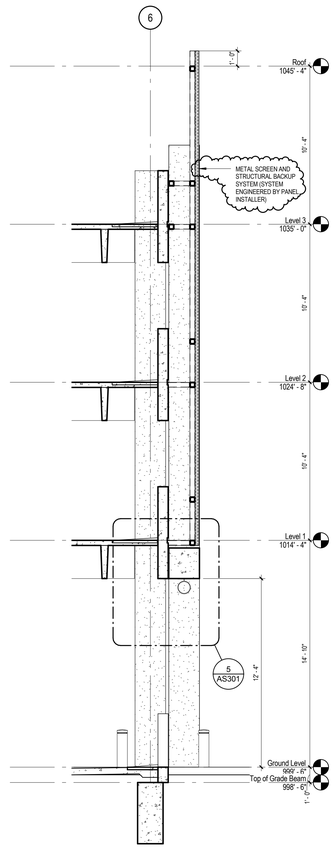

8 AS301 Wall Section Thru Entrance
1/4" = 1'-0"

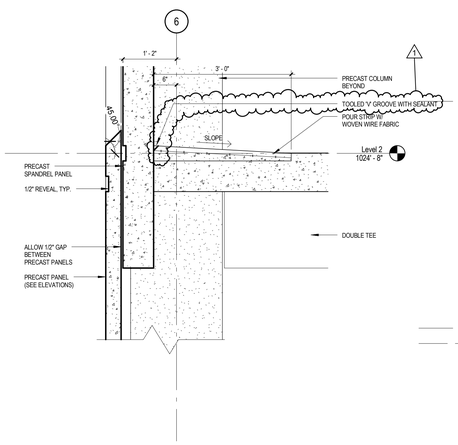

6 AS301 Non-Load Bearing Spandrel Detail
3/4" = 1'-0"

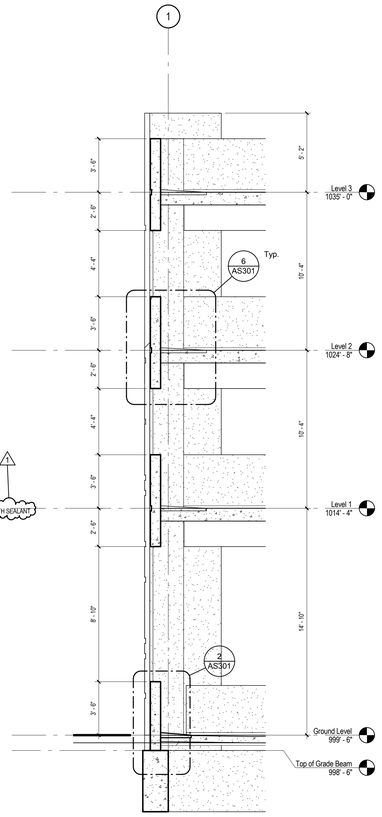

1 AS301 Wall Section, Typ.
1/4" = 1'-0"

0' 2' 4' 8'

100% CONSTRUCTION DOCUMENT SUBMISSION

Revisions:	Date
EXHIBIT F - CLARIFICATION	04-09-2014

CONSULTANTS:

ARCHITECT/ENGINEERS:

IKM

architecture
planning
interior design

IKM Incorporated
One PPG Place
Pittsburgh, PA 15222
412-281-1337
www.ikminc.com

STATE OF WEST VIRGINIA
ROGER P. HARTLING
NO. 2865
Registered
ARCHITECT

Drawing Title
Wall Sections and Details

Approved: Project Director

Project Title
VA Clarksburg Parking Garage

Location
VAMC Clarksburg West Virginia

Date
13 February 2012

Checked

Drawn

VA Project Number
540-320
IKM Project Number
10-163

Building Number

Drawing Number
AS301

Dwg. of

Office of Construction and Facilities Management

Department of Veterans Affairs

VA FORM 08-6231