


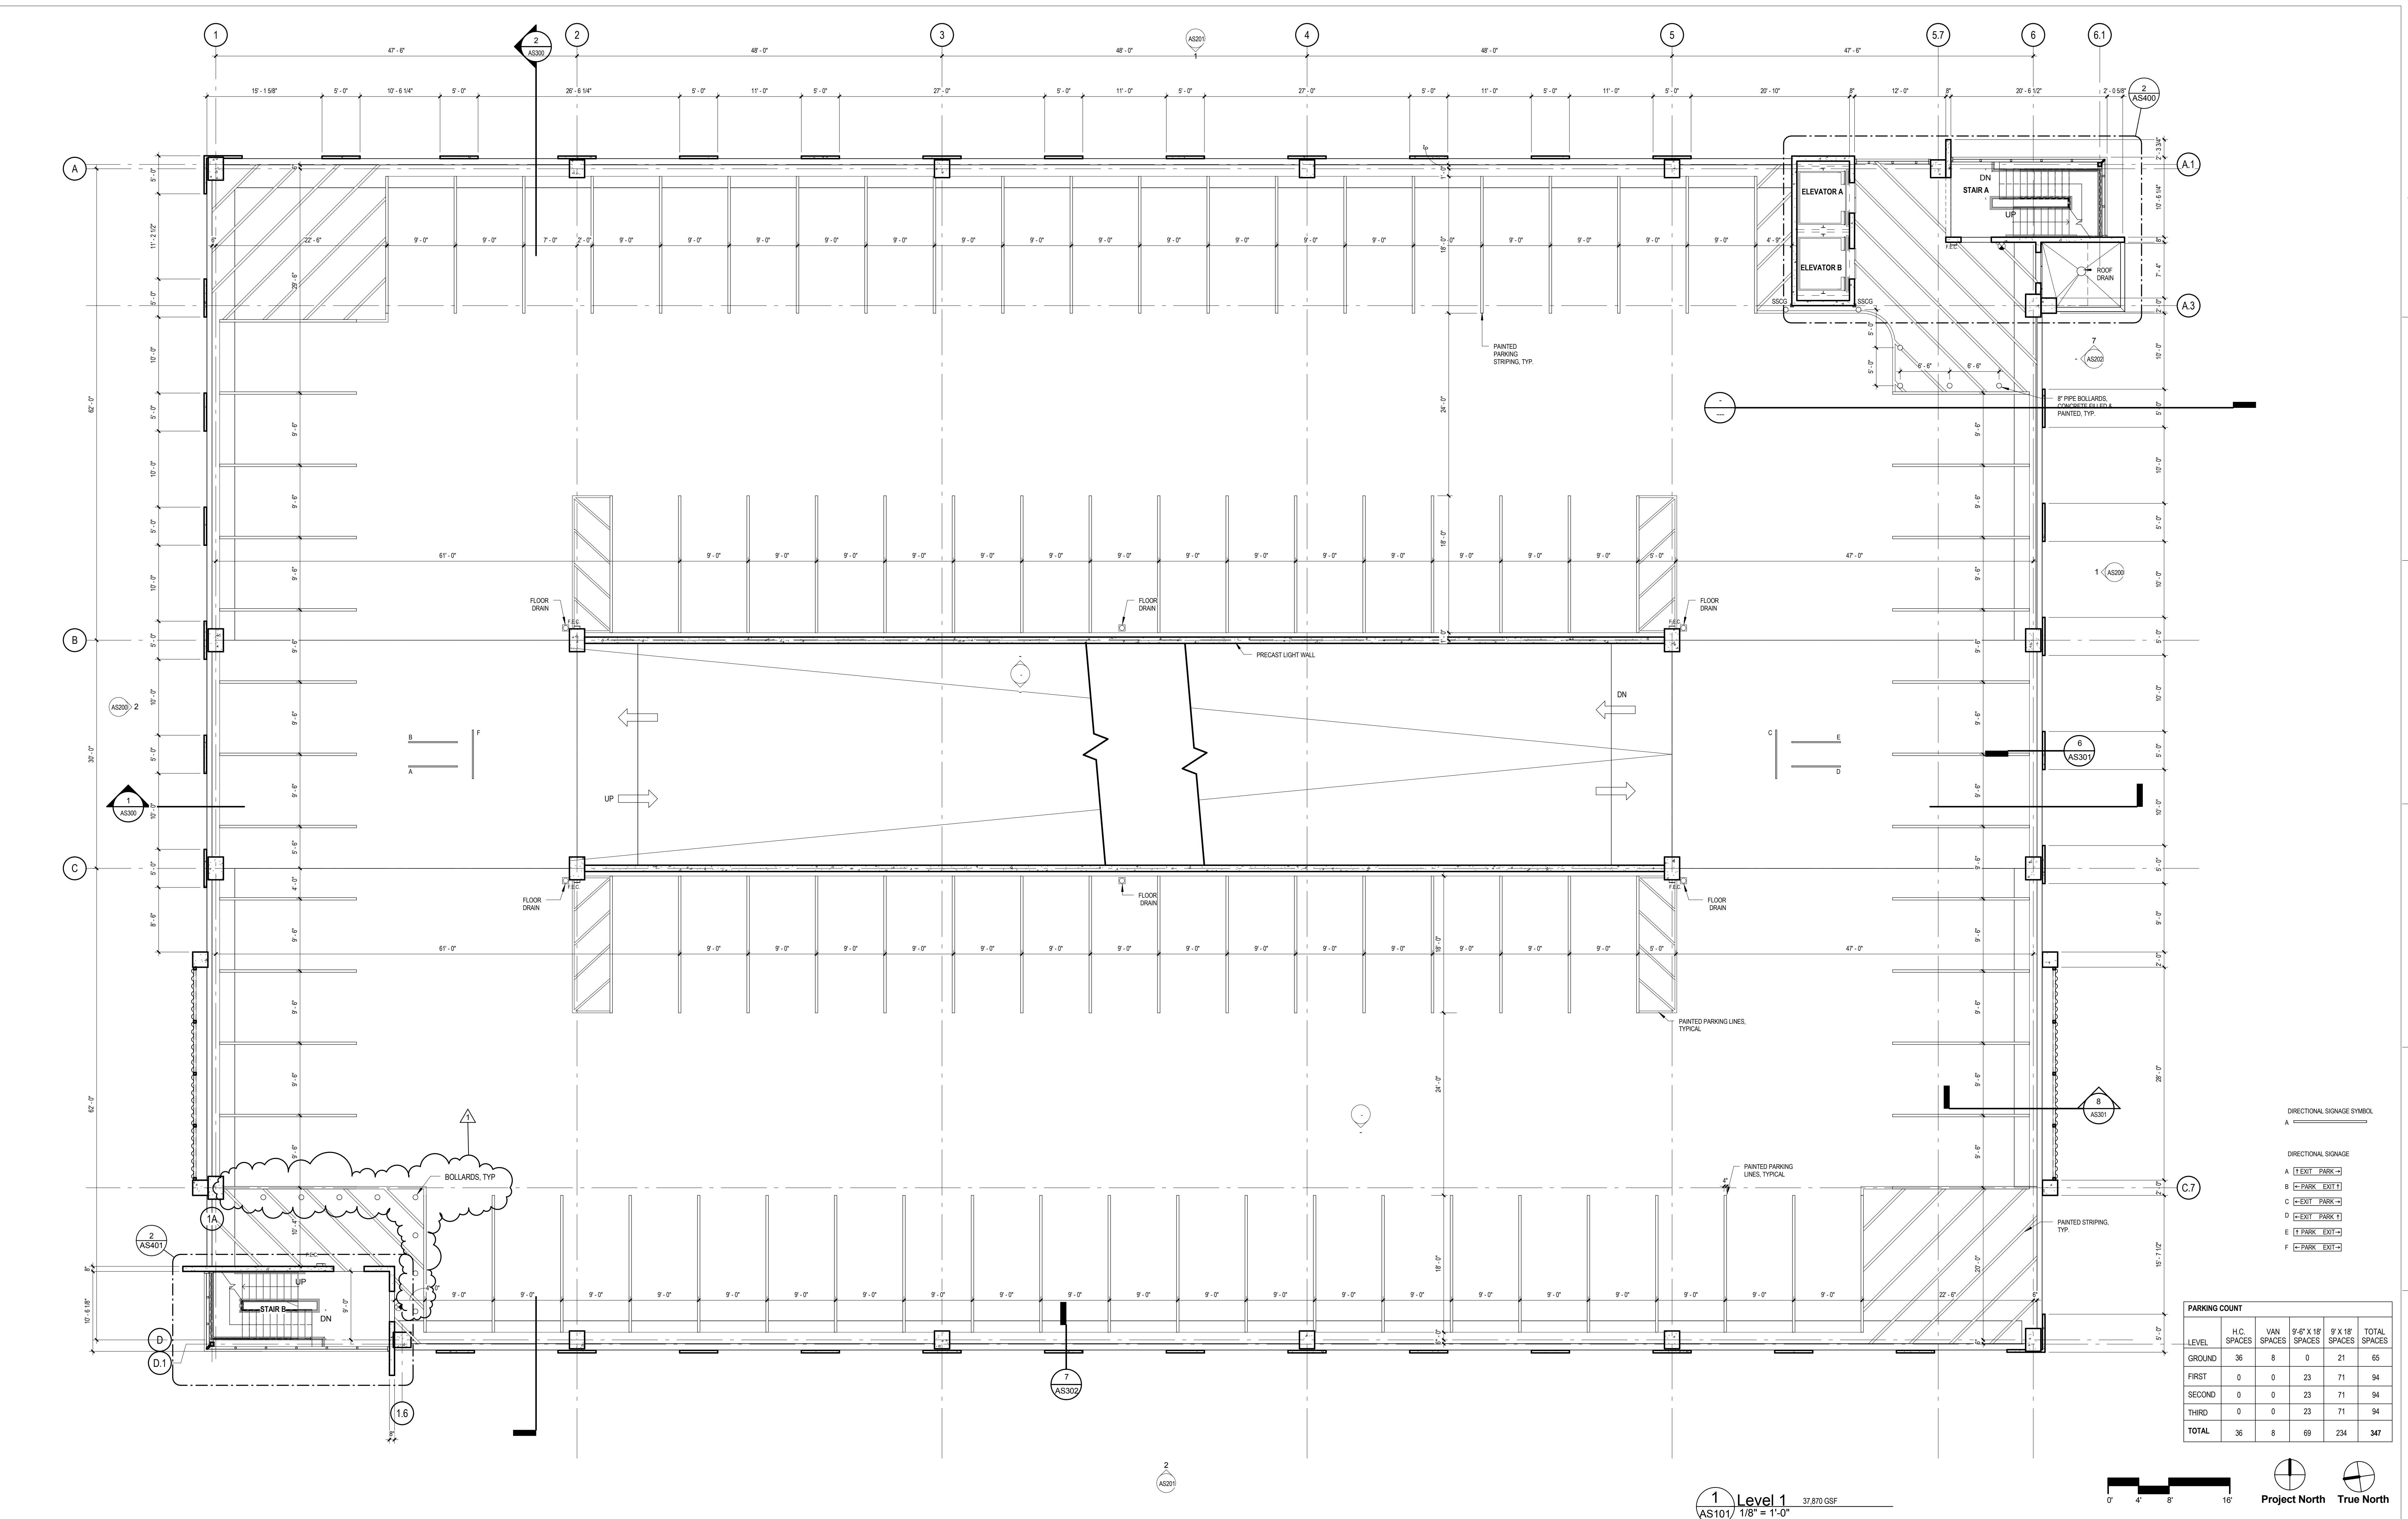

- DIRECTIONAL SIGNAGE SYMBOL
A
- DIRECTIONAL SIGNAGE
A (EXIT PARK)
B (EXIT PARK)
C (EXIT PARK)
D (EXIT PARK)
E (EXIT PARK)
F (EXIT PARK)

PARKING COUNT					
LEVEL	H.C. SPACES	VAN SPACES	9'-6" X 18' SPACES	9' X 18' SPACES	TOTAL SPACES
GROUND	36	8	0	21	65
FIRST	0	0	23	71	94
SECOND	0	0	23	71	94
THIRD	0	0	23	71	94
TOTAL	36	8	69	234	347

1 Level 1 37,870 GSF
AS101 1/8" = 1'-0"

100% CONSTRUCTION DOCUMENT SUBMISSION

EXHIBIT F - CLARIFICATION

Revisions:

04-02-2014

Date

CONSULTANTS:

ARCHITECT/ENGINEERS:

IKM

architecture
planning
interior design
IKM Incorporated
One PPG Place
Pittsburgh, PA 15222
412-281-1337
www.ikmnc.com

STATE OF WEST VIRGINIA

ROGER P. HARTUNG
NO. 3967
REGISTERED
ARCHITECT

Drawing Title

Level 1 Plan

Approved: Project Director

Project Title

VA Clarksburg
Parking Garage

Location

VAMC Clarksburg West Virginia

Date

13 February 2012

Checked

Drawn

VA Project Number
540-320
IKM Project Number
10-163

Building Number

Drawing Number

AS101

Dwg. of

Office of
Construction
and Facilities
Management

Department of
Veterans Affairs