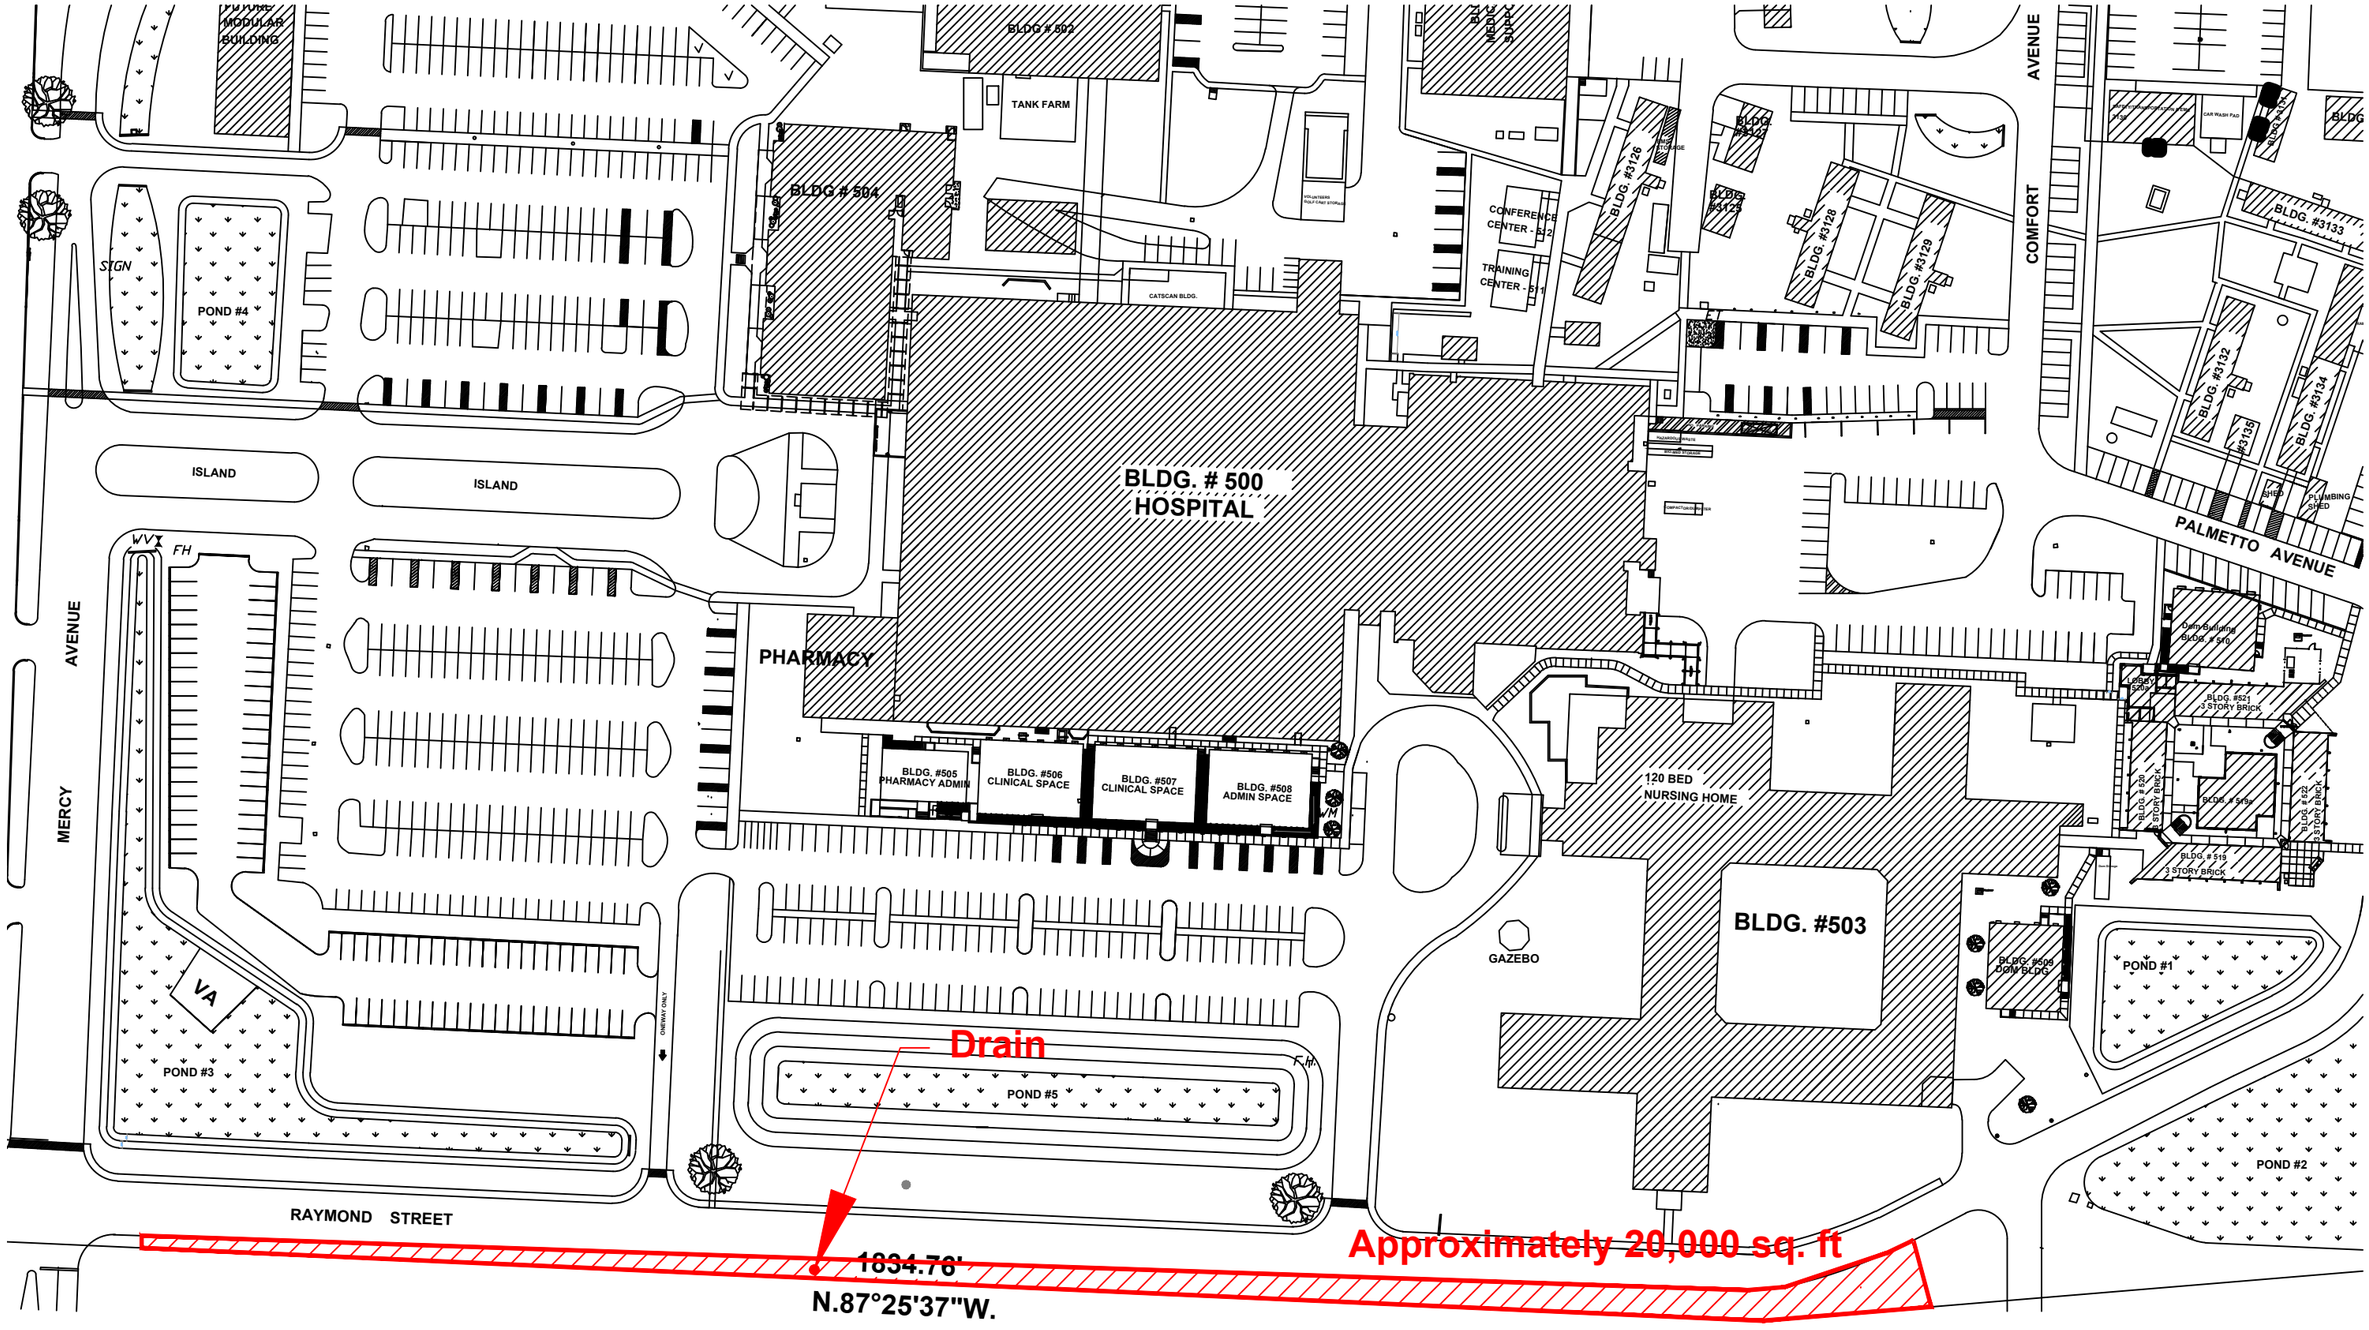

VA MEDICAL CENTER ORLANDO, FLORIDA

Install Erosion Control at South Property Line - Lake Baldwin

VHA NRM 675-14-804

N

Scale: N.T.S.

Office of Construction & Facilities Management

Department of Veterans Affairs