


Building 387

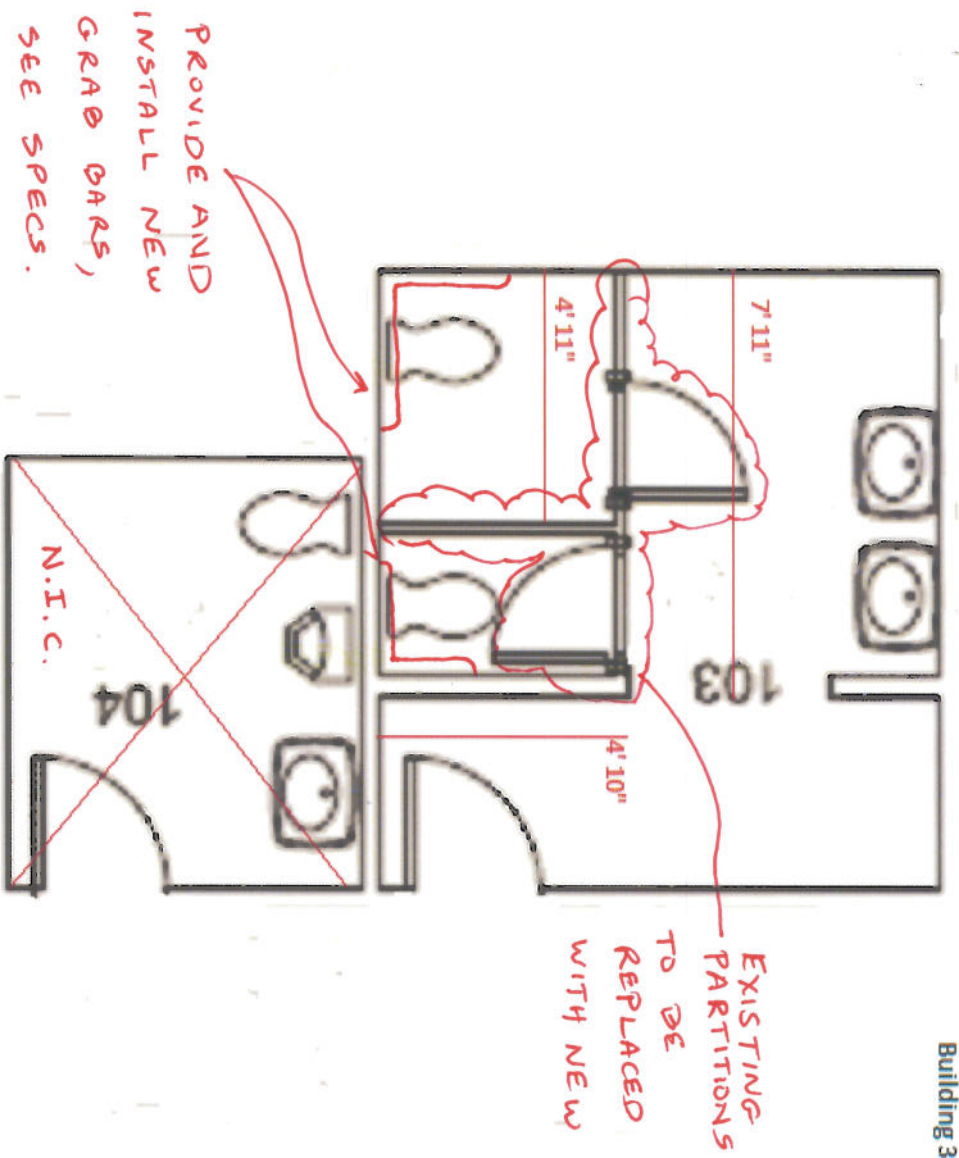

NO SCALE

A-1

A-1