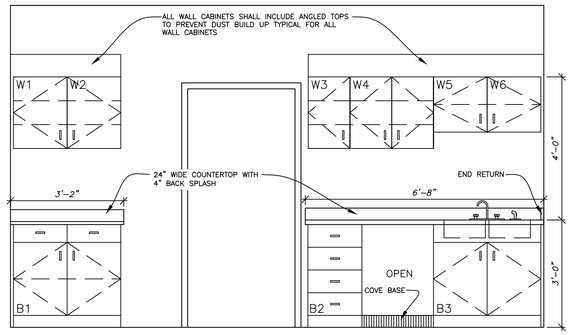

ELEVATION A

SCALE: 1/2" = 1'-0"

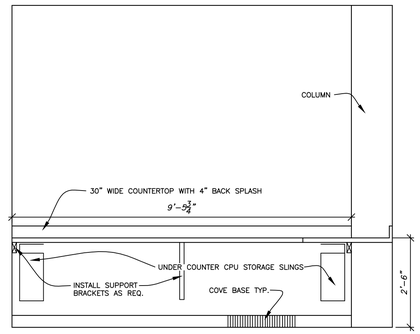

ELEVATION B

SCALE: 1/2" = 1'-0"

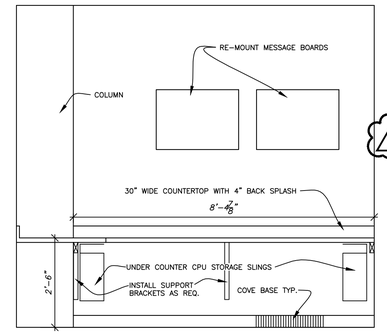

ELEVATION C

SCALE: 1/2" = 1'-0"

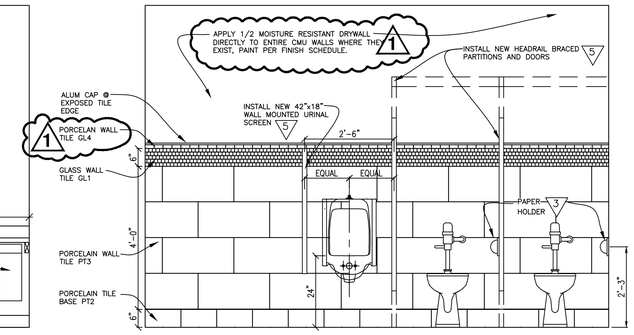

REVISED ELEVATION D

SCALE: 1/2" = 1'-0"

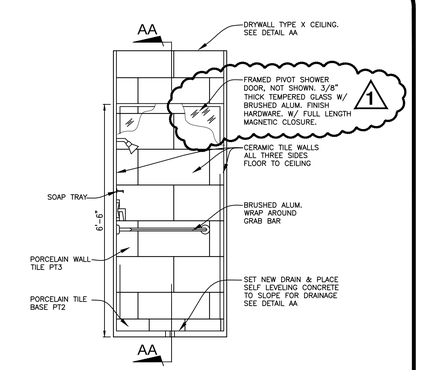

ELEVATION E

SCALE: 1/2" = 1'-0"

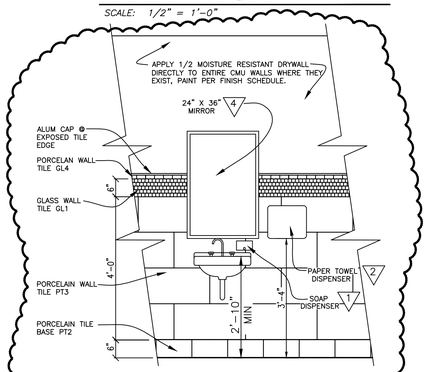

ELEVATION F

SCALE: 1/2" = 1'-0"

ROOM ACCESSORY SCHEDULE

ACCESSORIES	ITEM NUMBER	MOUNTING HEIGHT SCHED.
SOAP DISPENSER	1	A
PAPER TOWEL DISP	2	A
PAPER HOLDER	3	C
MIRROR	4	B
PARTITIONS/DOORS	5	D

NOTES

PROVIDE BLOCKING AND ANCHORS AS REQUIRED AND AS RECOMMENDED BY MFR.

SEE PLANS AND ELEVATIONS FOR ACCESSORY LOCATIONS.

A. BOTTOM OF DISPENSER TO BE IN LINE WITH BOTTOM OF MIRROR UNLESS SHOWN OTHERWISE.

B. BOTTOM OF MIRROR TO BE 39" ABOVE FLOOR.

C. CENTERLINE OF PAPER HOLDER TO BE 27" ABOVE FLOOR AND 36" FROM BACK WALL.

D. PARTITIONS AND DOOR FINISH SHALL BE BRUSHED ALUMINUM.

ROOM FINISH SCHEDULE

RM.NO.	ROOM NAME	FLOOR FINISH	BASE	WALLS	CEILING	NOTES
GD112	LOUNGE	RES-1,2	RB	P1,2	ACT	SEE NOTES 1, 2, 4, 5, 6, 8, 9
GD112A	MENS TOILET	PT	PT	PT/P4	ACT	SEE NOTES 1, 3, 4, 7, 9
GD112B	SHOWER	PT	PT	PT/P4	DW	SEE NOTES 1, 3, 4, 9
GD112C	COMPUTER ROOM	RES-1.2	RB	P1	ACT	SEE NOTES 1, 2, 4, 5, 6, 9
GD112D	MENS LOCKER	RES-1.2	RB	P1	ACT	SEE NOTES 1, 2, 4, 5, 6, 9

MATERIAL FINISH LEGEND

ACCOUSTIC CEILING TILE (ACT) — RUBBER BASE (RB) — RESILIANT FLOORING (RES)
PORCELAIN TILE (PT) — PAINT (P) — DRYWALL TYPE X AND PAINT (DW)

FINISH NOTES:

1. ACCOUSTIC CEILING TILE (ACT) SHALL BE 2x2 LAY IN TYPE, WASHABLE, MOLD, BACTERIA & MILDEW RESISTANT. INSTALL NEW GRID.
2. NEW PARTITION WALLS IN THIS ROOM SHALL BE PAINTED AND RECEIVE SAME FINISHES TO MATCH AS REQUIRED. REFER TO MATERIAL & COLOR LEGEND.
3. TOILET ROOMS SHALL RECEIVE COMBINATION PORCELAIN TILES FROM FLOOR TO 5'-0" AND PAINTED WALLS ABOVE, SEE ELEVATION DETAILS & MATERIAL & COLOR LEGEND. SHOWERS SHALL RECEIVE PORCELAIN TILES FROM FLOOR TO CEILING. SEE ELEVATIONS & DETAIL.
4. PAINT (P) 1 COAT SHERWIN WILLIAMS MULTI-PURPOSE LATEX PRIMER, 2 COATS SHERWIN WILLIAMS SEMI GLOSS LATEX FINISH. COLOR REFER TO MATERIAL & COLOR LEGEND.
5. RUBBER BASE (RB) SHALL BE 5-1/4" HIGH WITH CONTOUR, COLOR – MANNINGTON 918 FLAX.
6. RESILIANT FLOORING (RES) TWO COLOR PATTERN T.B.D. REFER TO FLOOR PATTERN LAYOUT AND MATERIAL & COLOR LEGEND SHEET A2.
7. STAINLESS STEEL, BRUSH FINISH PARTITIONS SHALL BE FLOOR SUPPORTED AND HEADRAILS BRACED. HARDWARE SHALL INCLUDE HINGES, COAT RACK, PAPER HOLDER, DOOR PULL, CONCEALED LATCH & DOOR STOP.
8. ONE ACCENT WALL SHALL BE PAINTED P2 THIS ROOM. REFER TO MATERIAL & COLOR LEGEND SHEET A2.
9. EVERY DOOR & FRAME SHALL BE PAINTED P5 INCLUDE BOTH SIDES. REFER TO MATERIAL & COLOR LEGEND SHEET A2.

CASEWORK SCHEDULE

CASEWORK NUMBER	MANUFACTURER'S SERIES	SIZE W"	SIZE H"	SIZE D"	CASEWORK TYPE	ADJ. SHELF	DOORS	DRWRS	REMARKS
B1		36"	36"	23"	DOOR/DRAWER	1	2	2	
B2		18"	36"	23"	DRAWER	–	–	4	
B3		36"	36"	23"	SINK CABINET	–	2	–	
W1		18"	24"	16"	LEFT HINGED DOOR	2	1	–	
W2		18"	24"	16"	RIGHT HINGED DOOR	2	1	–	
W3		14"	24"	16"	LEFT HINGED DOOR	2	1	–	
W4		28"	24"	16"	HINGED DOORS	2	2	–	
W5		18"	18"	16"	LEFT HINGED DOOR	1	1	–	
W6		18"	18"	16"	RIGHT HINGED DOOR	1	1	–	

CASEWORK NOTES

GENERAL CONTRACTOR TO VERIFY SIZE OF COUNTERTOPS.
ALL CABINET JOINTS ARE TO BE FLUSH WITHOUT OVERLAPS.
FIXTURES AND CONNECTIONS BY PLUMBING CONTRACTOR.
COUNTER TOPS SHALL HAVE 4" H BACK SPLASH, FIELD JOINT & MARINE EDGED.
COUNTER TOPS & BACKSPLASH SHALL SHALL BE SOLID SURFACE CORIAN.
PROVIDE REAR, FRONT & CORNER FILLERS (SIZE VARIES) AS REQUIRED.
ALL CASEWORK IS TO HAVE SOLID BACKS.
ALL DIMENSIONS SHOWN ON CASEWORK SCHEDULE ARE NOMINAL DIMENSIONS.

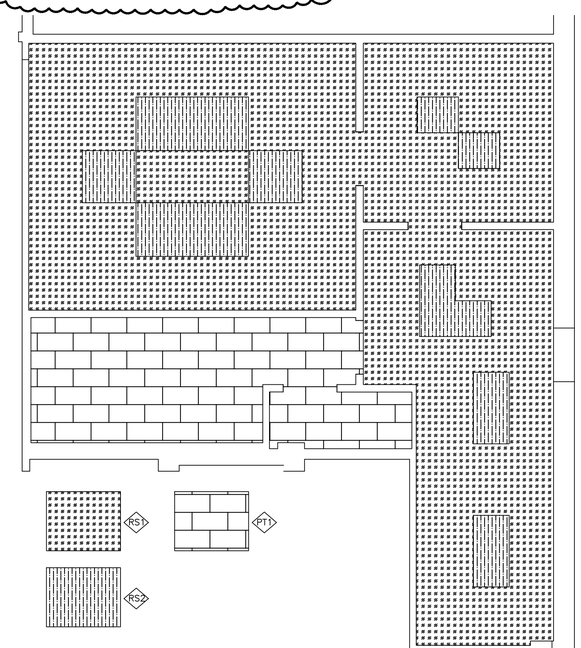

GROUND FLOOR FLOOR PATTERN FINISH PLAN

SCALE: 1/4" = 1'-0"

NOTE: FLOOR TILE LAYOUT REPRESENTS "EXAMPLE ONLY". FINAL FLOOR PATTERN SHALL BE FIELD DETERMINED BY VA INTERIOR DESIGN REPRESENTATIVE.

MATERIAL & COLOR LEGEND

TILE

PT1 PORCELAIN TILE
TYPE: FIELD FLOOR TILE
MFG: STONE PEAK
PATTERN: SKY COLLECTION
COLOR: MOONSKY
SIZE: 12" x 24"
NOTE: To be installed in a brick pattern
GROUT: BIRCH 903

PT2 PORCELAIN TILE
TYPE: COVE BASE: Unglazed – Honed
MFG: STONE PEAK
PATTERN: SKY COLLECTION
COLOR: MOONSKY
SIZE: 6" x 12"
GROUT: BIRCH 903

PT3 PORCELAIN TILE
TYPE: FIELD WALL TILE
MFG: WALKER – ZANGER
PATTERN: XILO COLLECTION
COLOR: TAUPE
SIZE: 12" x 24"
NOTE: To be installed in a brick pattern
GROUT: BIRCH 903

PT4 PORCELAIN TILE
MODEL: ST. GERMAIN PORCELAIN
MFG: AMERICAN OLEAN
PATTERN: 1 ROW OF 1/2"x 2" @ OEM SPACING
COLOR: SE 61 CREME
SIZE: 1"x 2" BRICK
GROUT: BIRCH 903
1

GL1 GLASS WALL TILE
MFG: LUNADA BAY
PATTERN: SUMI –E
COLOR: ZUSHI – NATURAL
SIZE: 1" x 4" BRICK
GROUT: TEC: BIRCH 903
NOTE: To be mounted in horizontal direction

CEILING

ACT ACOUSTIC CEILING TILE : 24"x 24"
MFG: ARMSTRONG
PATTERN: HEALTH ZONE ULTIMA
NOTES: BEVELED TEGULAR EDGE
COLOR: WHITE

FLOORING

RS1 RESILIANT FLOORING
TYPE: LINOLEUM
MFG: JOHNSONITE
PATTERN: HARMONIUM XF LENSA
COLOR: 300 WARM BISCUIT

RS2 RESILIANT FLOORING
TYPE: LINOLEUM
MFG: JOHNSONITE
PATTERN: HARMONIUM XF LENSA
COLOR: LNZ – 303 THICKET

WALLS

P1 PAINT GENERAL WALL
MFG: SHERWIN WILLIAMS
COLOR: SW 6154 NACRE

P2 PAINT ACCENT WALL
MFG: SHERWIN WILLIAMS
COLOR: SW 7542 NATURAL

P3 PAINT ACCENT WALL
MFG: SHERWIN WILLIAMS
COLOR: SW 7032 WARM STONE

P4 PAINT RESTROOMS
MFG: SHERWIN WILLIAMS
COLOR: SW 7036 ACCESSIBLE BEIGE

P5 PAINT GENERAL TRIM (DOORS & FRAMES)
MFG: SHERWIN WILLIAMS
COLOR: SW 7038 TONY TAUPE

MISCELLANEOUS

RB-1 RUBBER BASE
MFG: MANNINGTON
PATTERN: 5 1/4" REGAL EDGE EFFECTS
COLOR: 918 FLAX

DOORS EXISTING WOOD STAIN DOORS SHALL BE CLEANED, LIGHTLY SANDED & FINISHED W/ COMPATIBLE CLEAR FINISH TO BOTH SIDES.

EXISTING PAINTED DOORS SHALL BE CLEANED, LIGHTLY SANDED & PAINTED P5.

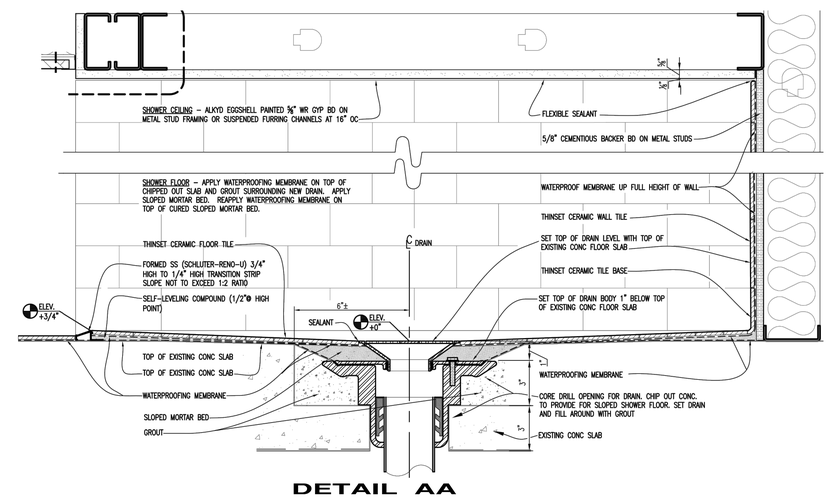

DETAIL AA SHOWER CEILING, FLOOR BASE & DRAIN

SCALE: N.T.S.

REV. NO.	REVISION DESCRIPTION	DATE
1	CHANGED SHOWER CURTAIN ROD TO A SHOWER DOOR. REVISED ELEVATION D, CERAMIC TILE PATTERN ADDED PT4 IN ELEVATIONS. PT4 MATERIAL WAS REPLACED WITH DIFFERENT BRAND DO TO DISCONTINUED PRODUCT. ADDED ELEVATION F	4-11-14

UNITED STATES DEPARTMENT OF VETERANS AFFAIRS
VA MEDICAL CENTER - 1540 SPRING VALLEY DRIVE - HUNTINGTON WV 25704

DRAWING TITLE: ELEVATIONS, SCHEDULES & DETAILS

PROJECT TITLE: LOCKER/BREAKROOM RENOVATION PROJECT

APPROVED: CHRIS ECKLES, ASS'T CHIEF, ENGINEERING

APPROVED: JOHN KLIM, CHIEF, ENGINEERING

BUILDING: 2

PROJECT NUMBER: 14-109

DRAWN: STEVE ELROD

DATE: JAN '14

DRAWING NUMBER: A2