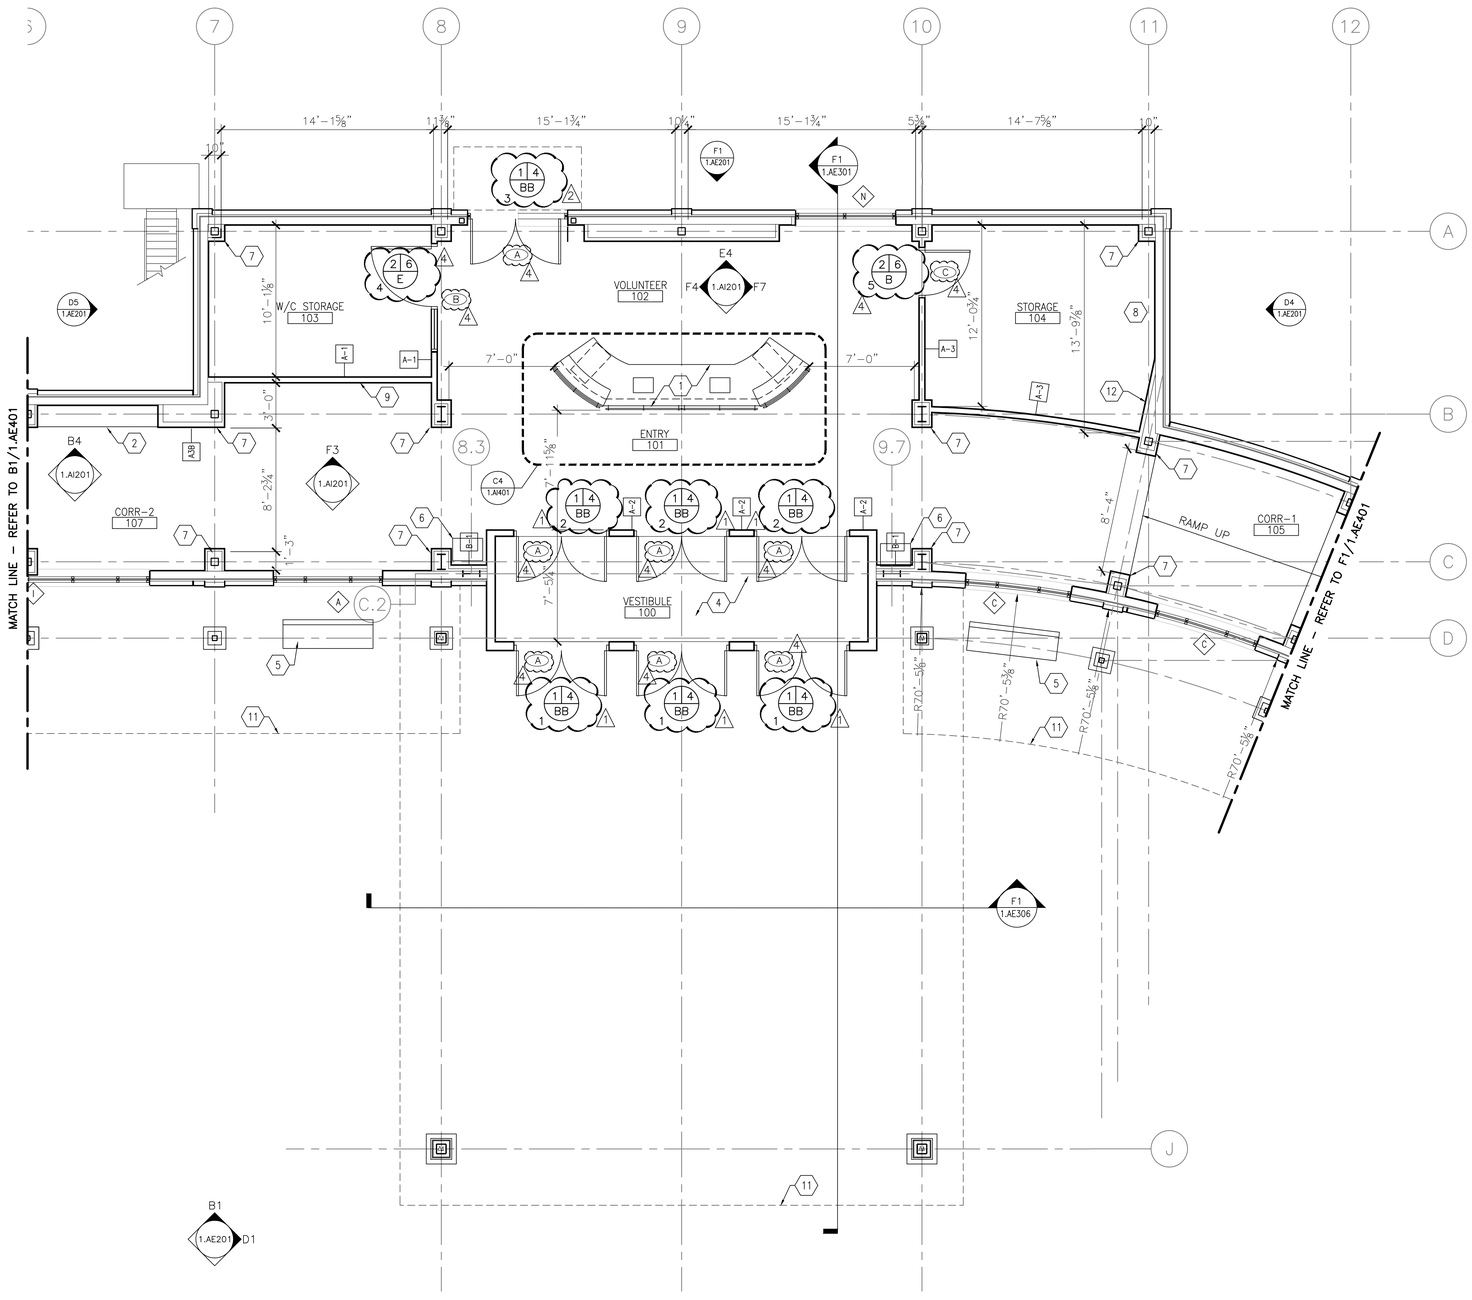

F1 ENLARGED FLOOR PLAN
1/4"=1'-0"

WALL LEGEND

A-1 — 3 5/8" MTL STUD WALL STUDS @ 16" O.C. W/ (1) LAYER OF 5/8" GYP BOTH SIDES, 4" ABOVE CEILING

A-2 — 3 5/8" MTL STUD WALL STUDS @ 16" O.C. W/ 4" BATT INSULATION, (1) LAYER OF 5/8" GYP BOTH SIDES.

A-3 — 1 HOUR FIRERATED – 3 5/8" MTL STUD WALL STUDS @ 16" O.C. W/ SOUND ATTENUATION, (1) LAYER OF TYPE X GYP BOTH SIDES, TO DECK.

A3B — 3 5/8" MTL STUD WALL STUDS @ 16" O.C. W/ 5/8" GYP ONE SIDE.

B-1 — 6" MTL STUD WALL STUDS @ 16" O.C. W/ 6" BATT INSULATION, (1) LAYER OF 5/8" GYP BOTH SIDES, 4" ABOVE CEILING

B-2 — 6" MTL STUD WALL STUDS @ 16" O.C. W/ (1) LAYER OF 5/8" GYP BOTH SIDES.

NOTES

1. REFER TO 1.AE001 FOR ARCHITECTURAL SYMBOLS AND ABBREVIATIONS.
2. REFER TO MECHANICAL, ELECTRICAL, AND PLUMBING SHEETS FOR SPECIFIC NOTES FOR OTHER THAN GENERAL NOTES.
3. REFER TO 1.AI602 FOR GLAZING SCHEDULE AND DETAILS.
4. REFER TO 1.AI601 FOR DOOR SCHEDULE AND DETAILS.
5. REFER TO CIVIL DRAWINGS FOR NEW SITE WORK.
6. REFER TO AI AND ID SERIES DWGS FOR FINISH DETAILS.
7. ALL ELEVATIONS ARE REFERENCED WITH 100'-0" = 552.00' ON THE CIVIL DWGS.

KEY NOTES

1. VOLUNTEER COUNTER CASEWORK; REFER TO C4/1.AI401 FOR DETAILS.
2. INTERIOR BENCH, REFER TO ELEVATION A1/1.AI301.
3. (NOT USED)
4. RECESS SLAB 1/2" TO ACCOMMODATE WALK OFF MAT – SEE DETAIL B6/1.ID501 FOR DETAILS.
5. EXTERIOR CONCRETE BENCH; REFER TO CIVIL DWGS. FOR DETAILS.
6. EMERGENCY CALL BOX; REFER TO ELECTRICAL DWGS. FOR DETAILS.
7. COLUMN SURROUND CONSTRUCTION SIMILAR TO DETAIL F5/1.AE401. EXPAND TO DIMENSIONS SHOWN AS REQUIRED.
8. COMPUTER BASED BUILDING AUTOMATION SYSTEM LOCATION.
9. DONOR WALL, REFER TO 1.AI301 FOR MORE INFORMATION.
10. (NOT USED)
11. CANOPY ABOVE.
12. FRAME WALL BACK TO EXTERIOR WALL AS INDICATED. CONSTRUCTION SIMILAR TO TYPE A3B WALL.

LEGEND

NEW DOORS
EXISTING DOORS TO REMAIN
NEW WALLS
EXISTING WALLS TO REMAIN
WINDOW TAG; REFER TO 1.AI602 FOR DETAILS

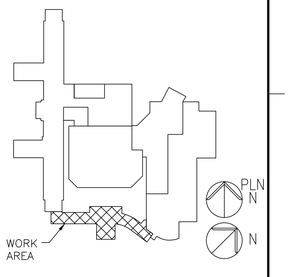

KEYPLAN - NOT TO SCALE
FULLY SPRINKLERED
BID DOCUMENTS 08-23-2013

Revisions	Date
Revision	01-10-14
Revision	03-18-14
Revision	04-02-14
Revision	04-04-14
REVISION 1	03/18/14

CONSULTANTS:

ARCHITECT/ENGINEERS:
PARADIGM
ENGINEERS AND CONSTRUCTORS
200 Envoy Circle #201, Louisville KY 40299 – PH: 502.339.8511 – www.paradigmusa.com

COMMONWEALTH OF PENNSYLVANIA
REGISTERED PROFESSIONAL ENGINEER
BLAINE VAN GANSBEKE
No. PE079536

Drawing Title: ENLARGED FLOOR PLANS
Approved: Project Director
Project Title: NEW FRONT ENTRANCE BUILDING 1
Location: LEBANON VAMC
1700 SOUTH LINCOLN AVE, LEBANON PA 17042-7529
Date: 06-28-2013
Checked: BVG
Drawn: JDM
Project Number: 595-11-125
Building Number: 1
Drawing Number: 1.AE402

Office of Construction and Facilities Management
Department of Veterans Affairs

VA FORM 08-6231