


Semi-Annual Update	7/3/13
Semi-Annual Update	9/13/12
Semi-Annual Update	3/14/12
Semi-Annual Update	3/16/11
Semi-Annual Update	9/17/10
Semi-Annual Update	3/23/10
Semi-Annual Update	8/4/09
Add Gravestones	2/23/09
	7/20/09
Revised Gravesite Layout	7/8/08
Revised Gravesite Layout	1/5/04
Revisions	Date

[illegible]

Scale 1 : 20

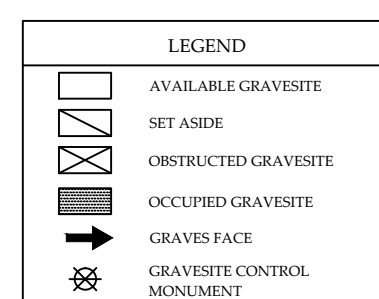

National Cemetery Administration
Memorial Service Network II
Decatur, Georgia 30033

Drawing Title <div style="text-align: center; font-size: 1.2em;">Section K Layout Drawing</div>		Project: Port Hudson National Cemetery Location: Zachary, LA		Date <div style="text-align: center; font-size: 1.2em;">3/25/10</div>
Approved: Area Director		Building Number	Checked <div style="text-align: center; font-size: 1.2em;">DCJ</div>	Project No.
Approved: Cemetery Director		Path: \\Cemata101\share\MSN II Drawings\Port Hudson\Updated Layout		Drawing Title: <div style="text-align: center; font-size: 1.2em;">870LA004 Section K</div>
				Dwg. Of