



three inches = one foot
 one and one half inches = one foot
 one inch = one foot
 three quarters inch = one foot
 one half inch = one foot
 three eighths inch = one foot
 one quarter inch = one foot
 one eighth inch = one foot

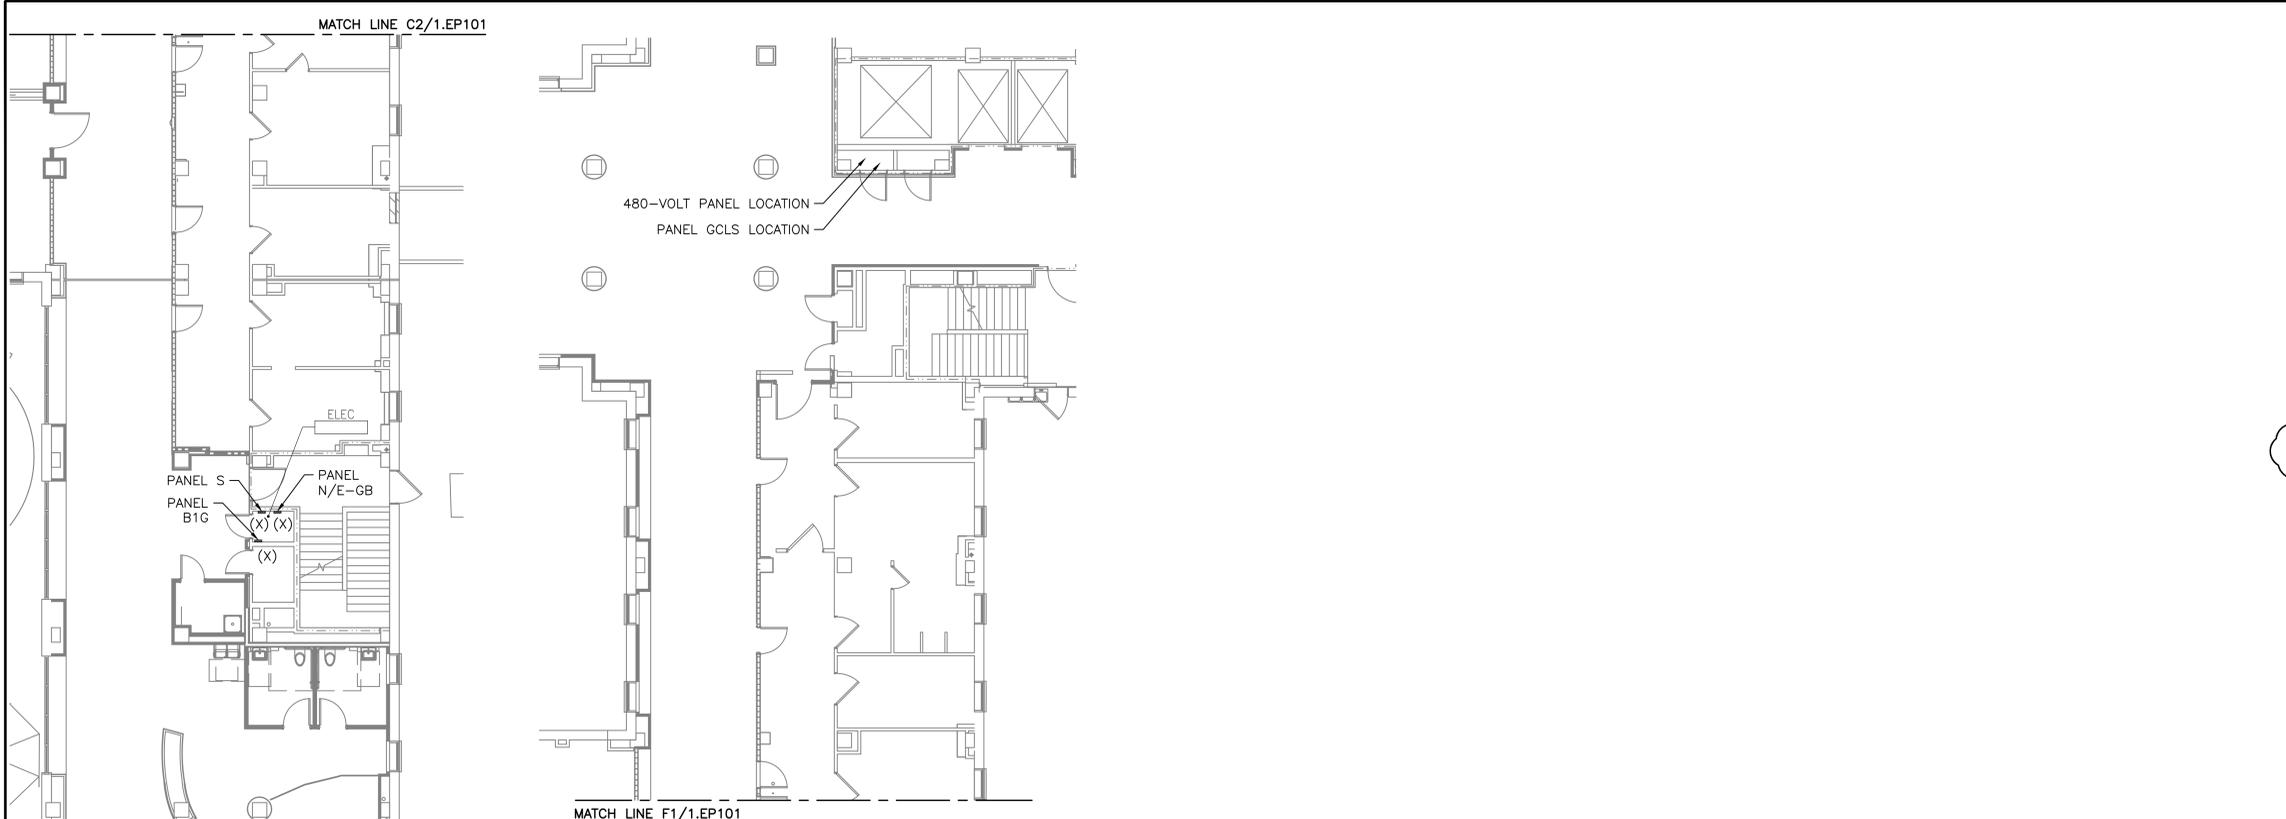


C2 PARTIAL FIRST FLOOR PLAN
 1/8" = 1'-0"

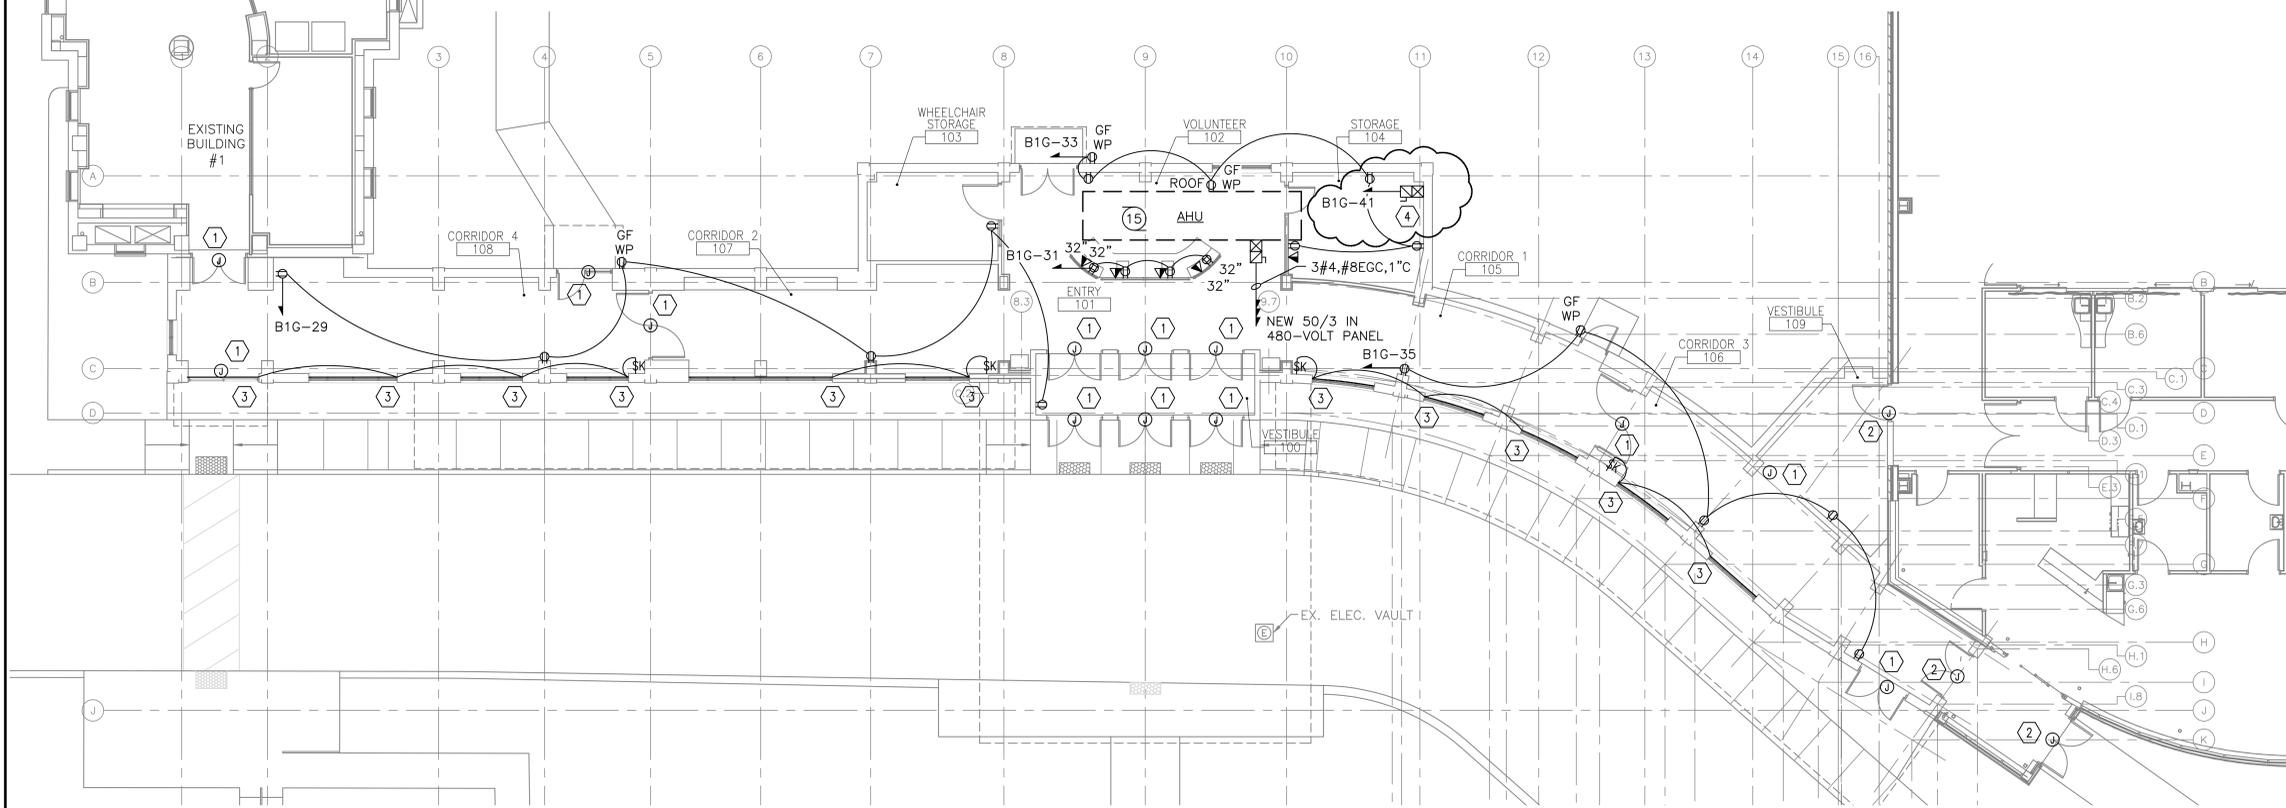

F1 PARTIAL FIRST FLOOR PLAN
 1/8" = 1'-0"

- NOTES**
- REFER TO SHEET 1.E-001 FOR LEGEND, ABBREVIATIONS, SCHEDULES AND GENERAL NOTES.
 - ALL RECEPTACLES SHALL BE UL LISTED AND MARKED AS HOSPITAL GRADE.
 - REFER TO ARCHITECT'S CASEWORK DETAILS AND ROOM ELEVATIONS FOR EXACT LOCATIONS AND MOUNTING HEIGHTS OF DEVICES.
- KEYED NOTES**
- CONNECT AUTOMATIC DOOR OPERATORS TO LIFE SAFETY PANEL 'GCLS' CIRCUIT 10.
 - CONNECT AUTOMATIC DOOR OPERATORS TO EXISTING LIFE SAFETY CIRCUIT FROM SURGERY BUILDING.
 - CONNECT AUTOMATIC SHADES IN CLERESTORY WINDOWS TO CIRCUIT 'B1G-37'. INSTALL ALL WIRING AND PROVIDE ALL CONNECTIONS AS REQUIRED FOR SUBMITTED SHADE PRODUCTS INCLUDING INSTALLATION OF ALL POWER SUPPLIES, SENSORS, AND ACCESSORIES.
 - CONNECT SPRINKLER AIR COMPRESSOR INCLUDING 120-VOLT CONTROLS. FURNISH AND INSTALL CIRCUIT BREAKER LOCK.

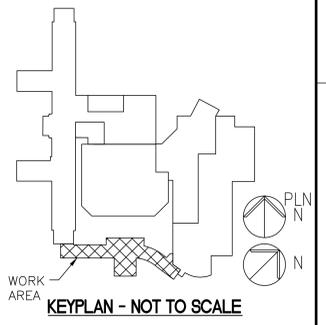

FULLY SPRINKLERED
 BID DOCUMENTS 08-23-2013

AMENDMENT	Date
Revisions	04-22-14

CONSULTANTS:

ARCHITECT/ENGINEERS:

PARADIGM
 ENGINEERS AND CONSTRUCTORS

200 Envoy Circle #201, Louisville KY 40299 - PH: 502.339.8511 - www.paradigmusa.com

Blaine Van Gansbeke
 REGISTERED PROFESSIONAL ENGINEER
 No. PE079636
 PENNSYLVANIA

Drawing Title: ELECTRICAL POWER PLAN
 Approved Project Director:

Project Title: NEW FRONT ENTRANCE BUILDING 1
 Project Number: 595-11-125
 Building Number: 1
 Drawing Number: 1.EP101

Location: LEBANON VAMC
 700 SOUTH LINCOLN AVE, LEBANON PA 17042-7829

Date: 06-28-2013
 Checked: BVG
 Drawn: BAM

Office of Construction and Facilities Management
 Department of Veterans Affairs