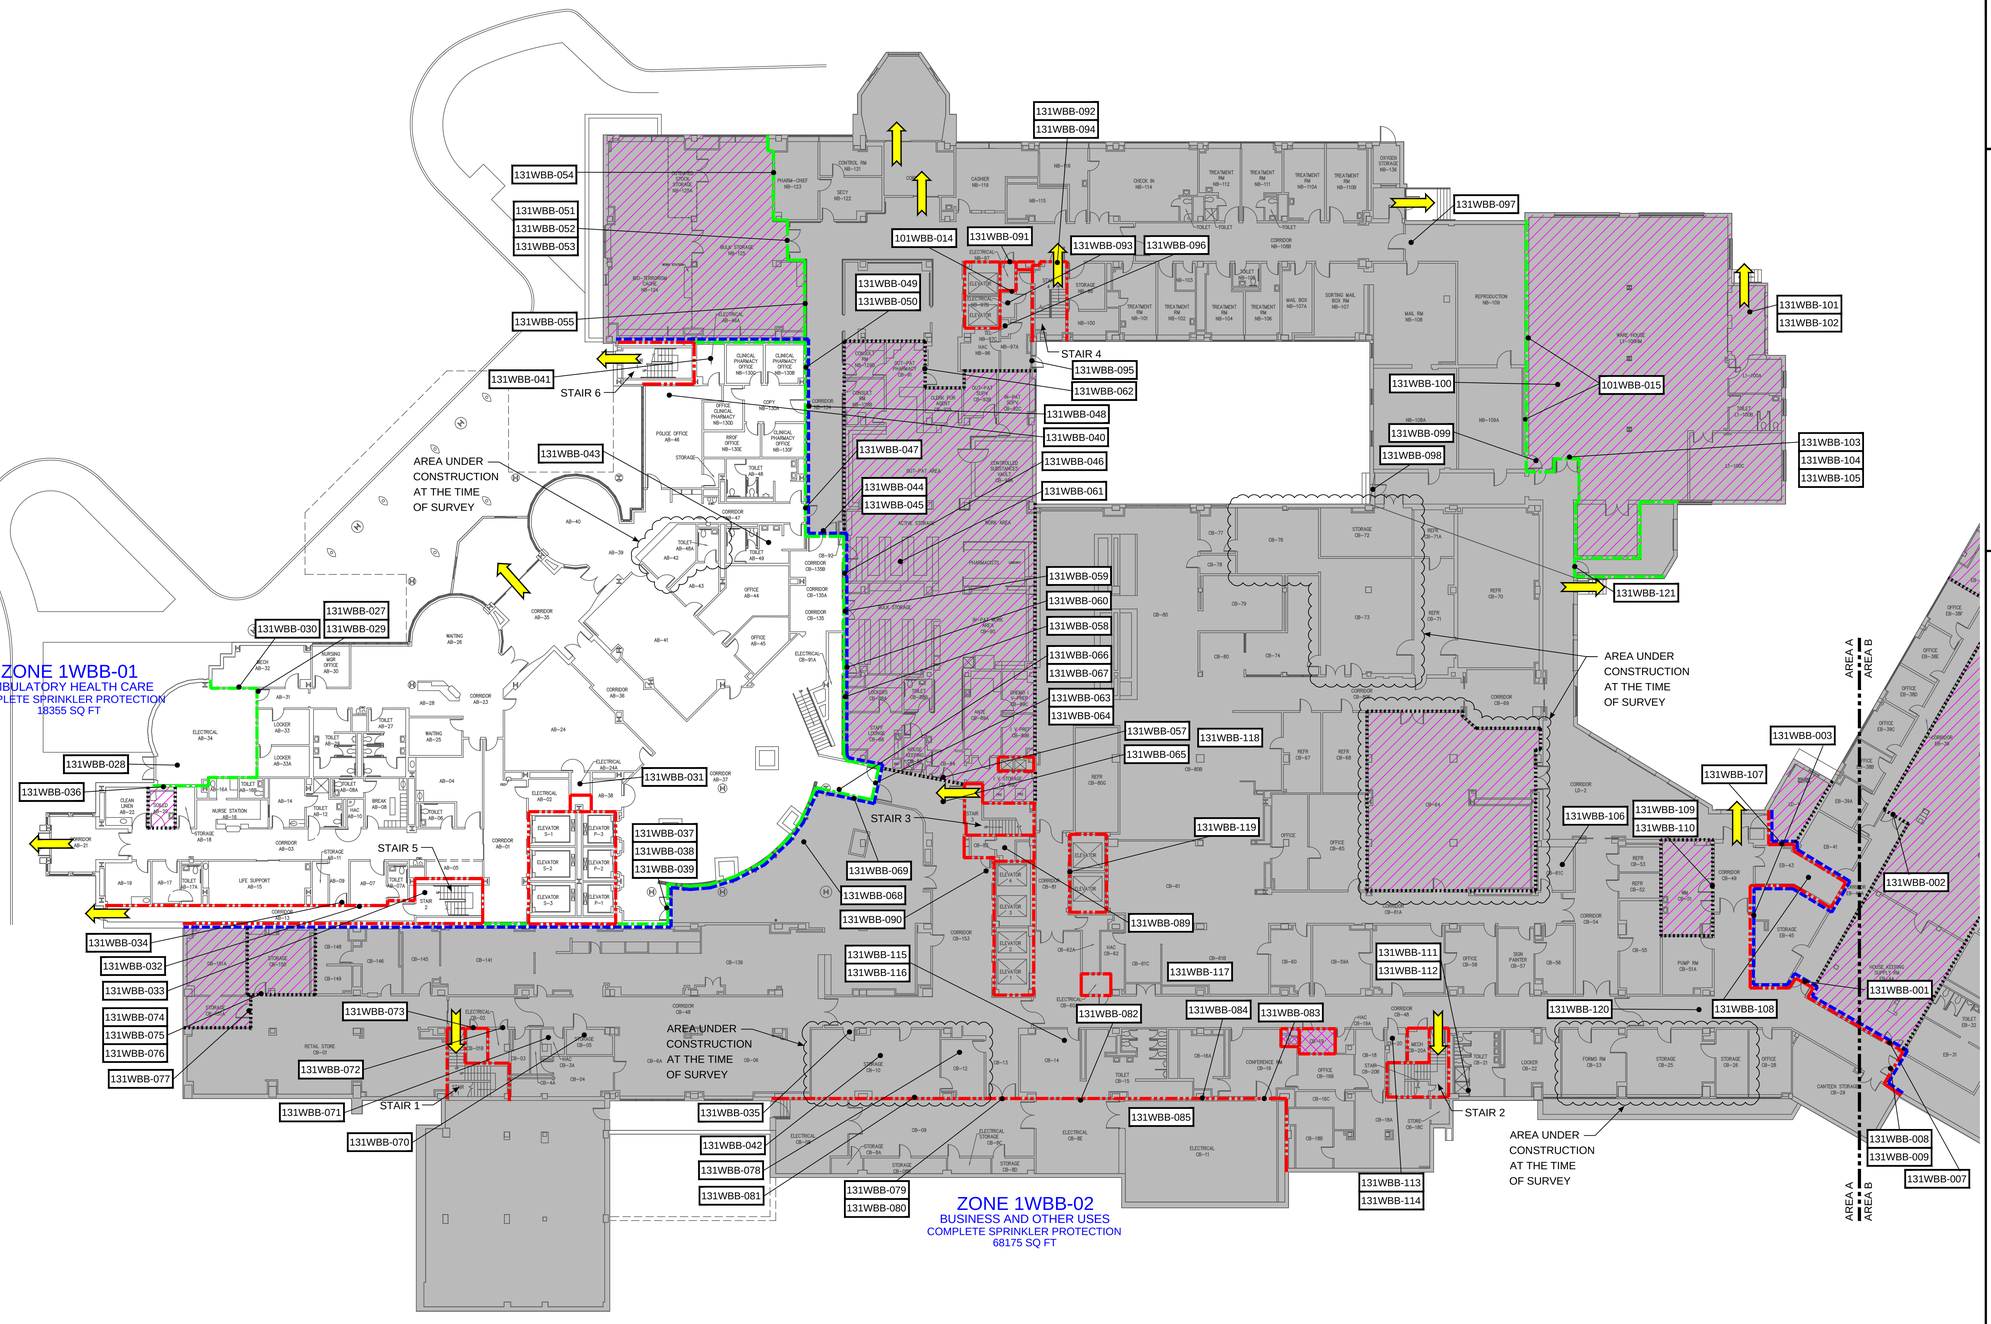

BASEMENT FLOOR - AREA A

SCALE: 1/16" = 1'-0"

KOFFEL ASSOCIATES Fire Protection ENGINEERS®
8815 CENTRE PARK DRIVE, SUITE 200 COLUMBIA, MD 21045
410-750-2246 (BALT) 410-750-2588 (FAX)

LIFE SAFETY SYMBOLS

- BUILDING SEPARATION
- 3 HOUR FIRE BARRIER
- 2 HOUR FIRE BARRIER
- 1 HOUR FIRE BARRIER
- 1/2 HOUR FIRE BARRIER
- SMOKE BARRIER
- SMOKE RESISTIVE CONSTRUCTION
- EXIT
- NOT INCLUDED IN SOC
- CHUTES/ACCESS/DISCHARGE
- HAZARDOUS AREA
- SLEEPING SUITE
- NON-SLEEPING SUITE
- NON-PATIENT SUITE
- 2 HOUR FLOOR/CEILING ABOVE
- 1 HOUR FLOOR/CEILING ABOVE
- XX-XX FINDING NUMBER

REVISIONS

NO	DATE	DESCRIPTION

VA WILKES BARRE HEALTH CARE

1111 East End Boulevard
Wilkes-Barre, PA 18711

PROJECT TITLE

KEY PLAN

J005-05-08	AUG. 30, 2013
KA PROJECT NO	SUBMITTAL DATE
AS NOTED	D. HUGUE
DRAWING SCALE	DESIGNED BY
S. GILYEAT	A. KAHLER
REVIEWED BY	DRAWN BY

LIFE SAFETY PLAN
BUILDINGS 1 & 27
BASEMENT FLOOR
AREA A

SHEET TITLE

LS.1.B.1

DRAWING NUMBER