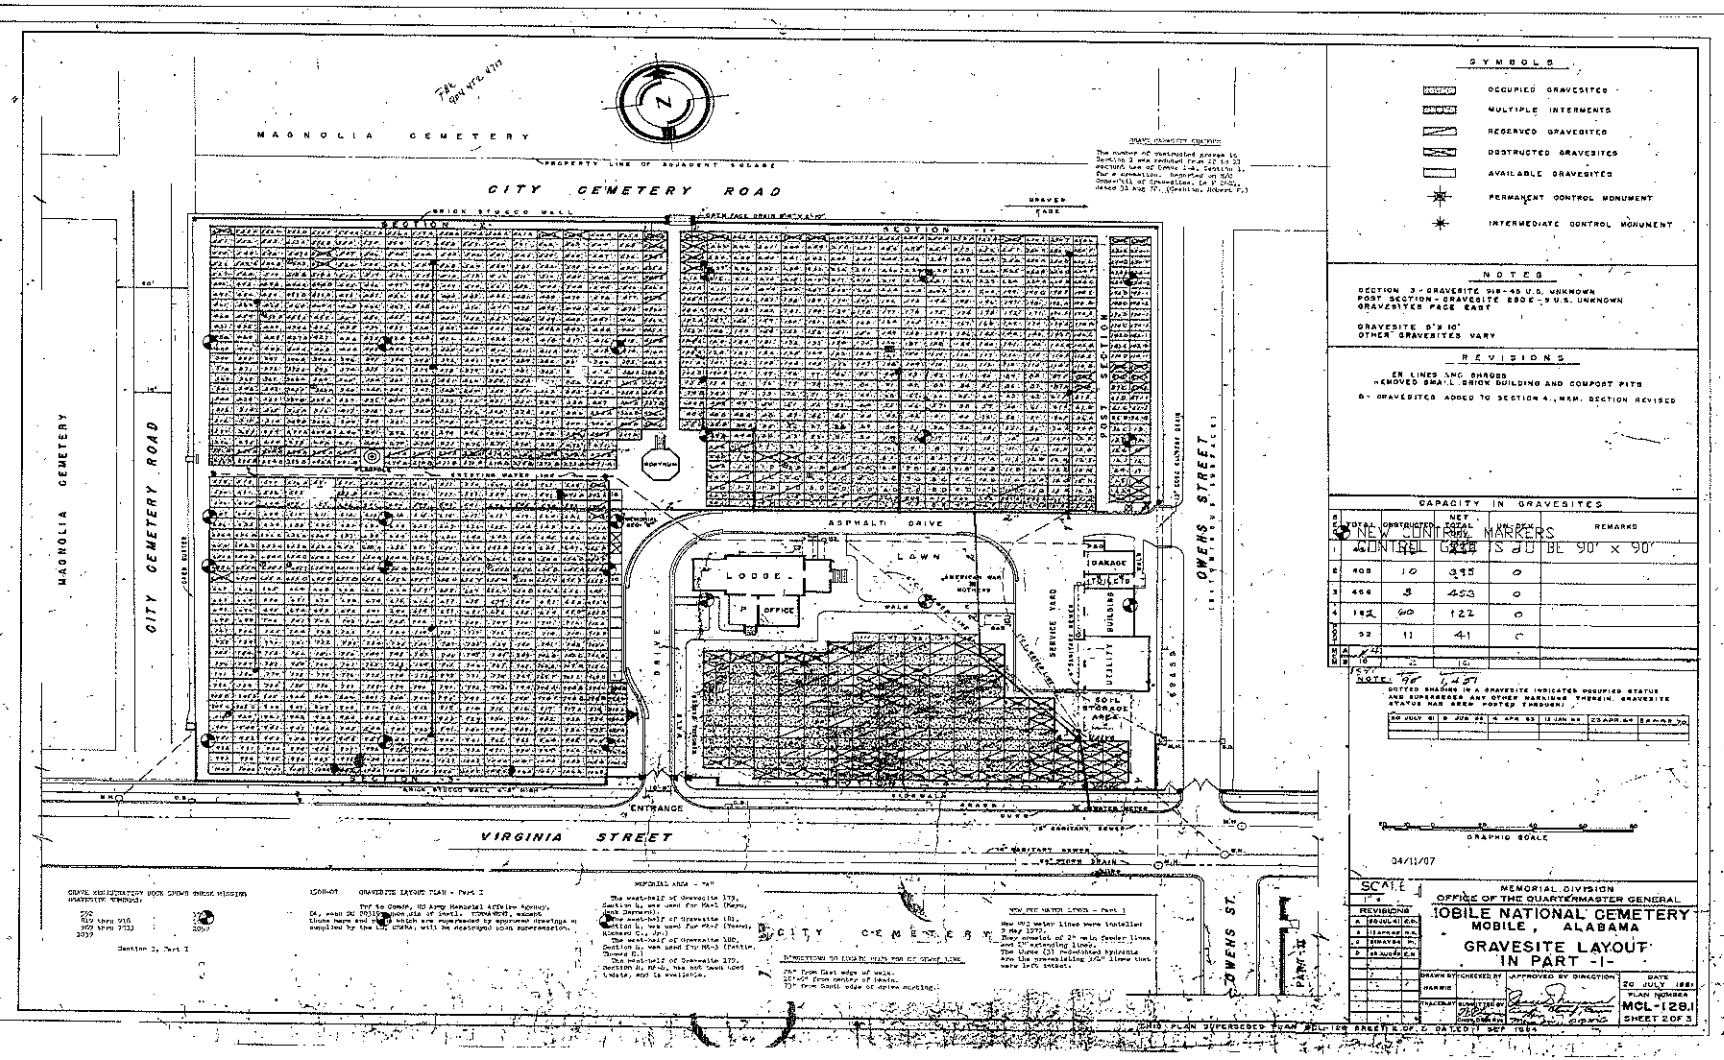
MAGNOLIA CEMETERY
CITY CEMETERY ROAD
PROPERTY LINE OF ADJACENT SQUARE
UNION STUCCO WALL
OPEN FACE DRAIN
SECTION 4
SECTION 1
POST SECTION
OWENS STREET
MAGNOLIA CEMETERY
CITY CEMETERY ROAD
ASPHALT DRIVE
LODGE
OFFICE
LAWN
FLAGPOLE
SERVICE YARD
UTILITY BUILDING
SOIL STORAGE AREA
ENTRANCE
VIRGINIA STREET
OWENS ST.
SYMBOLS
OCCUPIED GRAVESITES
MULTIPLE INTERMENTS
RESERVED GRAVESITES
OBSTRUCTED GRAVESITES
AVAILABLE GRAVESITES
PERMANENT CONTROL MONUMENT
INTERMEDIATE CONTROL MONUMENT
NOTES
SECTION 3 - GRAVESITE 918 - 45 U.S. UNKNOWN
POST SECTION - GRAVESITE 8806 - 9 U.S. UNKNOWN
GRAVESITES FACE EAST
GRAVESITE 8'X 10'
OTHER GRAVESITES VARY
REVISIONS
CAPACITY IN GRAVESITES
NEW CONTROL MARKERS
CONTROL GRAVESITS ARE 90' x 90'
GRAPHIC SCALE
34/11/07
SCALE
MEMORIAL DIVISION
OFFICE OF THE QUARTERMASTER GENERAL
MOBILE NATIONAL CEMETERY
MOBILE, ALABAMA
GRAVESITE LAYOUT
IN PART -I-
DRAWN BY HARRIS
CHECKED BY
APPROVED BY DIRECTION
DATE 20 JULY 1981
PLAN NUMBER MCL-128.1
SHEET 2 OF 3