


1
2
NOTES BY SYMBOL (O)	
NOTE	DESCRIPTION
1	BATTERY CHARGER, 120V, 10, 20A.
2	AUTOMATIC CART WASHER/DRYER UNIT, 460V, 3PH, 21HP. PROVIDE NEMA 3R 60A, NF DISCONNECT SWITCH WITH 3"6, 1"10G. - 1"6.
3	AUTOMATIC CART WASHER/DRYER CONTROL, 120V, 10. PROVIDE WP BOX WITH VAPOR TIGHT FLEXIBLE CONDUIT CONNECTION.

NOTES THIS SHEET	
NOTE	DESCRIPTION
1	REFER TO DRAWING 2-E1 FOR ELECTRICAL LEGEND.
2	REFER TO DRAWING 2-E2 FOR ABBREVIATIONS.
3	REFER TO DRAWING 2-E4 FOR ELECTRICAL RISER KEY PLAN.
4	REFER TO DRAWINGS 2-E245 THRU 2-E250 FOR ELECTRICAL DIAGRAMS.
5	REFER TO SPECIFICATIONS FOR PANEL SCHEDULES.
6	REFER TO DRAWING 2-E141 THROUGH 2-E194 FOR SERVICE ZONE PLANS. ROUTING OF ELECTRICAL WITHIN SERVICE ZONE LEVELS IS RESTRICTED TO SPECIFIC CHANNELS AS SHOWN ON SERVICE ZONE SECTIONS ON DRAWINGS 2-E179 AND 2-E180.
7	BRANCH CIRCUIT CONDUCTORS WITHIN SERVICE ZONE SPACE SHALL BE DERATED.
8	COORDINATE RECEPTACLE INSTALLATION IN CASEWORK WITH OTHER TRADES.
9	REFER TO DRAWING 2-E303 FOR MECHANICAL EQUIPMENT LOAD, DISCONNECT, STARTER AND WIRE AND CONDUIT REQUIREMENTS.
10	INTERCOM REQUIREMENTS ARE PROVIDED VIA TELEPHONE SYSTEM.

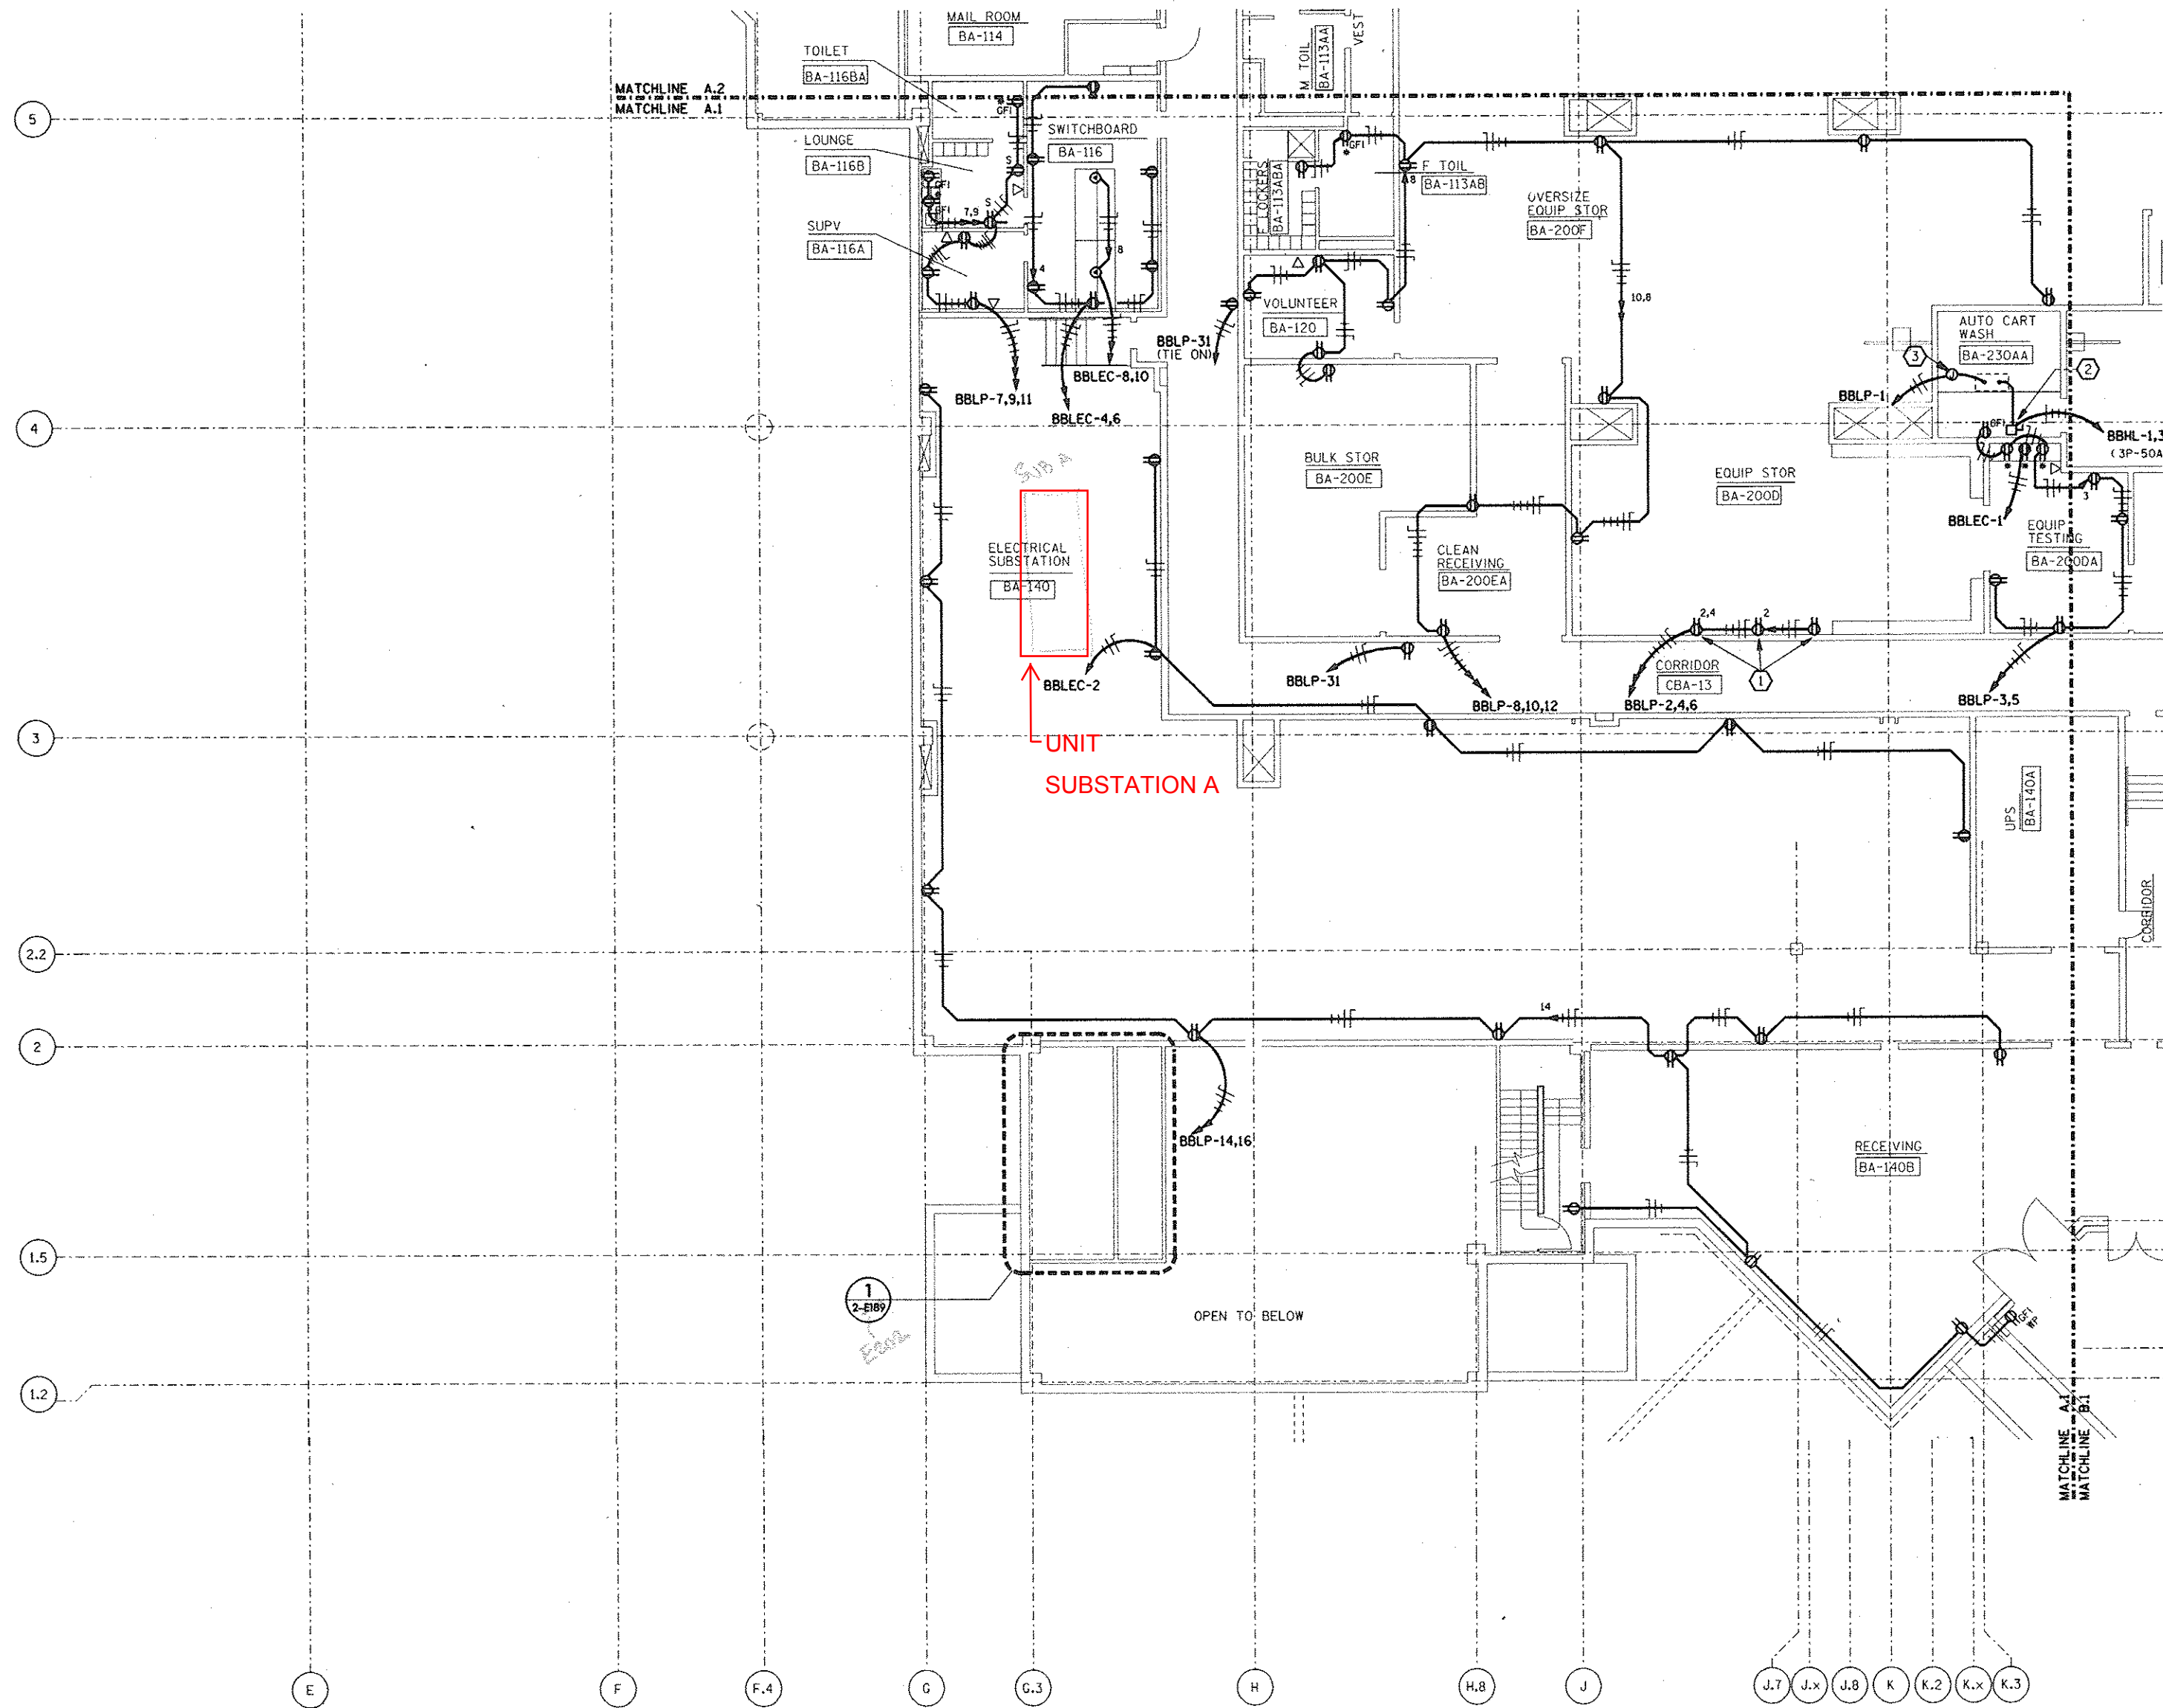

DAHL BRADEN PTM, INC.
F&S PARTNERS INC.
A JOINT VENTURE
1825 MARKET CENTER BLVD.
DALLAS, TEXAS 75207-3332
(214) 748-7337 FAX (214) 748-2284

STRUCTURAL ENGINEER
EDWARD L. WILSON, JR.
CONSULTING ENGINEERS
2909 MAPLE AVENUE
DALLAS, TEXAS 75201
(214) 871-8801

M.E.P. & CIVIL ENGINEERS
YANDELL HILLER & CO., INC.
512 MAIN ST., SUITE 1500
FORT WORTH, TEXAS 76102-3922
(817) 335-3000 FAX (817) 335-1025

Drawing Title
BASEMENT PLAN FUNCTIONAL
AREA A.1 - POWER
ELECTRICAL

Approved: Area Project Manager

Project Title
CLINICAL ADDITION

Building Number
2

Location
VA MEDICAL CENTER, DALLAS, TEXAS

Date
07/20/93
08/PM 239,009
F39917.00

Project No.
549-085

Drawing No.
2-E61
Dwg. 67 of 262E

Revisions
1
2
3
4
5
6
7
8
9
10

VA FORM 08-6231A, JAN 1990