

NOTES:
1) FOR LIST OF AREAS SHOWN AT 1/4"=1'-0"
SCALE SEE DRAWING NO. 100-100
2) PROVIDE CERAMIC TILE PARTIALS AT
LABORATORIES LOCATED ON WALLS
(ROOMS WHERE WALL FINISH IS NOT
CERAMIC TILE).
3) FLOOR PLAN DIMENSIONS ARE TO
FACE OF STUDY COLUMN GRID. COLUMN
GRID IS NOT NECESSARILY THE
OF COLUMN. EXTERIOR DIMENSIONS
ARE 1/2" THICK WALL OF BRICK TO
TO COLUMN GRID.

WALL LEGEND

- 1. EXISTING WALLS AND PARTITIONS.
- 2. NEW CONCRETE MASONRY WITH
WALLS, CONCRETE PARTITIONS, AND
NEW METAL STUDS FOR WALLS.
- 3. NEW METAL STUDS FOR WALLS.
- 4. PLASTER PARTITIONS.
- 5. NEW ONE HOUR FIRE PARTITION...
GYPSON BOARD/PLASTER ON METAL
STUDS TO UNDERSIDE OF STRUCTURE
ABOVE.
- 6. NEW TWO HOUR FIRE PARTITION...
GYPSON BOARD/PLASTER ON METAL
STUDS TO UNDERSIDE OF STRUCTURE
ABOVE.
- 7. EXISTING PARTITION MODIFIED TO
LAMINATE TO BOTH SIDES ONE LAYER
OF FIRE RATED 3/8" GYPSON BOARD OR
PLASTER CARRY TO STRUCTURE ABOVE.
EXISTING FRAMES TO ACCOMMODATE NEW
WALL DEPTH.


NOTES: SEE JWG.140 FOR PARTITION
CONSTRUCTION DETAILS. TYPE OF
PARTITION FINISH IS NOTED ON FINISH
SCHEDULE.
* See note on 1-14 of 15-24-80

REVISIONS		DESCRIPTION	
NO.	DATE	NO.	DESCRIPTION
1		1	FLOOR & REFLECTED CEILING PLAN, 6TH FL., UNIT "F"
1		2	OUT PATIENT CLINIC ADDITION & RESEARCH & EDUCATION ADDITION
1		3	
1		4	
SUITE 305
4515 HARDING ROAD
NASHVILLE, TENNESSEE
37205

ARCHITECT-ENGINEER ASSOCIATES
37205

ONE EIGHT INCH EQUALS ONE FOOT
ONE QUARTER INCH EQUALS ONE FOOT
ONE HALF INCH EQUALS ONE FOOT
ONE INCH EQUALS ONE FOOT
ONE AND ONE HALF INCHES EQUALS ONE FOOT
THREE INCHES EQUALS ONE FOOT

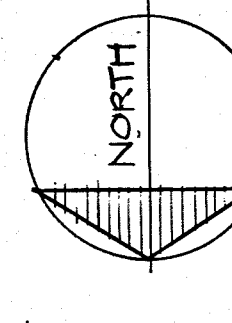

KEY PLAN 6TH FL.

Refer to C-60-G, Revised Detail Ceiling
in light Acoustic Tile

Refer to C-60-G, Revised Detail Ceiling
in light Acoustic Tile

Refer to C-60-G, Revised Detail Ceiling
in light Acoustic Tile

Refer to C-60-G, Revised Detail Ceiling
in light Acoustic Tile

Refer to C-60-G, Revised Detail Ceiling
in light Acoustic Tile

27 Type 1 or 2 doors

U.S. GOVERNMENT PRINTING OFFICE: 1975 O-24-481