



VA MEDICAL CENTER LAKE CITY, FLORIDA

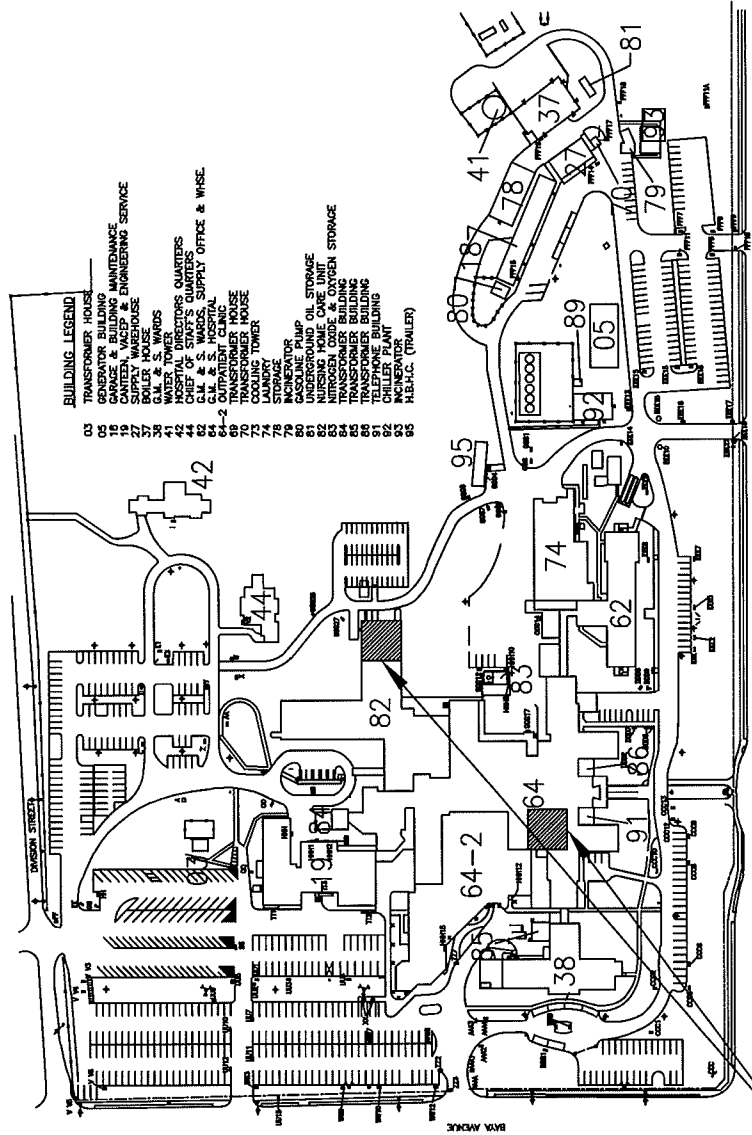

SITE PLAN

| | | | | | | |
|-----------------------------|--------------|---------------------------------|--|-----------------|--|---------------------------------|
| Project No. | 573A4-12-602 | Project No. | | Project Number | | Office of Facilities Management |
| Approved: Division Chief | | REPLACE FIRE PUMPS-PCA D | | Building Number | | |
| Approved: Services Director | | Date | | Checked | | |
| | | Location | | Drawn | | |
| | | VA MEDICAL CENTER LAKE CITY, FL | | Drawing Number | | |

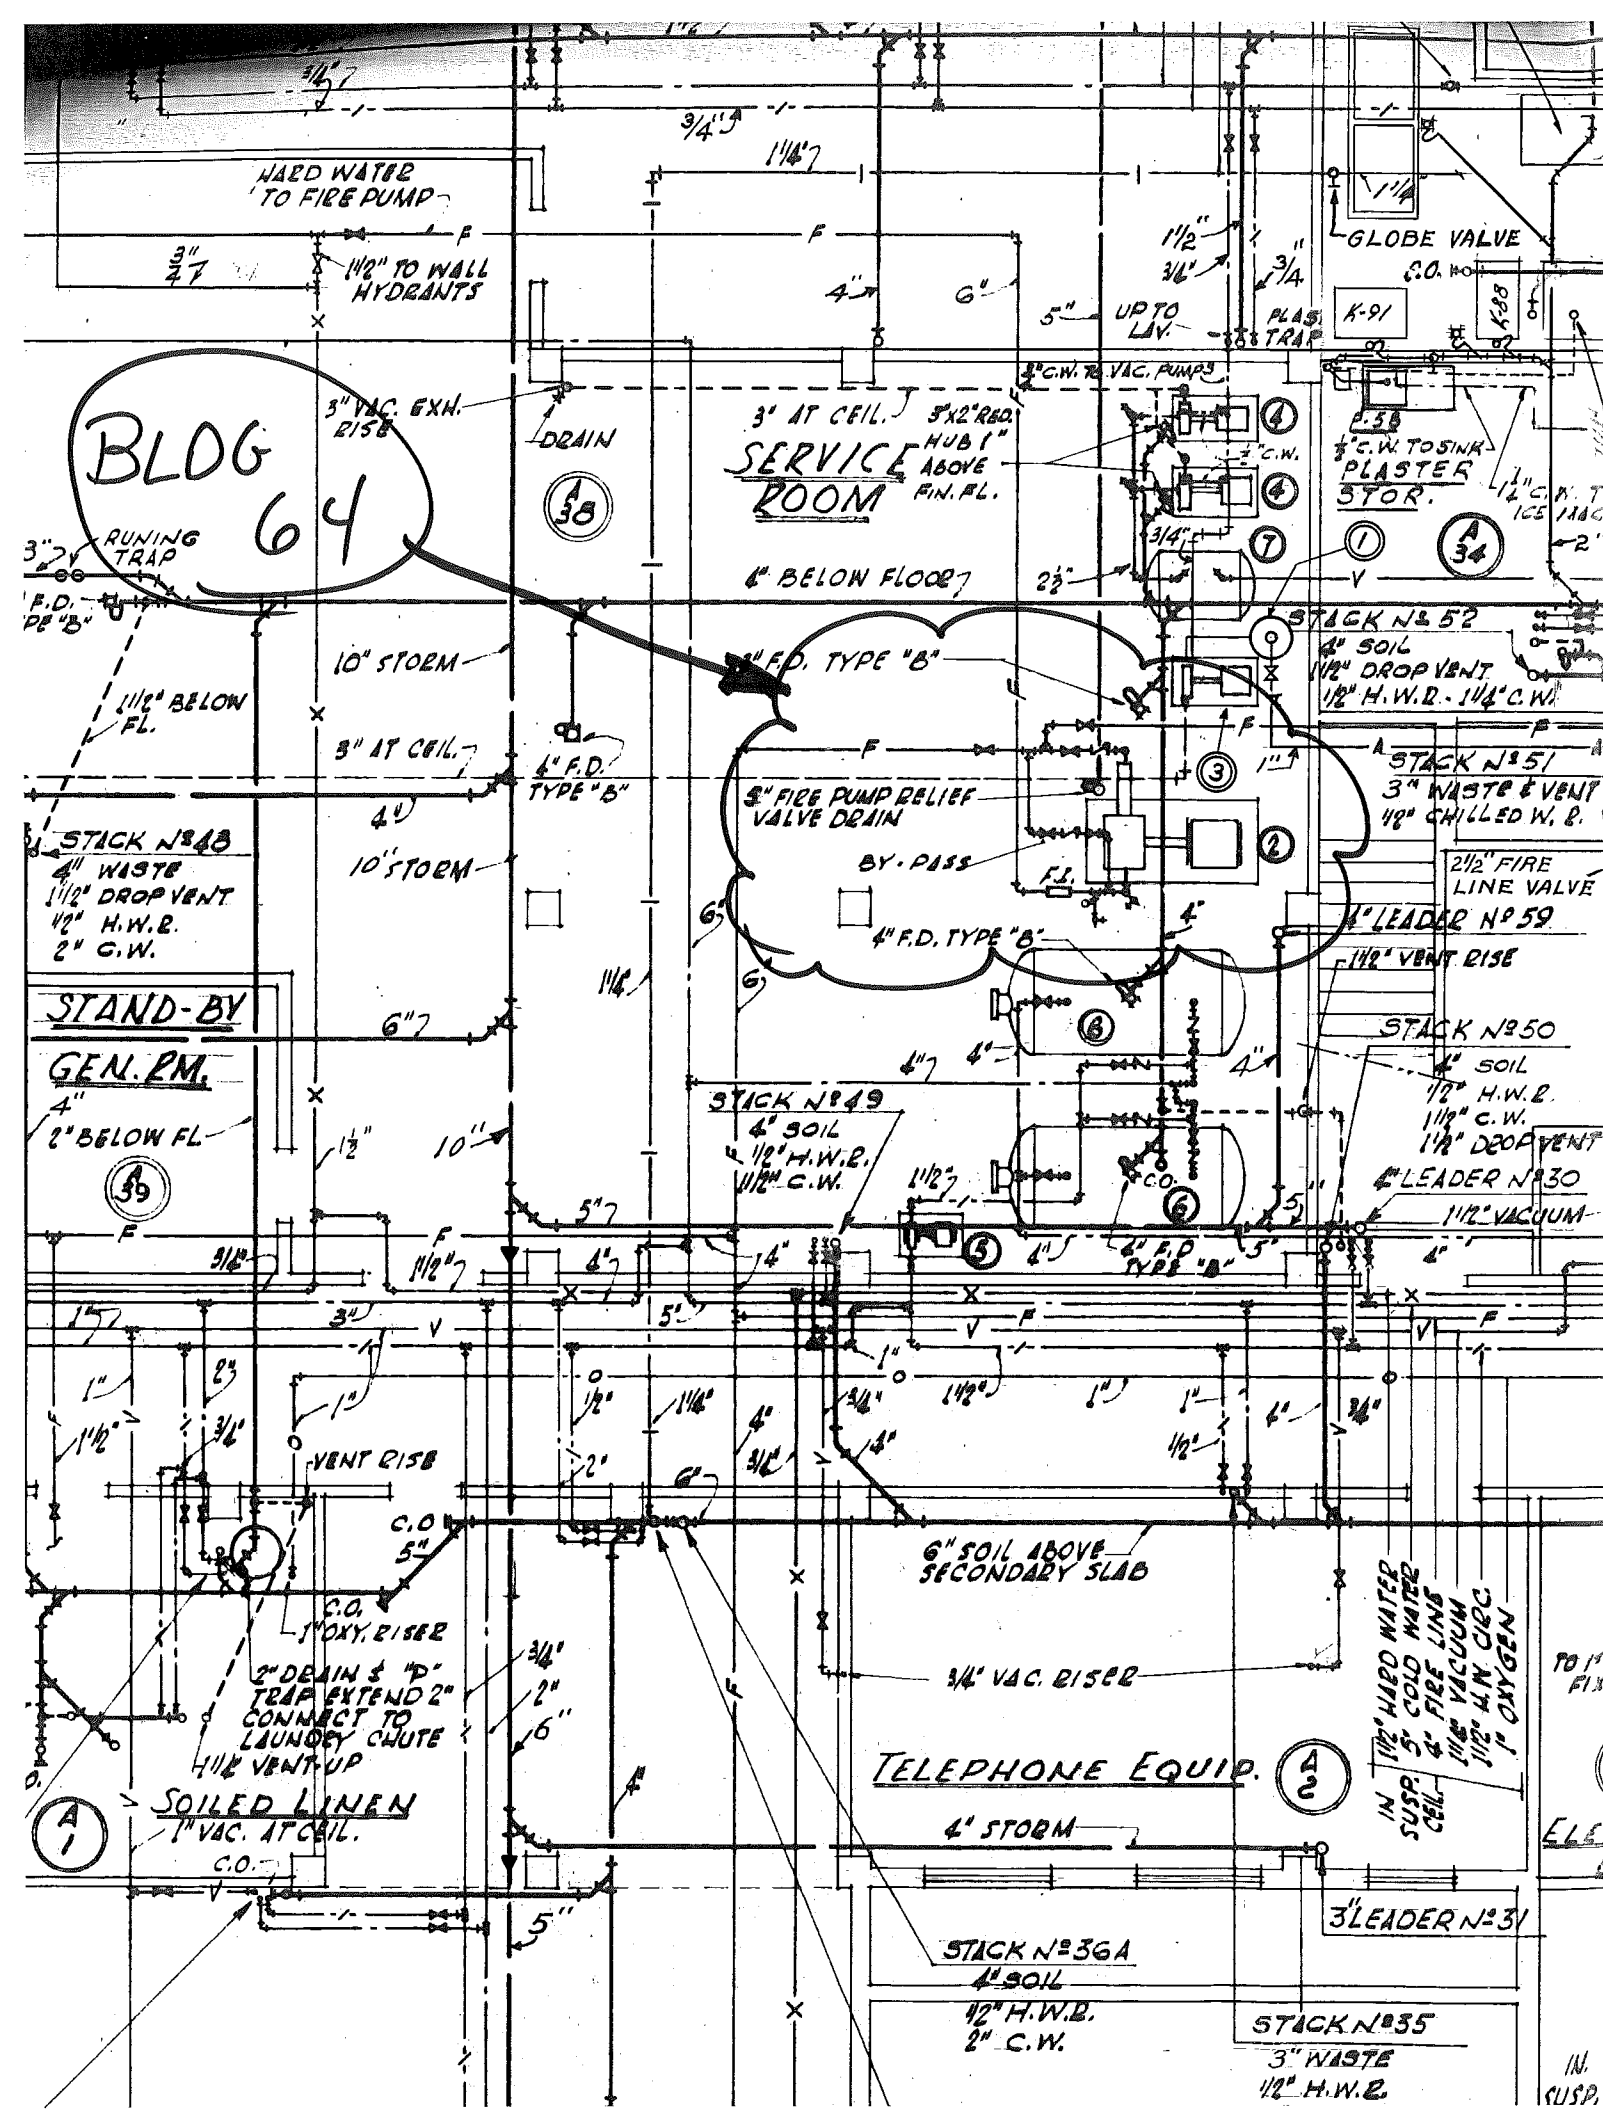

BLDG 82

WATER FLOW TEST DATA


STATIC PRESSURE 55 PSIRESIDUAL PRESSURE 22 PSISYSTEM FLOW 22 PSI AT 722 GPMDRY SYSTEM CAPACITY N/A GALLONS

REMARKS


FLOW TEST TAKEN: APRIL 1991

STAIR #1

PENTHOUSE ROOF (NEW)

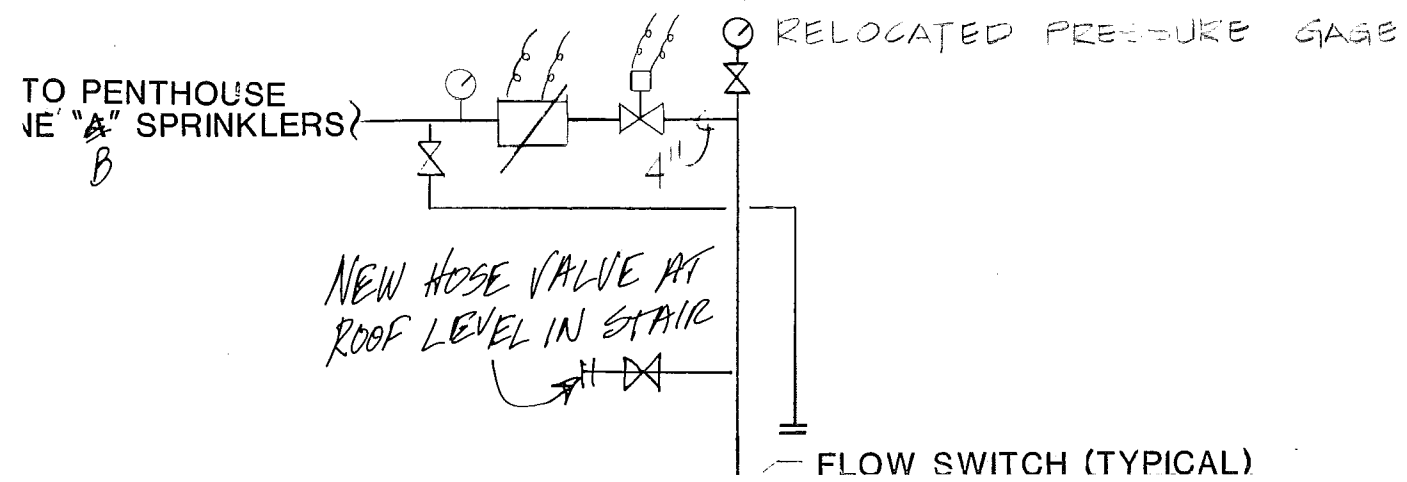

BLOG. 82

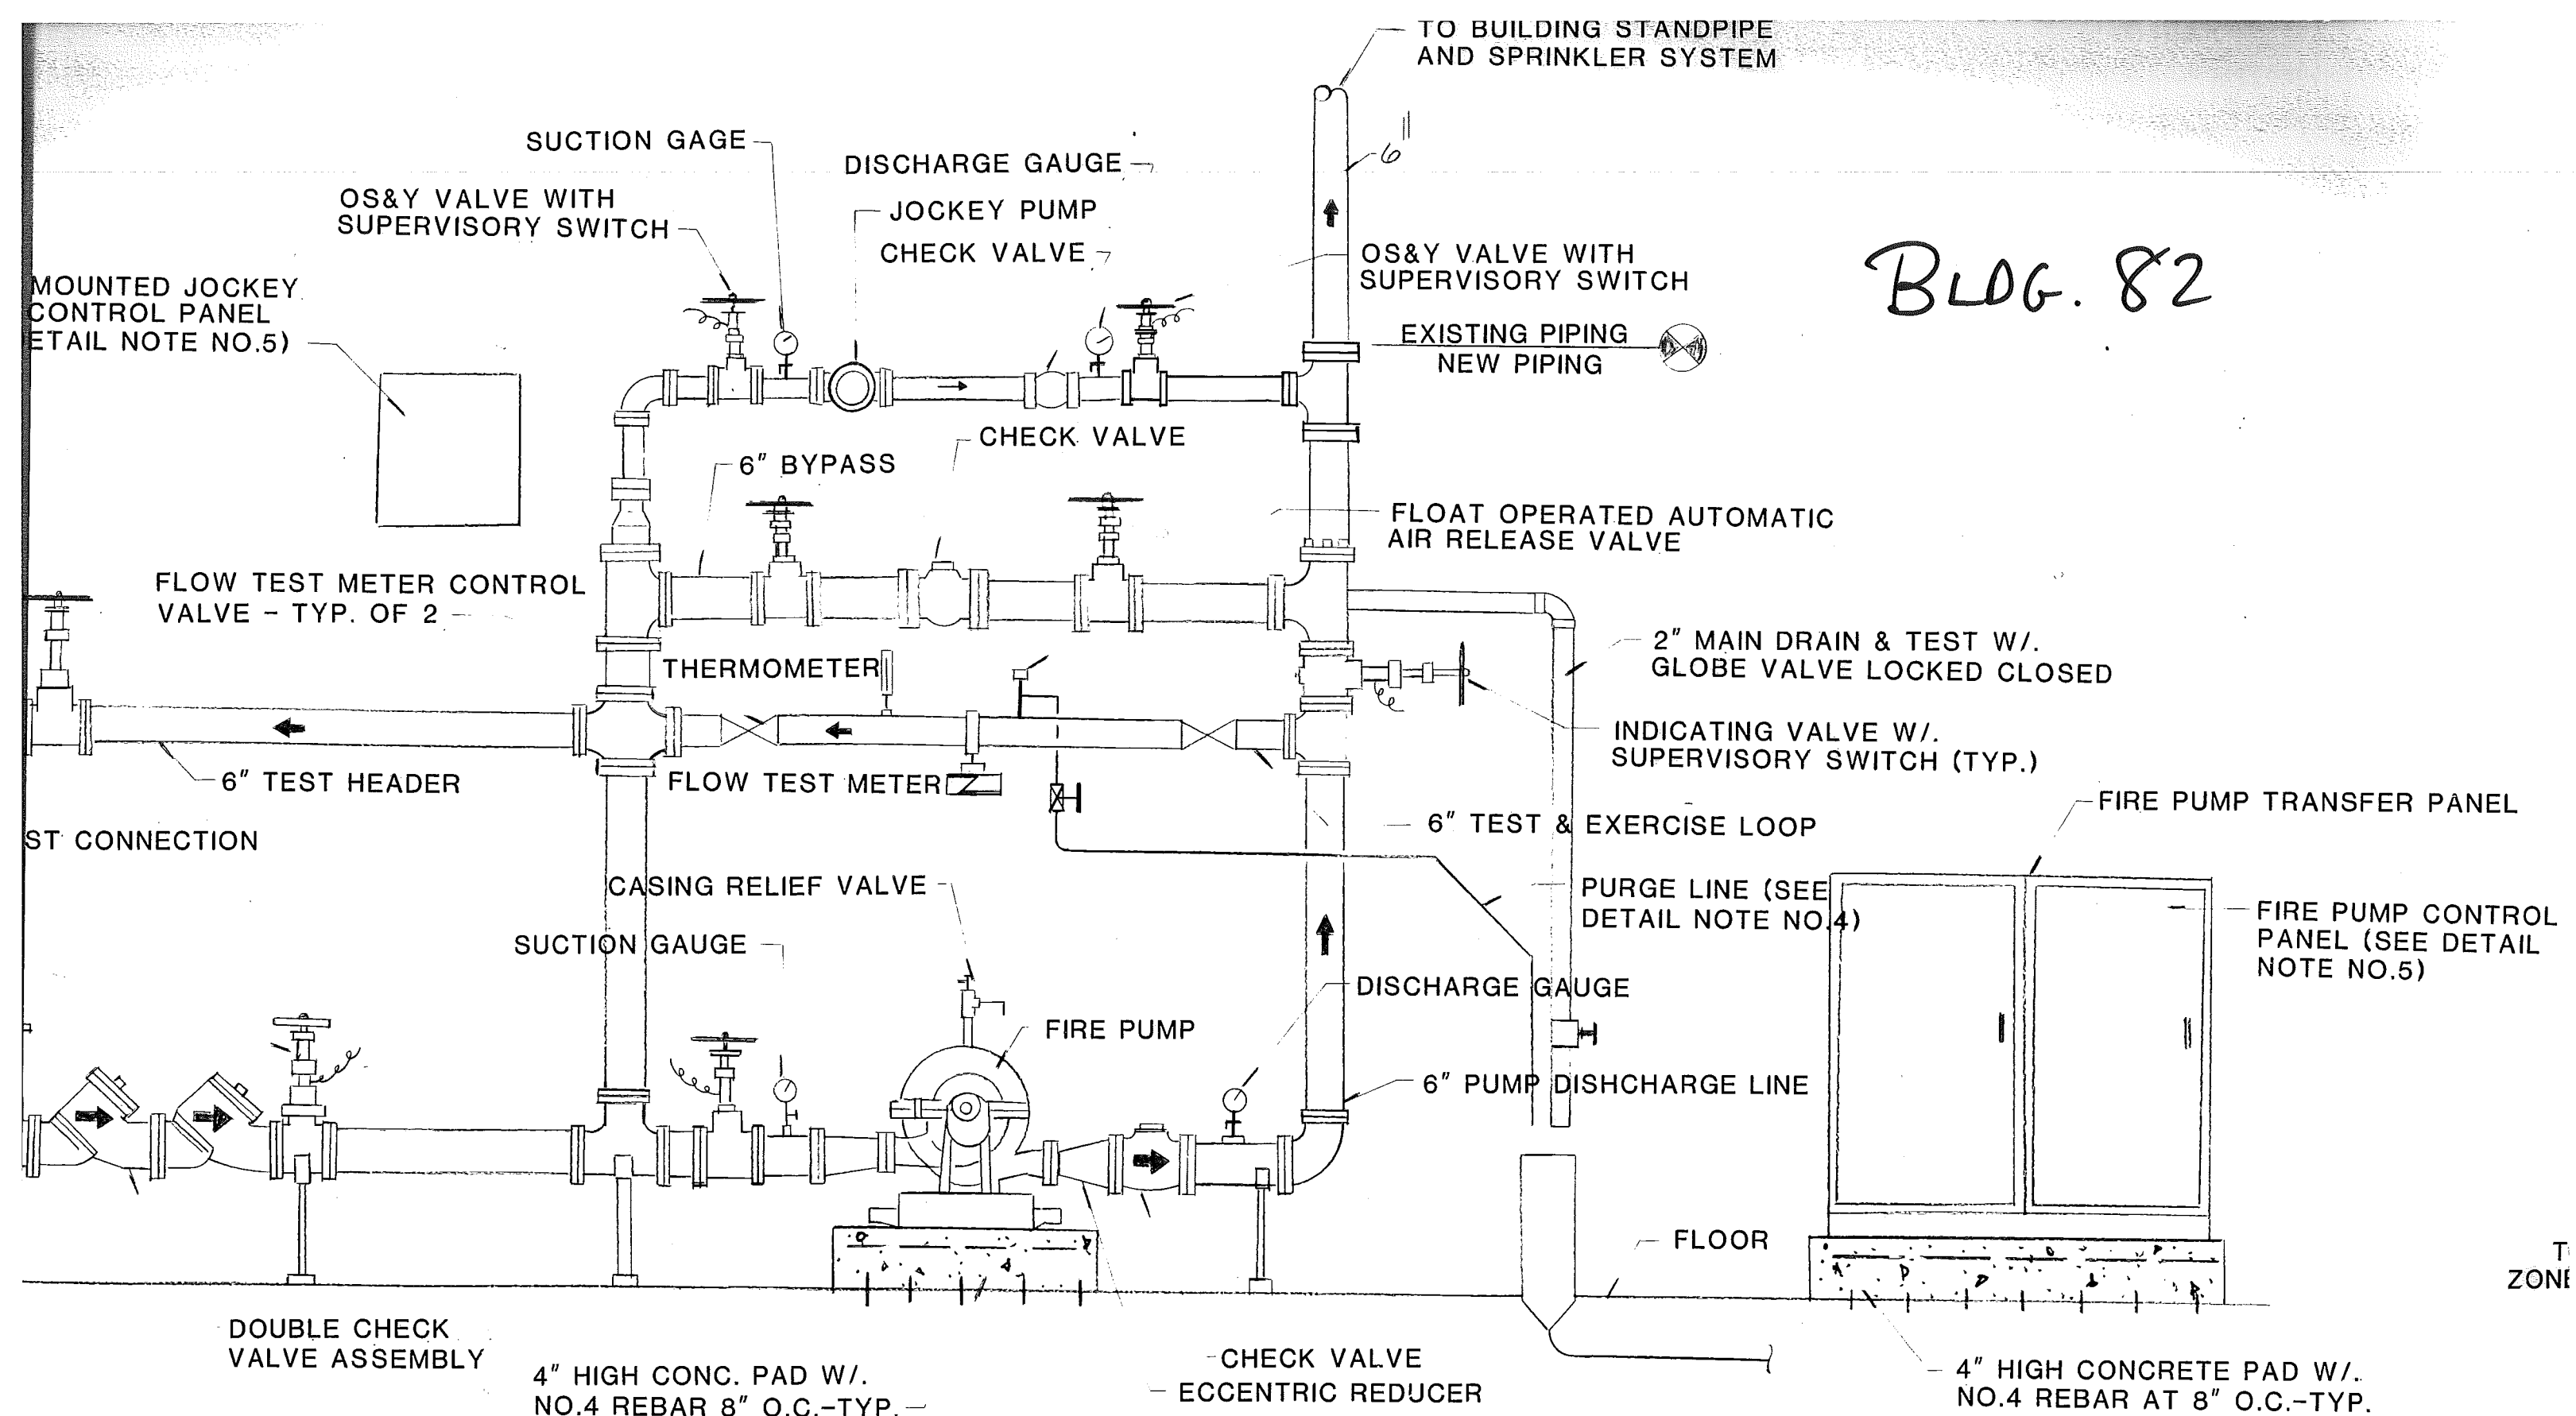

DETAIL NOTES

1. THE FIRE PUMP SHALL BE RATED AT 750 GPM AT 34 PSI HEAD WITH A 25 HP, 1770 RPM 208/3 PHASE MOTOR, SUCTION PRESSURE IS 22 PSI
2. THE JOCKEY PUMP SHALL BE RATED AT 7 1/2 GPM AT 38 PSI HEAD WITH A 3/4 HP, 1750 RPM 208/3 PHASE MOTOR, SUCTION PRESSURE IS 22 PSI
3. VALVES ON THE FIRE & JOCKEY PUMP SUCTIONS SHALL BE OS&Y TYPE WITH SUPERVISORY SWITCHES. THE TWO VALVES IN THE TEST AND EXERCISE LOOP SHALL BE NON UL/FM BALL VALVES RATED AT 200 PSI AND LOCKED CLOSED. ALL OTHER VALVES MAY BE FITTED