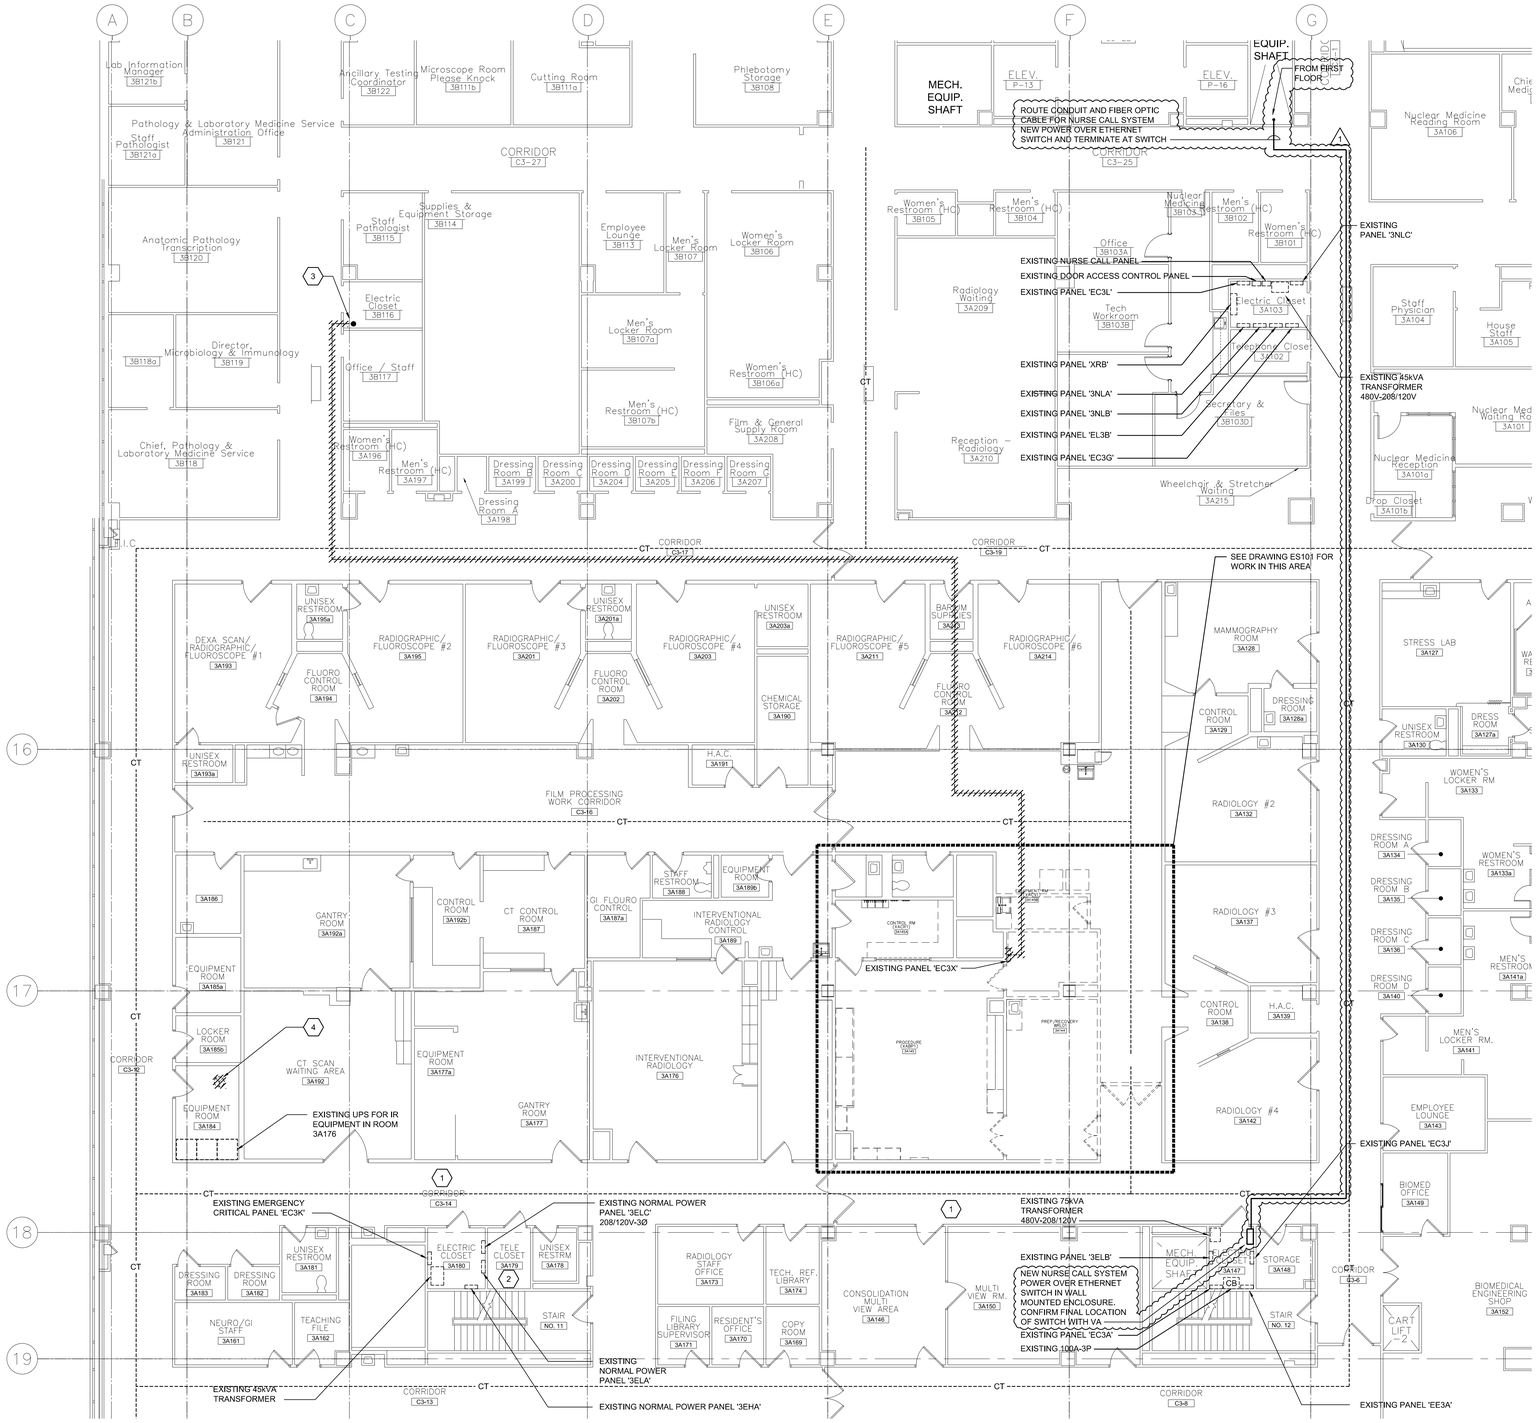

1 PARTIAL ELECTRICAL THIRD FLOOR PLAN

Scale: 1/8" = 1'-0"

0 4' 8' 16'

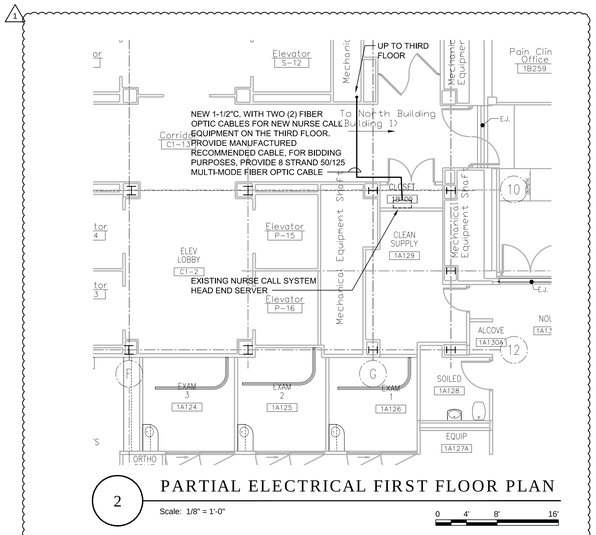

2 PARTIAL ELECTRICAL FIRST FLOOR PLAN

Scale: 1/8" = 1'-0"

0 4' 8' 16'

KEYNOTES THIS DRAWING:

1. WITHIN THIS CORRIDOR, DUE TO DEMOLITION OF EXISTING CIRCUITS AND NEW CIRCUITS TO BE PROVIDED, EC SHALL COORDINATE WITH GC ON REMOVAL OF EXISTING CEILING TO PROVIDE ACCESS ABOVE CEILING.
2. NEW CABLING FOR DATA OUTLETS SHALL BE PROVIDED FROM USER JACKS TO THIS CLOSET. SEE DETAIL SHEET ES501 FOR ADDITIONAL INFORMATION
3. EXISTING IR EQUIPMENT FEEDER FROM BELOW, HORIZONTAL PORTION OF FEEDER SHALL BE DEMOLISHED AS SHOWN. VERTICAL PORTION SHALL REMAIN, ABANDONED IN PLACE.
4. EC SHALL DISCONNECT AND REMOVE, BACK TO SOURCE, EXISTING BRANCH CIRCUIT SERVING MECHANICAL UNIT FOR ROOM. COORDINATE REMOVAL WITH MECHANICAL CONTRACTOR

Revisions	Date
1 ADDENDUM #1	5/7/14

CONSULTANTS

MEP ENGINEERING
H.F. LENZ CO.
1407 Scalp Avenue | Johnstown, PA 15904 | 814.269.9300

ENVIRONMENTAL ENGINEER
LAWHON and ASSOCIATES, INC.
975 Eastwind Drive | Suite 190 | Westerville, Ohio 43081 | 614.818.5200

ENGINEER

PRIME CONTRACTOR
The Trident GROUP
985 Schrock Road | Suite 100 | Columbus, Ohio 43229 | 614.985.1191 | 614.985.1194

Drawing Title: THIRD FLOOR ELECTRICAL PLAN DEMOLITION
Approved:
Project Title: Interventional Radiology Upgrades
Location: Philadelphia, Pennsylvania
Date: Dec. 13, 2013
Checked By: TME
Drawn By: RJD
Project Number: 642-13-130
Building Number: 2
Drawing Number: ES102
Dwg. 37 of 48

Office of Construction and Facilities Management
Department of Veterans Affairs

VA FORM 08-6231