


[illegible][illegible][illegible]

4 DETAIL - OVERHEAD UTILITY CANOPY E

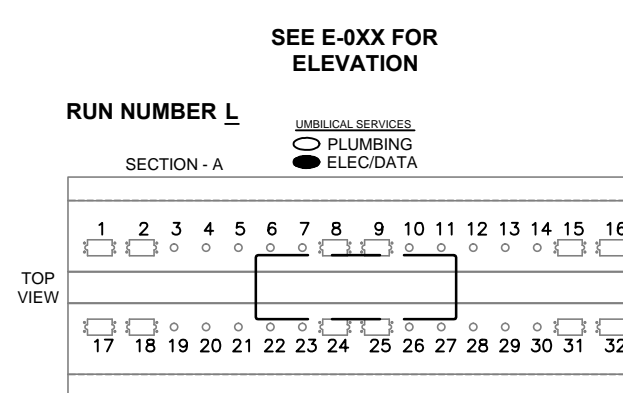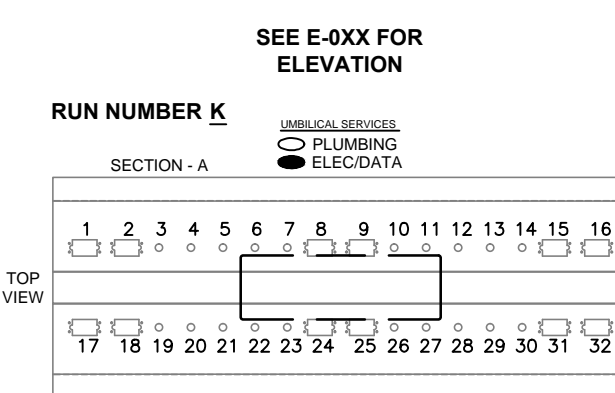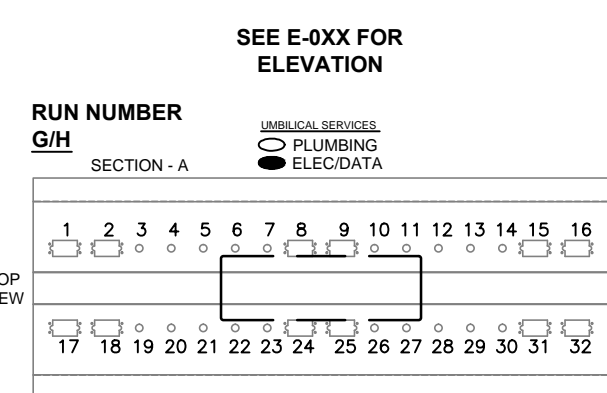

6' SECTION			
ALL UNUSED LOCATIONS MUST HAVE BLANK COVER OR CAP			
NO.	DESCRIPTION	NO.	DESCRIPTION

CENTER SELECTION
SELECT ONE OF THE FOLLOWINGS

☐ BLANK CENTER

☒ DOWN LIGHTING





6" SECTION			
ALL UNLISTED LOCATIONS WILL HAVE BLANK COVER OR CAP			
NO	DESCRIPTION	NO	DESCRIPTION
1	BLANK COVER	17	DOWN LIGHTING








6" SECTION		
ALL UNRAISED LOCATIONS WILL HAVE A BLANK COVER OR CAP		
NO	DESCRIPTION	NO DESCRIPTION

CENTER SELECTION
SELECT ONE OF THE FOLLOWING

☐ BLANK CENTER


☐ DOWN LIGHTING

☐ SNOWFLAKE

☐ BULLETS/EYE ☐ CENTERED ☐ RIGHT-BIASED

6 SECTION			

6 DETAIL - OVERHEAD UTILITY CANOPY L

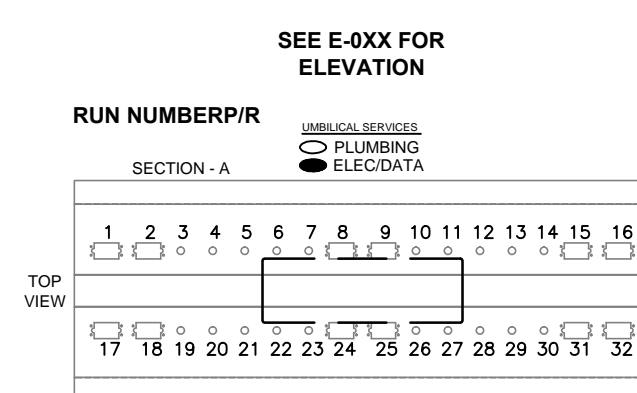

6' SECTION			
ALL UNSEED LOCATIONS MUST HAVE BLANK COVER OR CAP			
NO	DESCRIPTION	NO	DESCRIPTION

CENTER SELECTION
SELECT ONE OF THE FOLLOWING


☐ BLANK CENTER

☒ DOWN LIGHTING

☐ SNORKEL


☐ LEFT LIGHTING ☐ RIGHT LIGHTING

11 DETAIL - OVERHEAD UTILITY CANOPY P/R
NTS

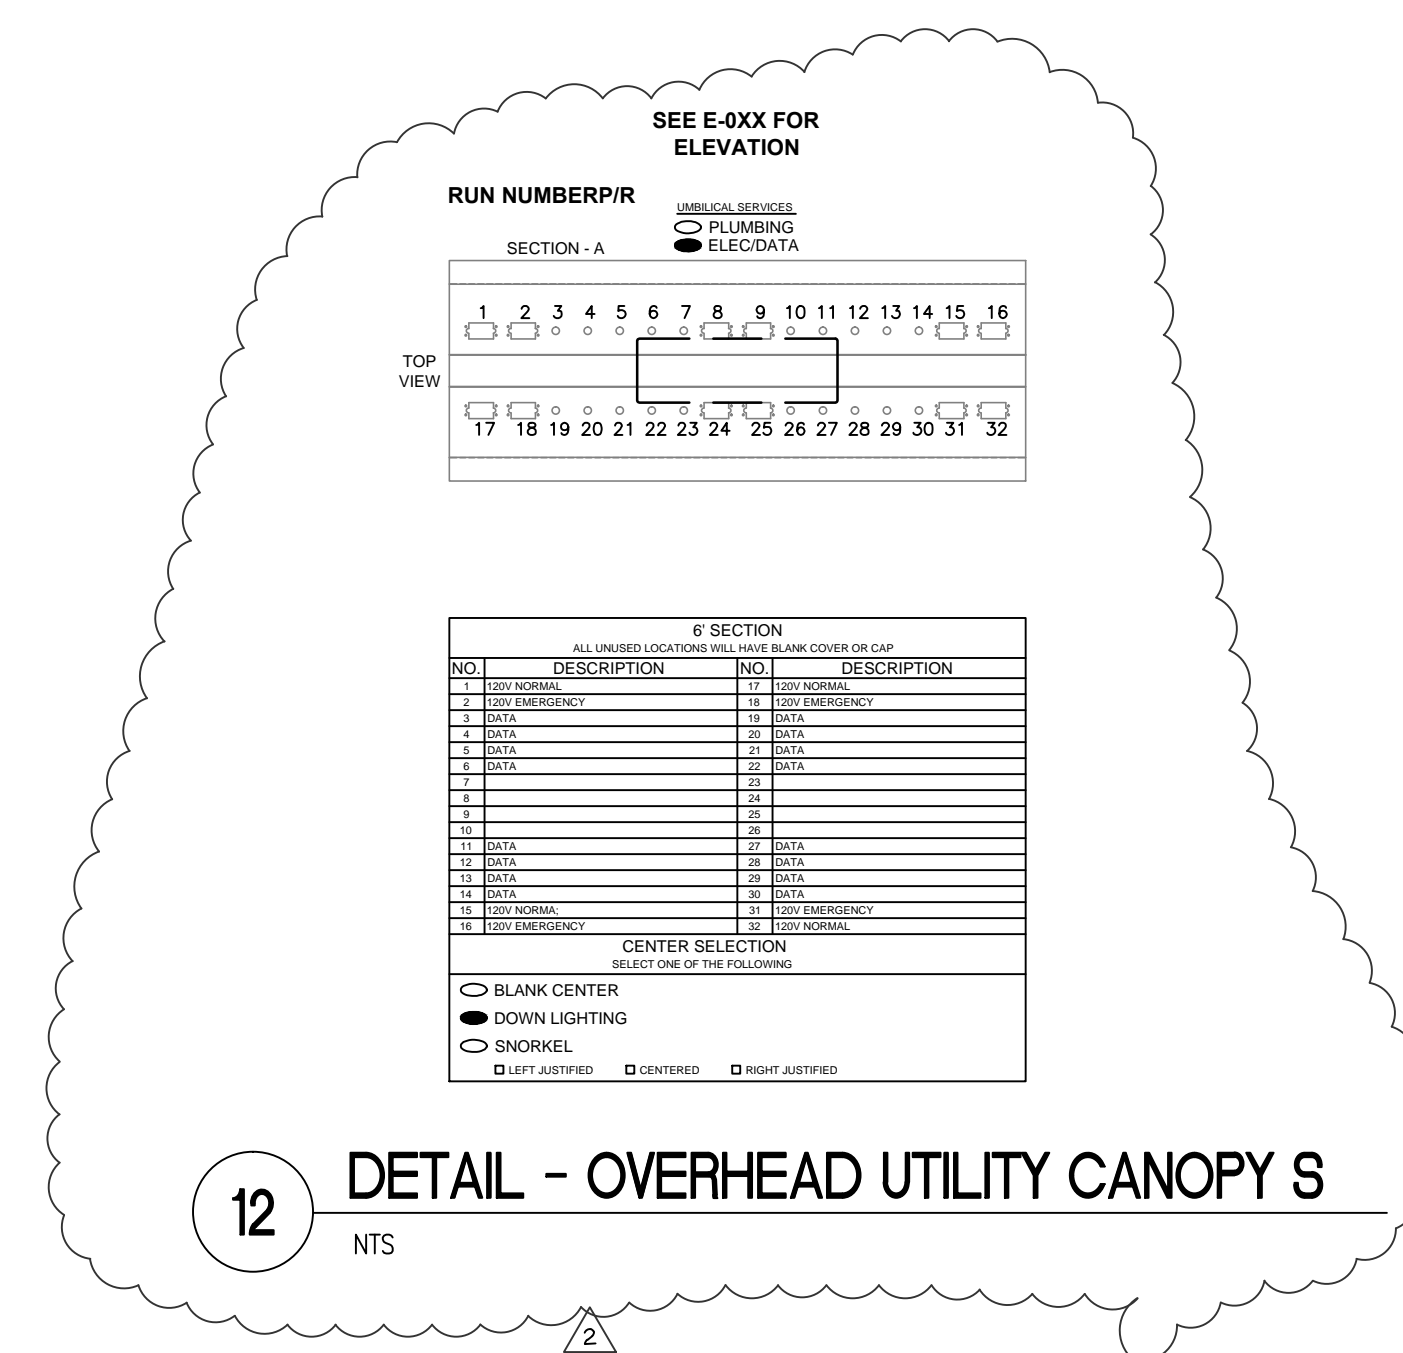

12 DETAIL - OVERHEAD UTILITY CANOPY S
NTS

CONSULTANTS:




**Engineering and
Land Surveying, P.C.**

1533 Crescent Road - Clifton Park, NY 12065



Drawing Title
ELECTRICAL NEW WORK 3B
DETAILS
Approved Project Director
-
-
-

Project Title STRATTON VAMC 3RD FLOOR B WING AND CORE CONSOLIDATE LABS RENOVATION			Project Number 528AB-10-801		<div>Office of Construction and Facilities Management</div>
			Building Number BLDG. 1		
Location STRATTON VA MEDICAL CENTER NY			Drawing Number ES-502		
Date 04/03/2014	Checked SMP	Drawn SMP	<div>Dwg. 48 of 54</div>		



Department of
Veterans Affairs