

0 6 12 18
one-eighth inch = one foot

0 4 8
one-quarter inch = one foot

0 4 8
three-eighths inch = one foot


0 4 8
one-half inch = one foot

0 2 4 6 8
three-quarters inch = one foot


0 2 4 6 8
one inch = one foot

0 6 12 18
one and one-half inches = one foot

0 6 12 18
three inches = one foot

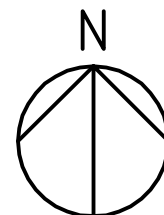

FIRST FLOOR PLAN
1/8" = 1'-0"

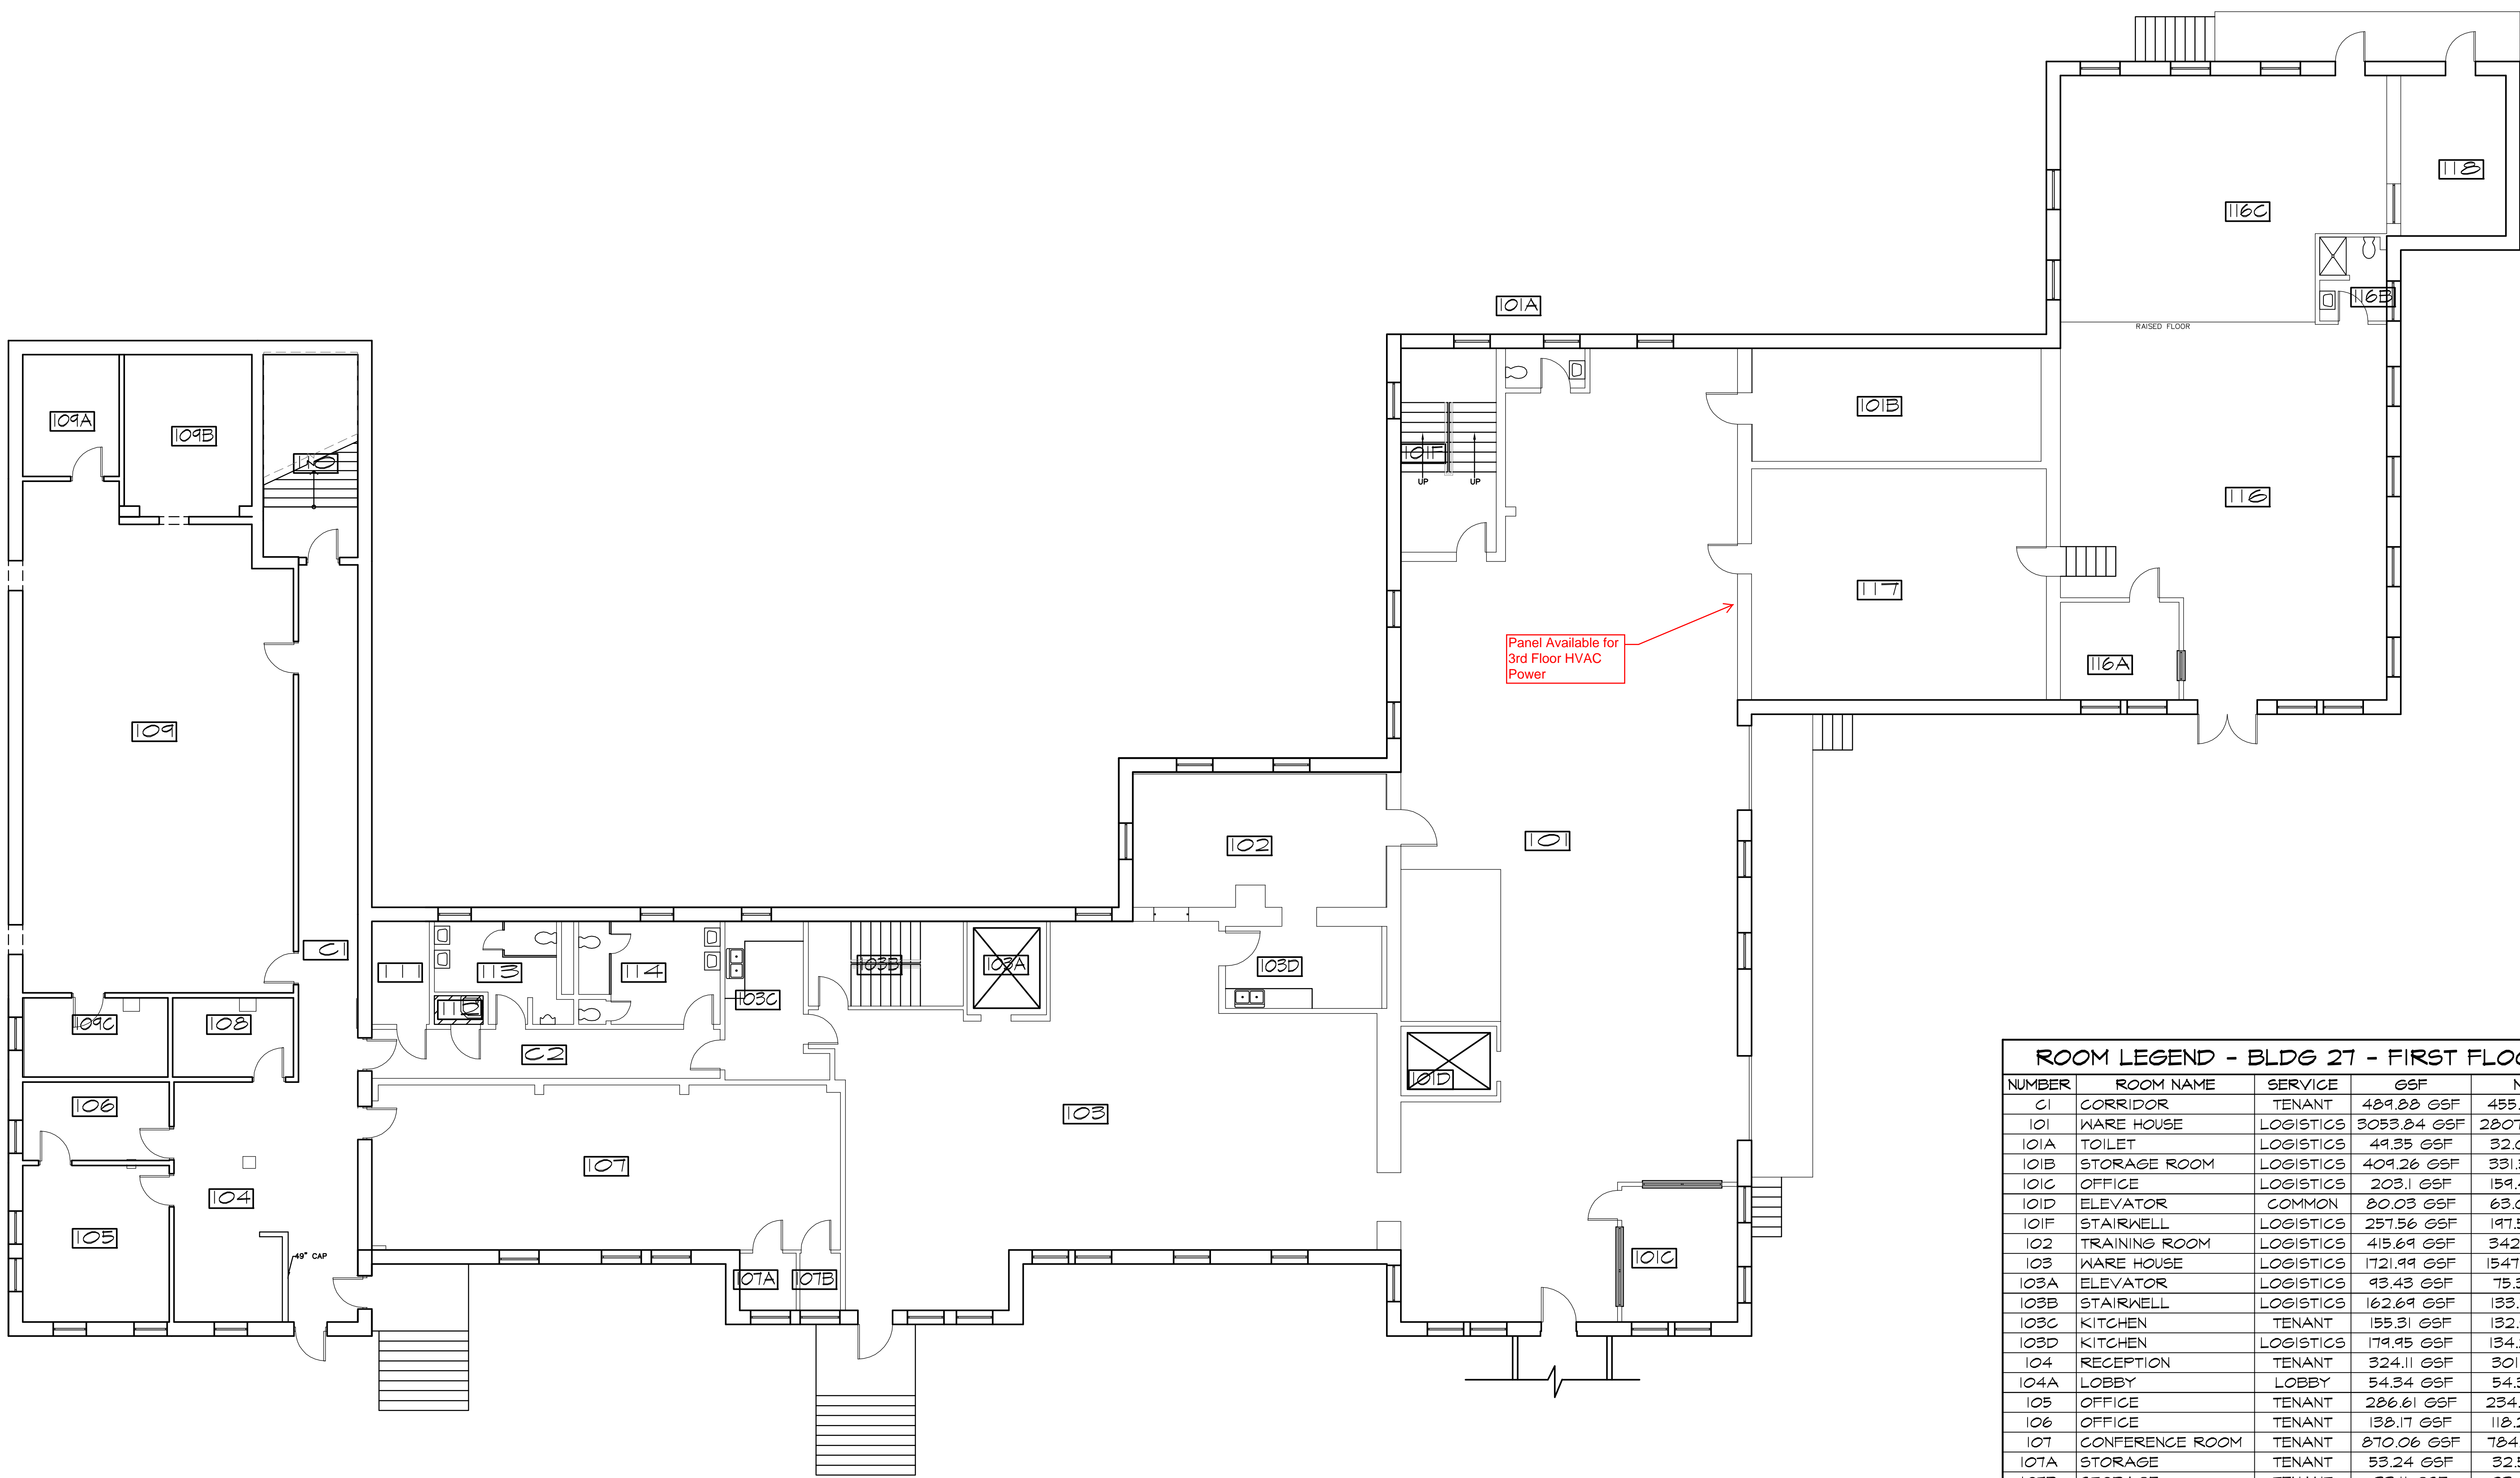

ROOM LEGEND - BLDG 27 - FIRST FLOOR				
NUMBER	ROOM NAME	SERVICE	GSF	NSF
C1	CORRIDOR	TENANT	489.88 GSF	455.85 SF
101	WARE HOUSE	LOGISTICS	3053.84 GSF	2807.80 SF
101A	TOILET	LOGISTICS	49.35 GSF	32.00 SF
101B	STORAGE ROOM	LOGISTICS	409.26 GSF	331.30 SF
101C	OFFICE	LOGISTICS	203.1 GSF	159.44 SF
101D	ELEVATOR	COMMON	80.03 GSF	63.00 SF
101F	STAIRWELL	LOGISTICS	257.56 GSF	197.50 SF
102	TRAINING ROOM	LOGISTICS	415.69 GSF	342.81 SF
103	WARE HOUSE	LOGISTICS	1721.99 GSF	1547.27 SF
103A	ELEVATOR	LOGISTICS	93.43 GSF	75.33 SF
103B	STAIRWELL	LOGISTICS	162.69 GSF	133.37 SF
103C	KITCHEN	TENANT	155.31 GSF	132.95 SF
103D	KITCHEN	LOGISTICS	179.95 GSF	134.23 SF
104	RECEPTION	TENANT	324.11 GSF	301.13 SF
104A	LOBBY	LOGISTICS	54.34 GSF	54.34 SF
105	OFFICE	TENANT	286.61 GSF	234.20 SF
106	OFFICE	TENANT	138.17 GSF	118.22 SF
107	CONFERENCE ROOM	TENANT	870.06 GSF	784.35 SF
107A	STORAGE	TENANT	53.24 GSF	32.52 SF
107B	STORAGE	TENANT	33.11 GSF	23.44 SF
108	OFFICE	TENANT	106.88 GSF	95.51 SF
109	OPEN WORK SPACE	TENANT	1415.63 GSF	1310.37 SF
109A	OFFICE	TENANT	158.3 GSF	118.93 SF
109B	STORAGE ROOM	TENANT	248.18 GSF	206.74 SF
109C	OFFICE	TENANT	137.48 GSF	114.92 SF
110	STAIR	COMMON	254.69 GSF	192.84 SF
111	MECH ROOM	COMMON	82.21 GSF	59.98 SF
112	HAC	EMS	18.07 GSF	14.63 SF
113	MALE TOILET	COMMON	148.15 GSF	114.23 SF
114	FEMALE TOILET	COMMON	155.92 GSF	147.63 SF
116	FURNITURE STORAGE	ENG	1231.64 GSF	1115.04 SF
116A	FURNITURE STORAGE	ENG	147.94 GSF	117.63 SF
116B	TOILET/ SHOWER	ENG	72.71 GSF	56.95 SF
116C	FURNITURE STORAGE	ENG	852.48 GSF	918.01 SF
117	SUPPLY	LOGISTICS	779.67 GSF	690.99 SF
118	MECHANICAL ROOM	COMMON	241.46 GSF	171.10 SF
C2	CORRIDOR	COMMON	199.26 GSF	173.82 SF
			15312.4 GSF	13580.36 SF

Revisions	Date



****FOR REFERENCE ONLY - NOT FOR CONSTRUCTION****

Drawing Title First Floor Plan		Project Title Building 27		Date 05-2013
Location HAMPTON, VIRGINIA		Printed: March 13, 2014		Project No. 027
Building No. 27	Checked by ###	Drawn by ###	027_A101	
		SHEET		OF

