



one eighth inch = one foot  
one quarter inch = one foot  
three eighths inch = one foot  
one half inch = one foot  
three quarters inch = one foot  
one inch = one foot  
one and one half inches = one foot  
two inches = one foot  
three inches = one foot

S:\Engineering\PROJECTS\PROJ-PLAN\PROJECTS - NRM\2014 NRM Projects\640-14-10SP-BSD\_Correx\_Relocation\Addendum #1\Architectural CAD\640-14-10SP - Building 50\_AS103\_Area 2 - Dimension Plan.dwg 5-08-14 06:57:43 AM vhpapvlgis

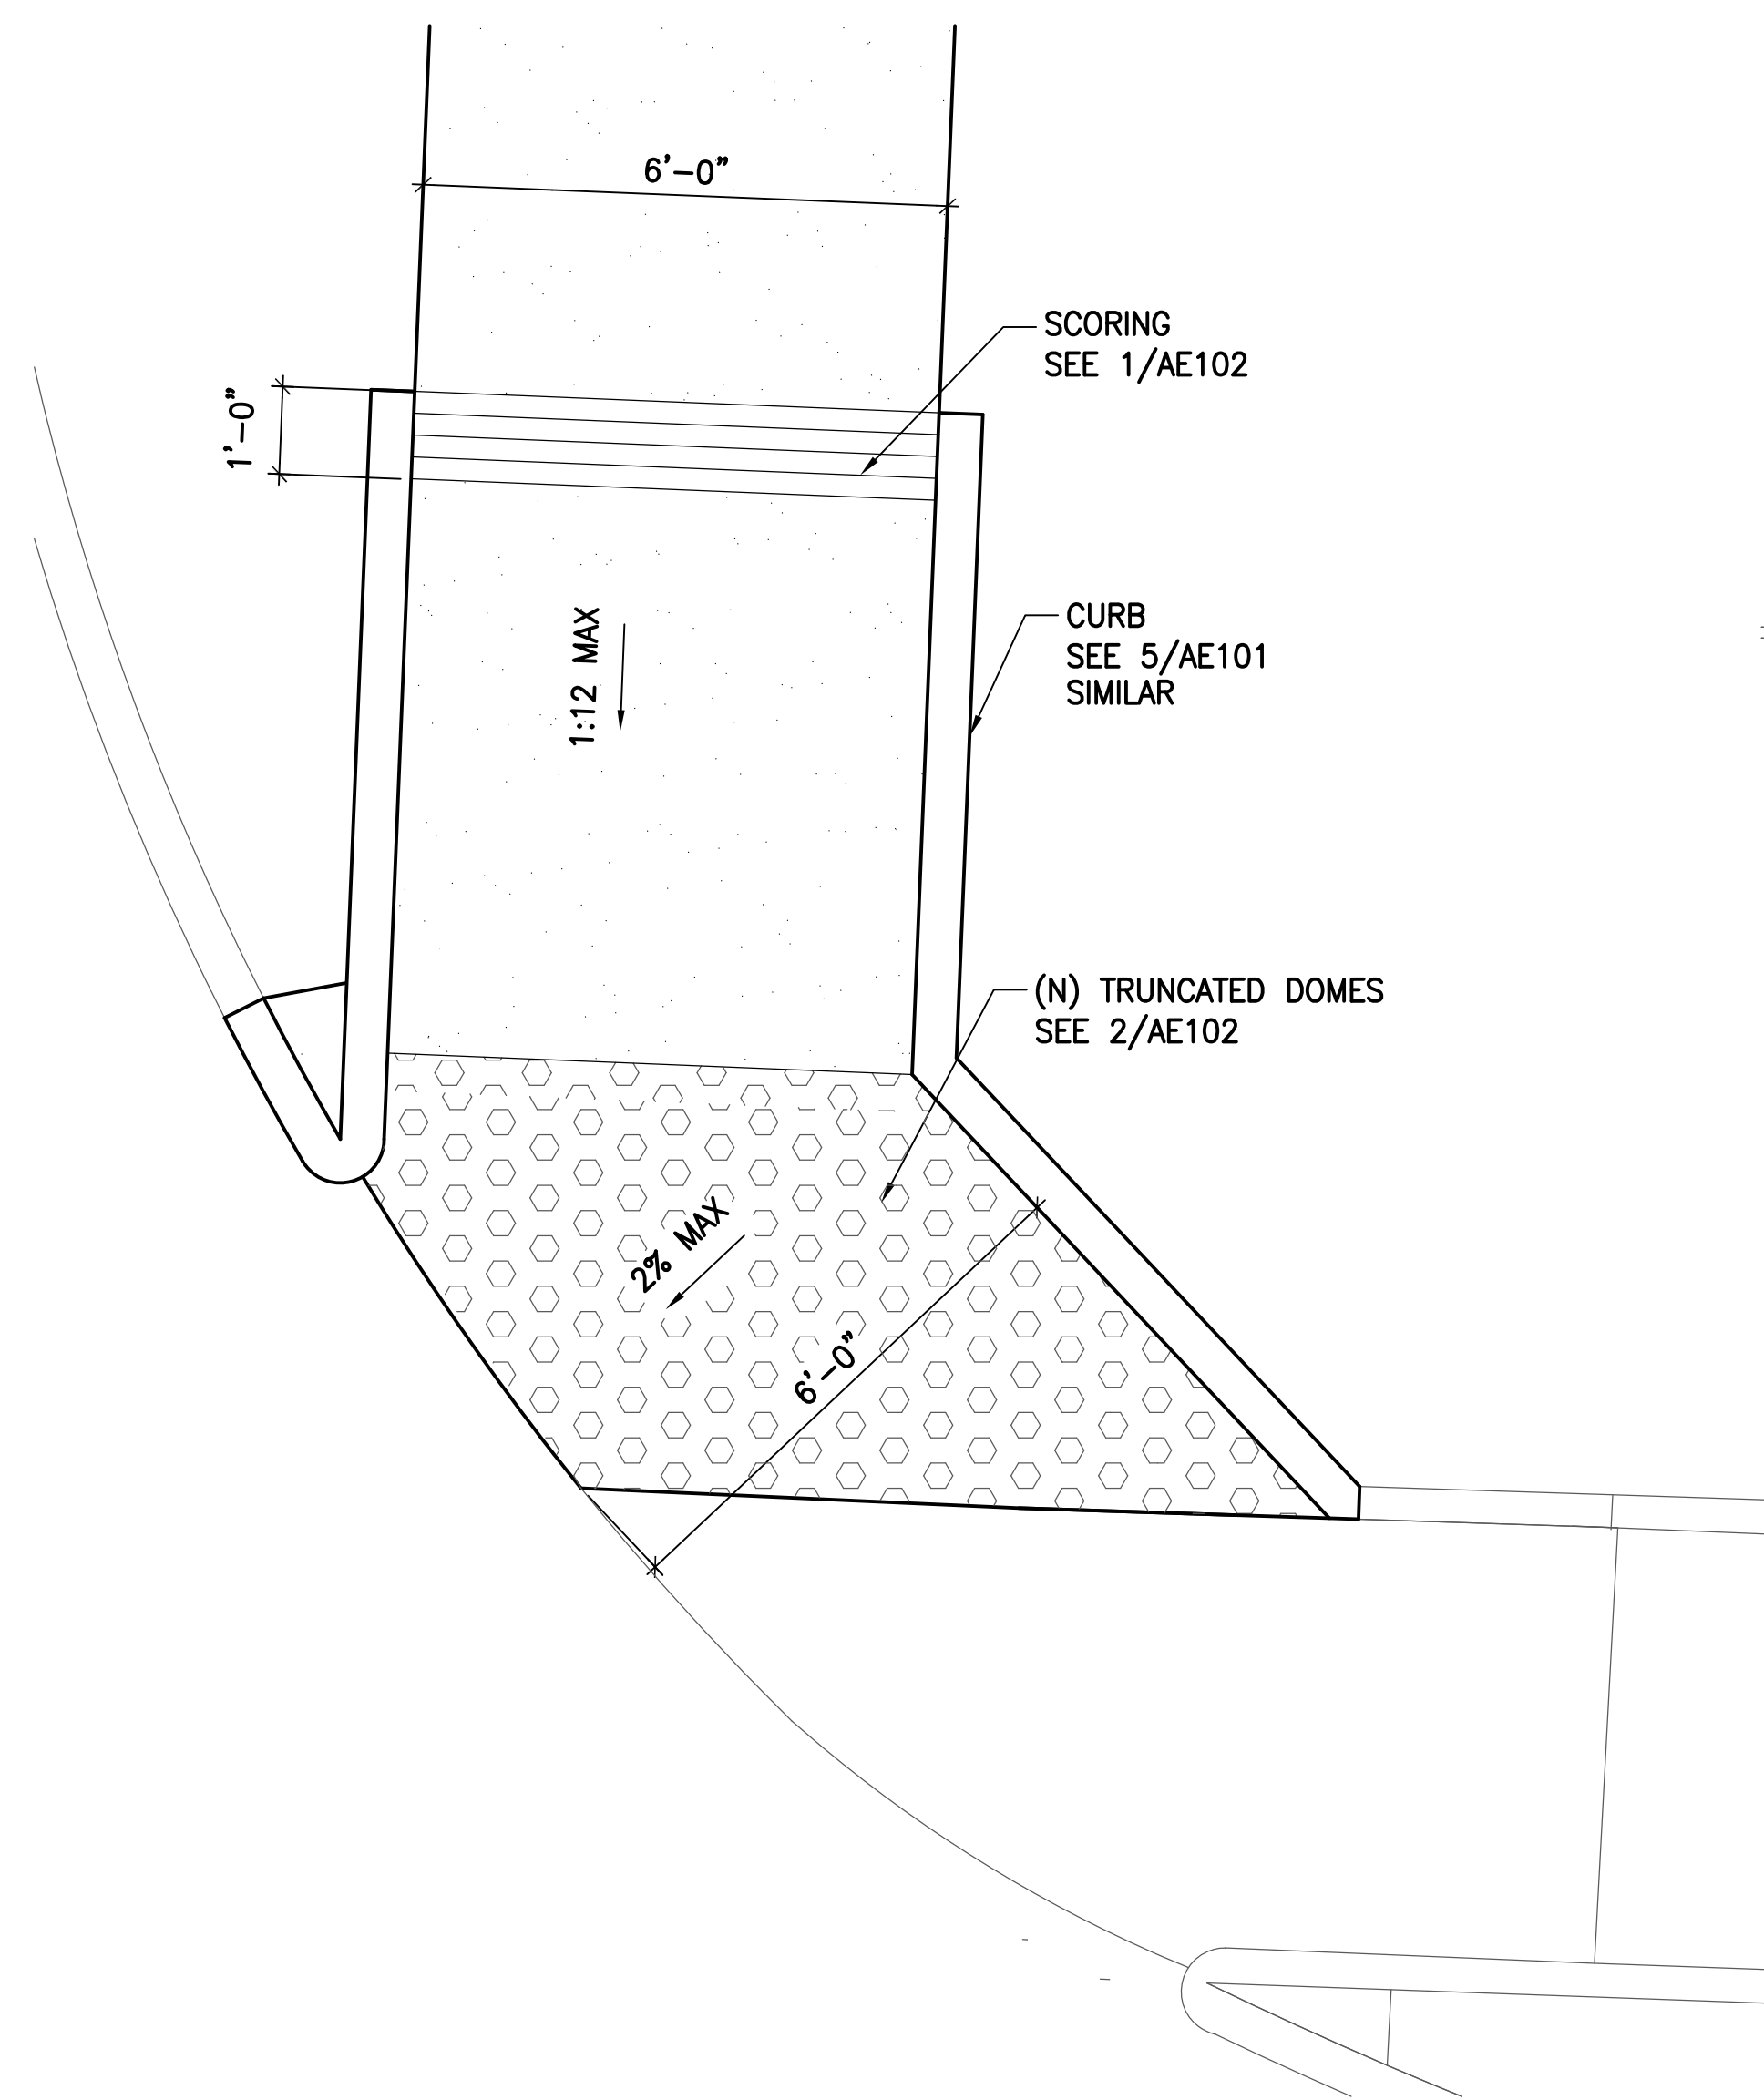


2 RAMP PLAN  
1/2"=1'-0"

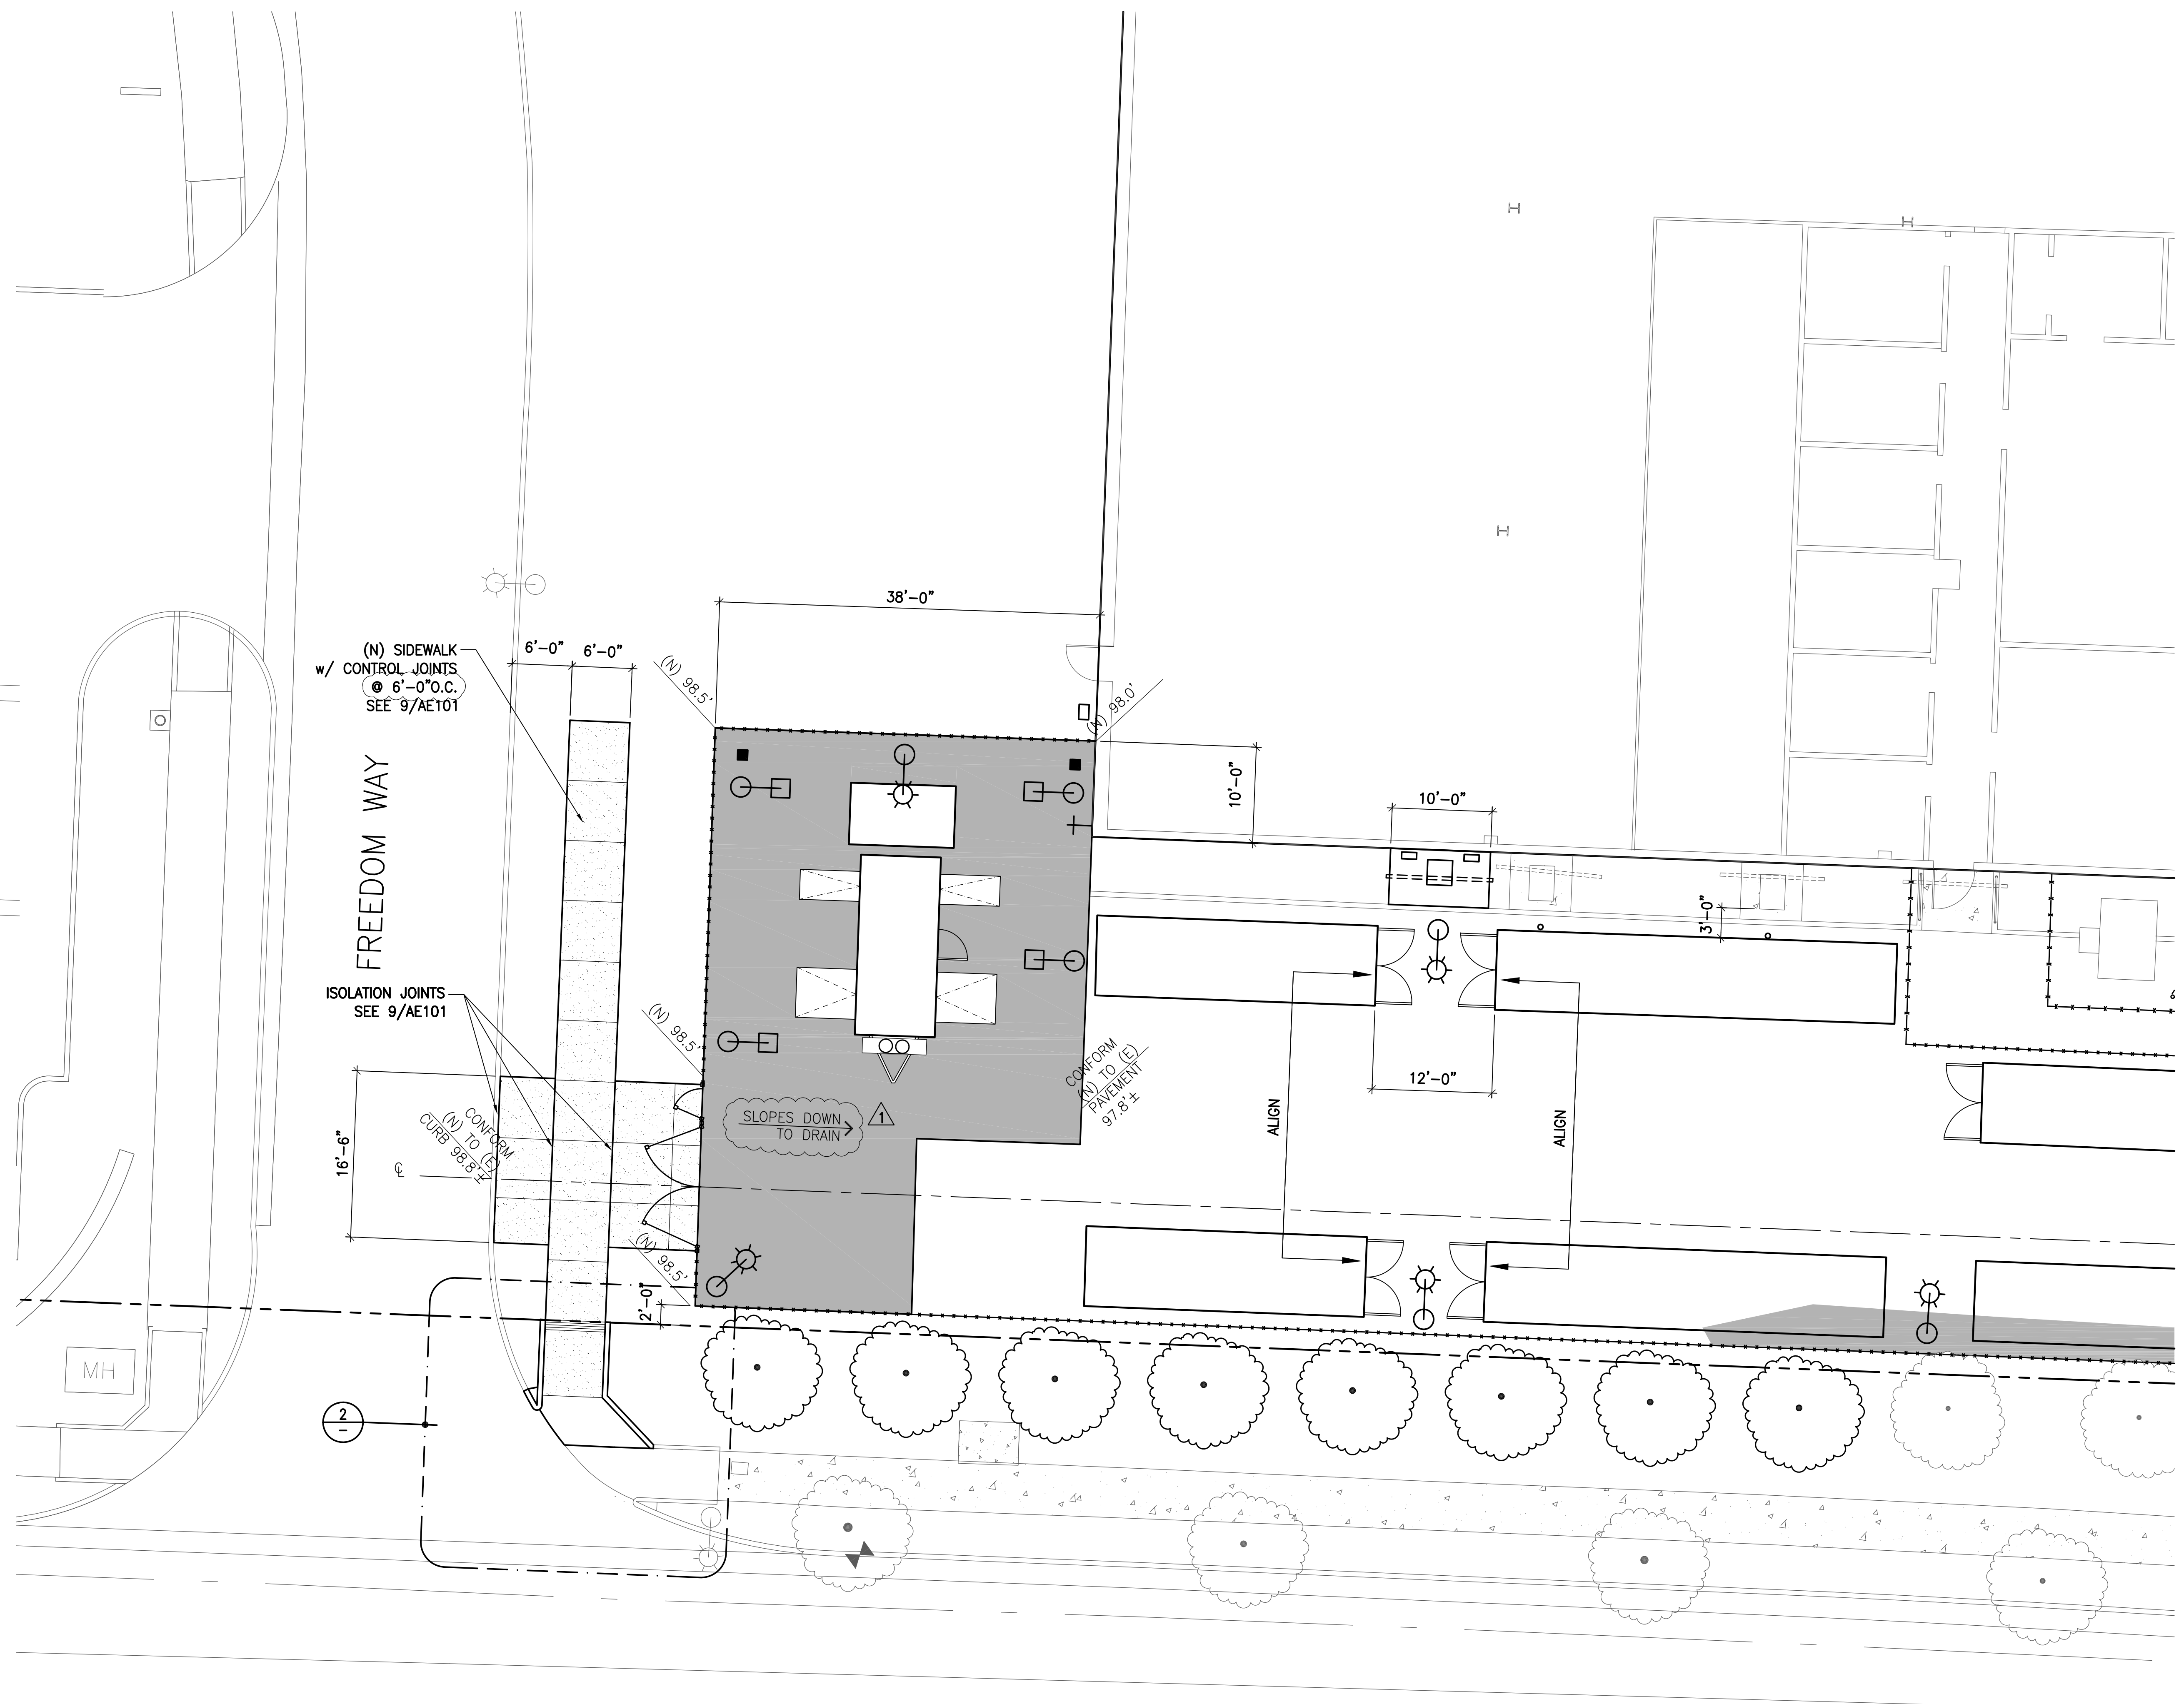



1 AREA 2 - DIMENSION PLAN  
1/8"=1'-0"

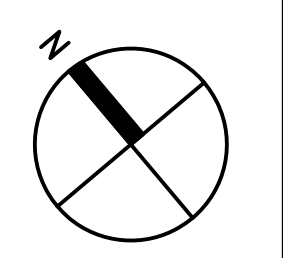MIRANDA AVENUE



100% CONSTRUCTION DOCUMENTS

-	-	CONSULTANTS:		Stamp and Signature	ARCHITECT/ENGINEERS:	<div><div>ENGINEERS ARCHITECTS ONE KAISER PLAZA SUITE 445 OAKLAND CALIFORNIA 94612 TEL 510.271.6701 FAX 510.271.6707 ©THE KPA GROUP 2013 KPA Project No. 575.00</div></div>	Drawing Title AREA 2 - DIMENSION PLAN	Project Title EMERGENCY STORAGE RELOCATION	Project Number 640-14-10SP	Office of Construction and Facilities Management	
-	-										
-	-										
-	-										
-	-										
-	-										
-	-										
ADDENDUM 1	4/11/14									Drawing Number <b>AS103</b>	Dwg. of
VA REVIEW	03/19/14										
100% CONSTRUCTION DOCUMENTS	02/28/14										
Revisions:	Date										
							Approved: Project Director - VAPAHCS PLANNING AND ENGINEERING	Location 3801 MIRANDA AVENUE, PALO ALTO, CA	Date 02/28/2014	Checked PWP	Drawn KPA TEAM
<div></div>											