

FIRST FLOOR - SPACE-ACCOUNTING SUMMARY TABLE (ASSIGNED AREAS)				
ROOM No.	ROOM NAME	ROOM AREA		VARIANCE (H-7610 REQRD. - APPROVED SPACE)
		H-7610 REQRD.	APPROVED SPACE PROGRAM	
ADMINISTRATION HOLDING				
1V23	TECH OFFICE	240 SF	167 SF	73 SF
1V23a	VETERINARIAN OFFICE	120 SF	132 SF	-12 SF
ANIMAL HOLDING AREAS				
1V06	MICE COLONY	260 SF	600 SF	-340 SF
1V08	RAT COLONY	260 SF	603 SF	-343 SF
1V10	VESTIBULE	40 SF	75 SF	-35 SF
1V10a	ABSL-2 HOLDING & PROCEDURE AREA		258 SF	
1V10b	ABSL-2 HOLDING AREA		71 SF	
PROCEDURE / SURGERY SUITE				
1V11	MED. SUP. STORAGE	145 SF	42 SF	103 SF
1V12	NECROPSY	120 SF	73 SF	47 SF
1V13	PROCEDURE ROOM	240 SF	90 SF	150 SF
1V14	PROCEDURE ROOM	240 SF	89 SF	151 SF
1V16	PROCEDURE ROOM	240 SF	130 SF	110 SF
1V17	PROCEDURE ROOM	240 SF	132 SF	108 SF
1V18	PROCEDURE ROOM	240 SF	84 SF	156 SF
VIVARIUM COMMON SPACES				
1V01	STORAGE	100 SF	78 SF	22 SF
1V24	RECEIVING AREA	250 SF	517 SF	-267 SF
VIVARIUM SUPPORT SPACES				
1V03	WOMEN LR.	80 SF	124 SF	-44 SF
1V03a	WOMEN RR	130 SF	62 SF	68 SF
1V04	MEN LR.	80 SF	126 SF	-46 SF
1V04a	MEN RR	130 SF	62 SF	68 SF
1V07	HAC	40 SF	34 SF	6 SF
1V09	EQUIPMENT STORAGE	100 SF	47 SF	53 SF
1V15	STO	0 SF	15 SF	-15 SF
1V19	PALLET STORAGE	400 SF	338 SF	62 SF
1V20	CLEAN SIDE	400 SF	338 SF	62 SF
1V20a	AUTOCLAVE		125 SF	
1V20b	CAGE WASHER		93 SF	
1V21	FEED & BEDDING	120 SF	66 SF	54 SF
1V25	SOILED SIDE	400 SF	342 SF	58 SF
1V25a	STO	0 SF	27 SF	-27 SF
1V27	TEMP. HOLD.	0 SF	46 SF	-46 SF
1V29	WASTE STORAGE	120 SF	75 SF	45 SF
1V30	RADIO. WASTE	120 SF	77 SF	43 SF
1V31	TANK STOR.	100 SF	38 SF	62 SF

WALL LEGEND





- DRYWALL CONSTRUCTION
- BRICK VENEER
- CMU CONSTRUCTION

* REFERENCE SHEET A501.1 & A501.2 FOR PARTITION TYPES AT BUILDING INTERIOR

FIRE EXTINGUISHER CANNOT PER VIA PROTECTION DESIGN MANUAL SECTION 6.4

WALL MOUNTED FIRE EXTINGUISHER PER VIA PROTECTION DESIGN MANUAL SECTION 6.4

FIRST FLOOR - SPACE-ACCOUNTING SUMMARY TABLE (UNASSIGNED AREAS)				
ROOM No.	ROOM NAME	ROOM AREA		VARIANCE (H-7610 REQRD. - APPROVED SPACE)
		H-7610 REQRD.	APPROVED SPACE PROGRAM	
BUILDING SUPPORT SPACE				
1V26	ELECT.	0 SF	46 SF	-46 SF
ELEV. - 3	ELEV. - 3	0 SF	79 SF	-79 SF
1V32	ELEV.M.R.	0 SF	47 SF	-47 SF
1V28	IT / TELECOMM	0 SF	78 SF	-78 SF
STAIR - 3	STAIR - 3	0 SF	196 SF	-196 SF
STAIR - 4	STAIR - 4	0 SF	184 SF	-184 SF
VIVARIUM COMMON SPACES				
1V05	GOWNING AREA	0 SF	52 SF	-52 SF
1V22	GOWNING AREA	0 SF	147 SF	-147 SF
1H1	HALLWAY	0 SF	239 SF	-239 SF
1H2	HALLWAY	0 SF	500 SF	-500 SF
1H4	HALLWAY	0 SF	98 SF	-98 SF
1H5	HALLWAY	0 SF	131 SF	-131 SF
1H3	HALLWAY	0 SF	147 SF	-147 SF
1V02	VESTIBULE	0 SF	109 SF	-109 SF
Grand total		0 SF	2,052 SF	-2,052 SF

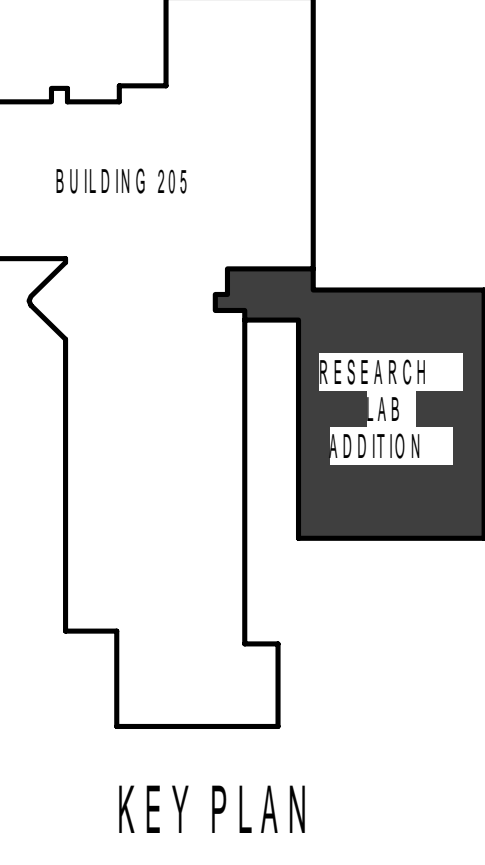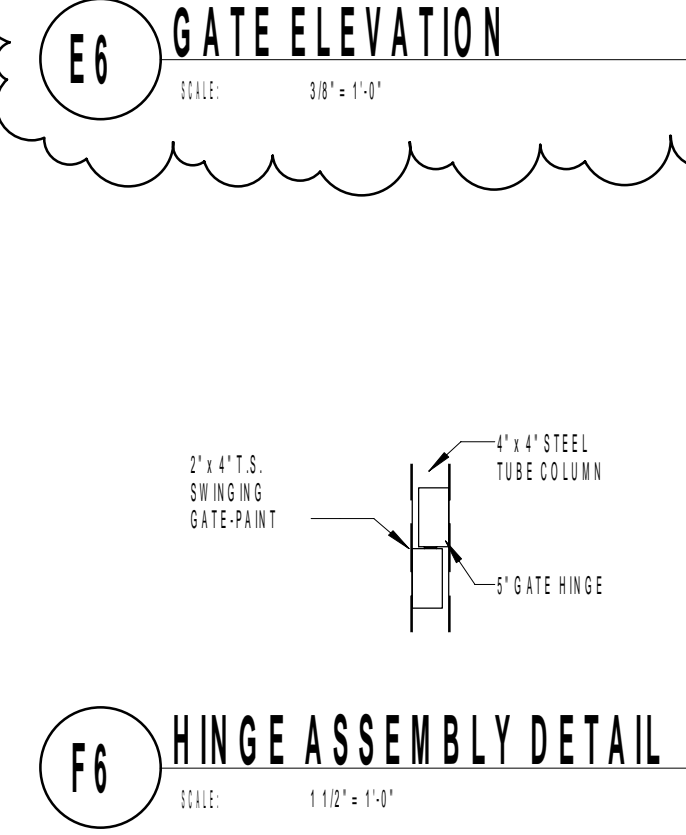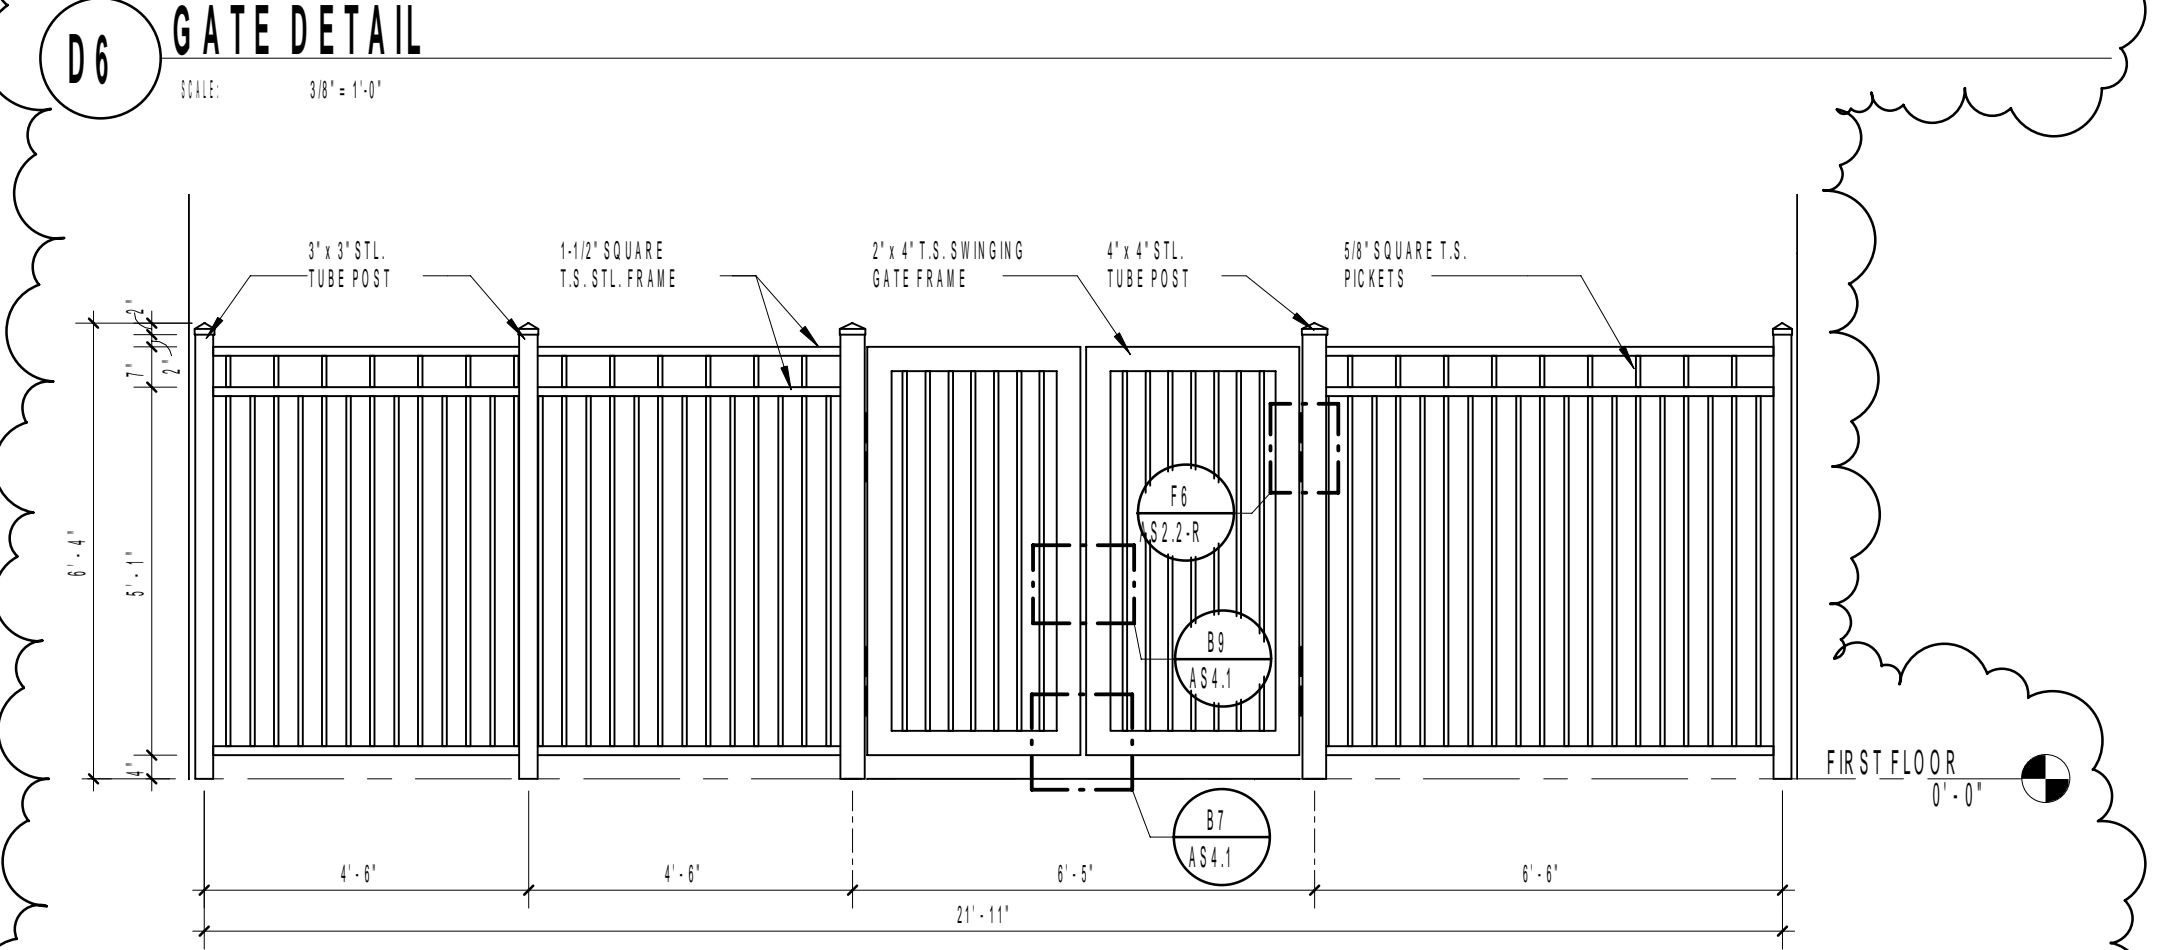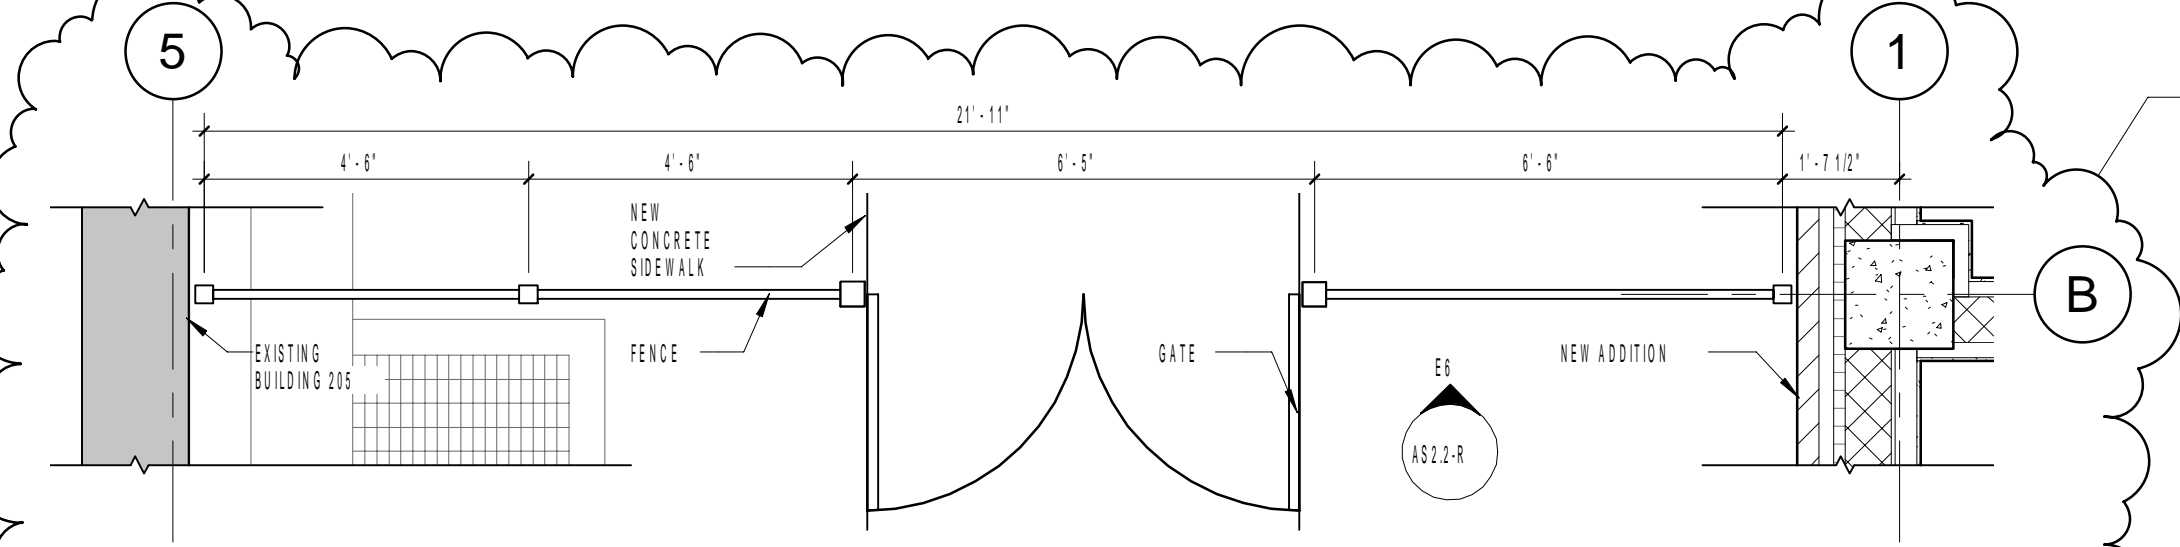

F1 FIRST FLOOR PLAN
SCALE: 1/8" = 1'-0"

CONSULTANTS		ARCHITECT		Project Title		Project Number		Office of Construction and Facilities Management	
WestEast Design Group		WestEast Design Group		RESEARCH ADDITION TO BUILDING 205		674-279			
200 East Grayson, Suite 207 San Antonio, TX 78215		200 East Grayson, Suite 207 San Antonio, TX 78215		Location		Drawing Number		Department of Veterans Affairs	
210.530.0755		210.530.0755		C1102-1001, Veterans Memorial Dr., Tampa, FL 33604		AS2.2-R			
www.westeastdesign.com		www.westeastdesign.com		Date		Checked		Dwg. 5 of 41	
These documents can not be copied or reproduced without written consent from WestEast Design Group		These documents can not be copied or reproduced without written consent from WestEast Design Group		May 20 2013		TB			
Revisions:		Revisions:		Drawing Title		First Floor Plan			
Revision 2: 05/09/2014		Revision 2: 05/09/2014							
Revision 1: 05/20/2013		Revision 1: 05/20/2013							