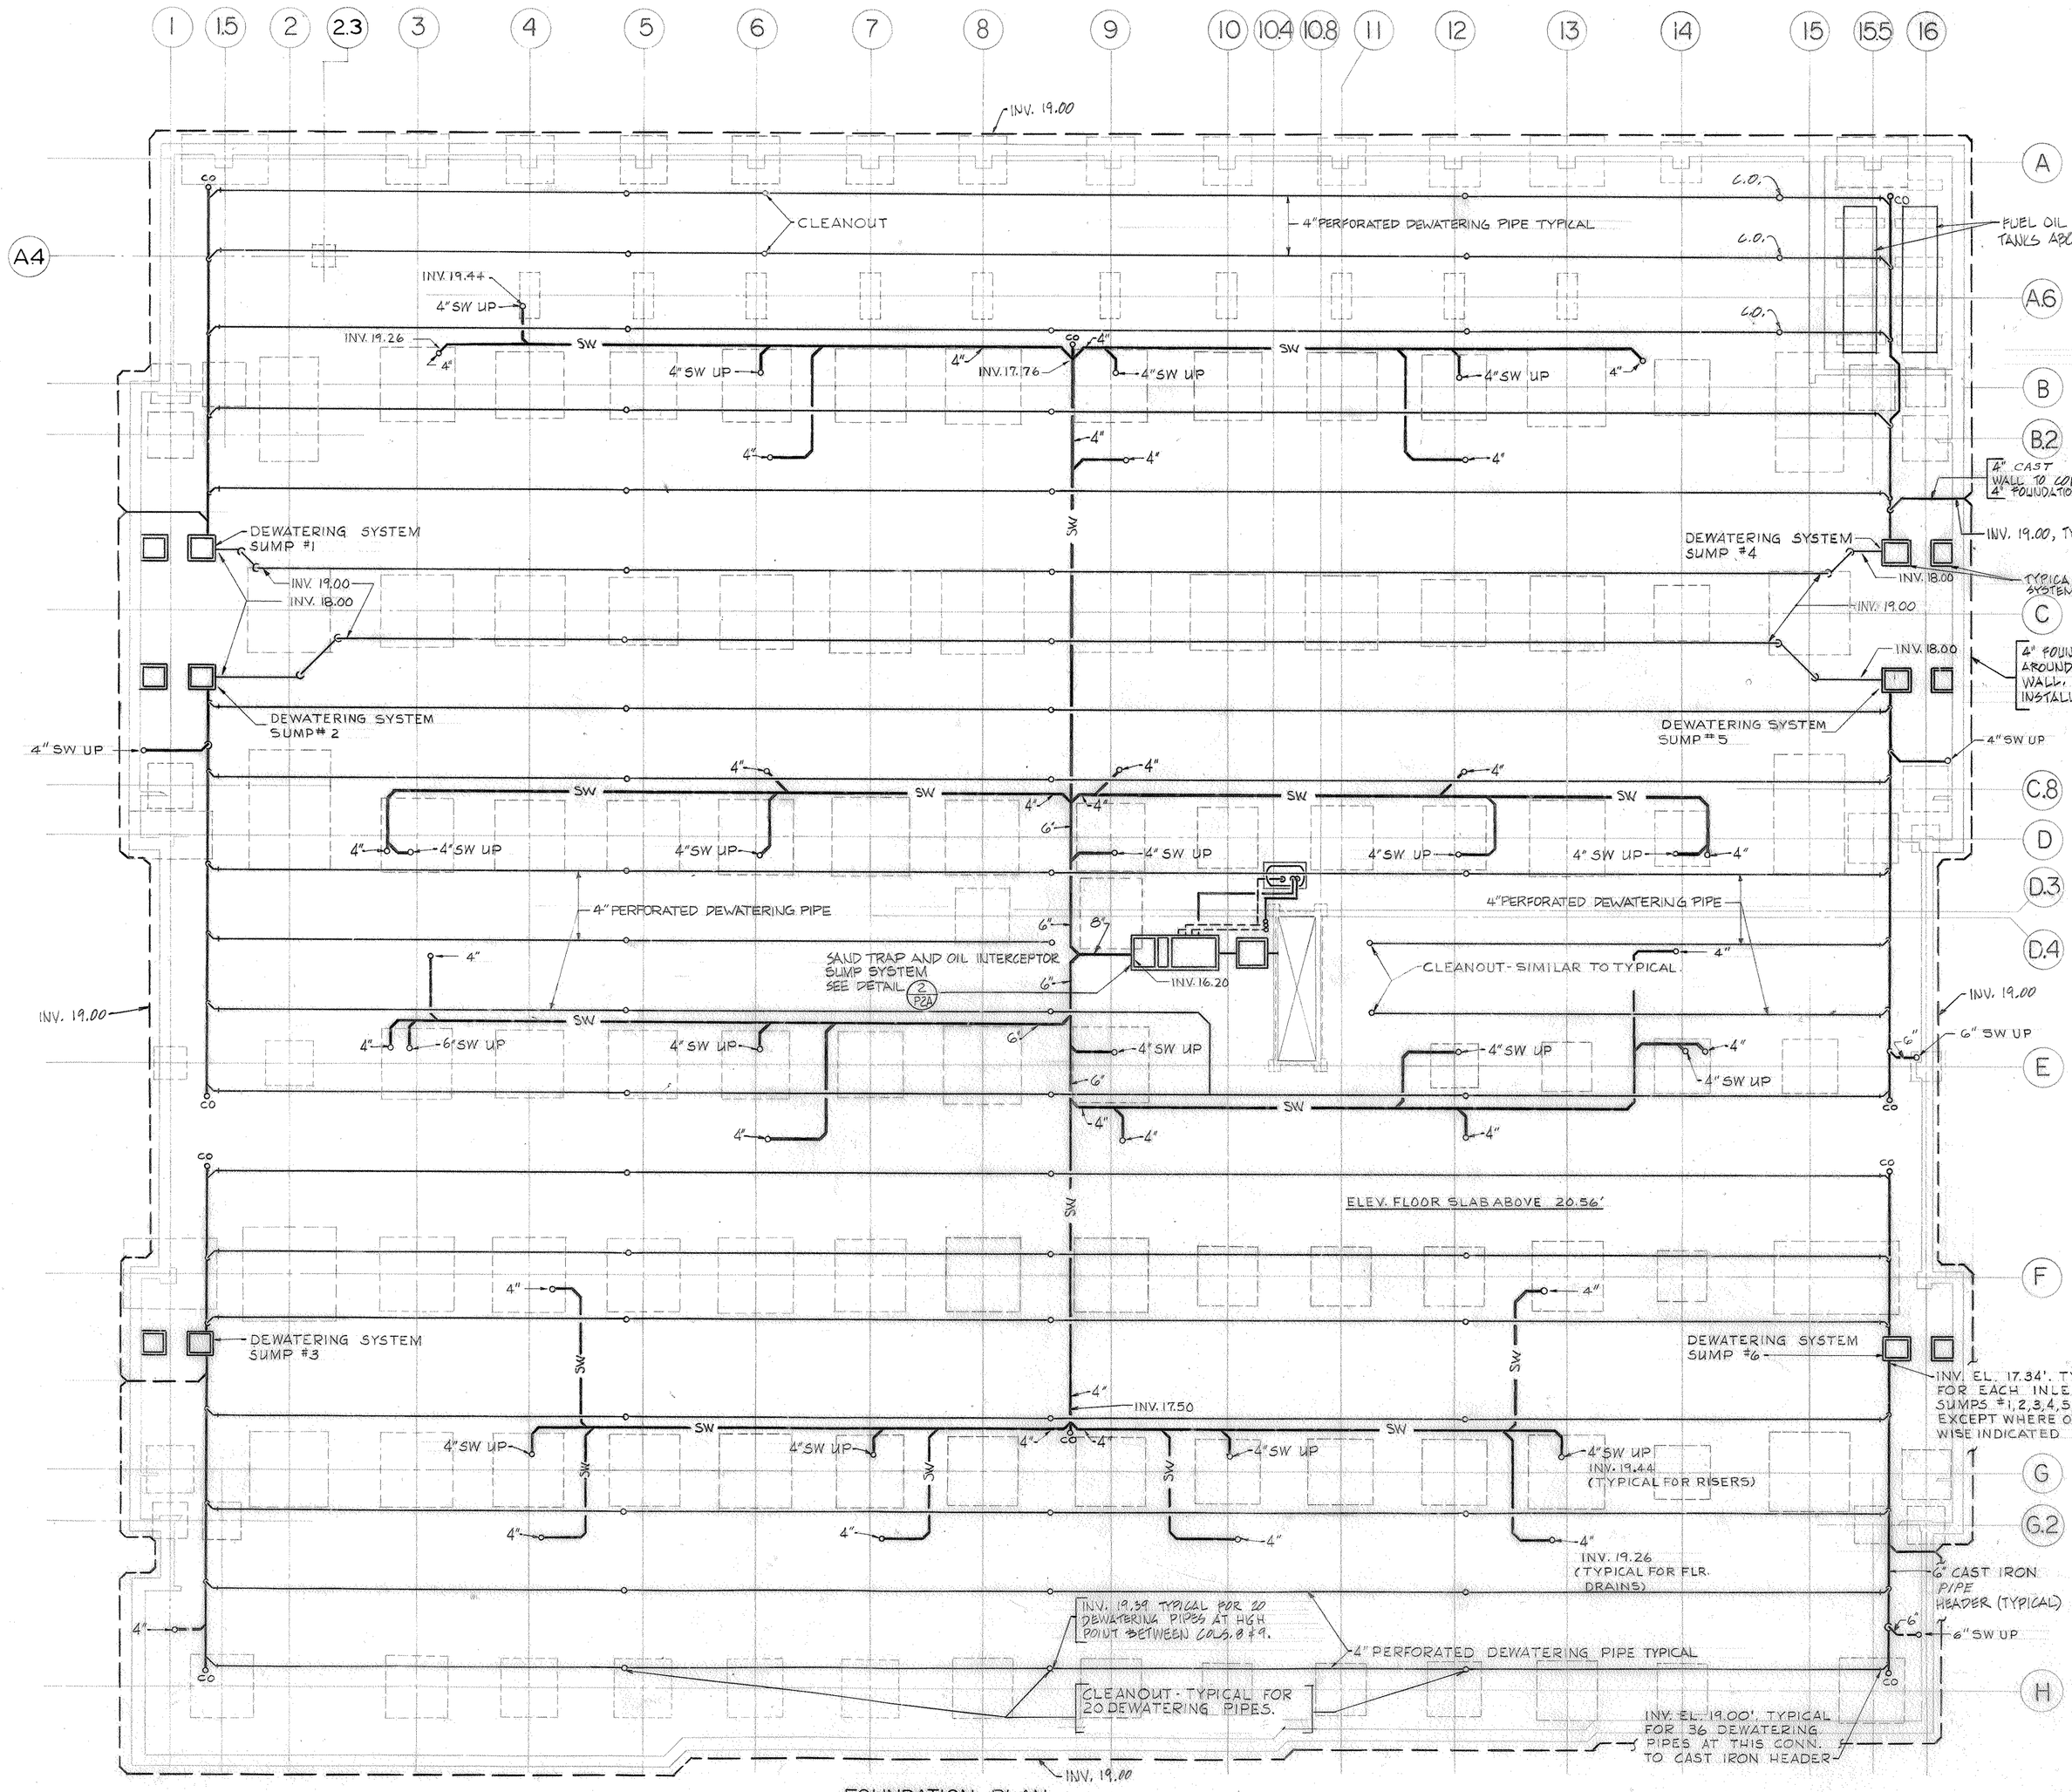

FOUNDATION PLAN
1/16"=1'-0"

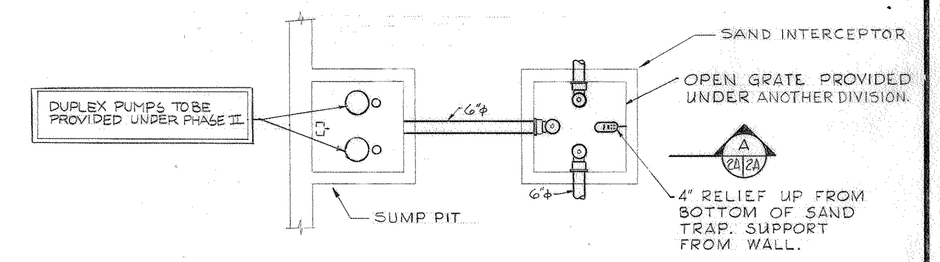

1/P2A DETAIL - TYPICAL DEWATERING SYSTEM SUMP AND SAND INTERCEPTOR
SCALE: 1/4"=1'-0"

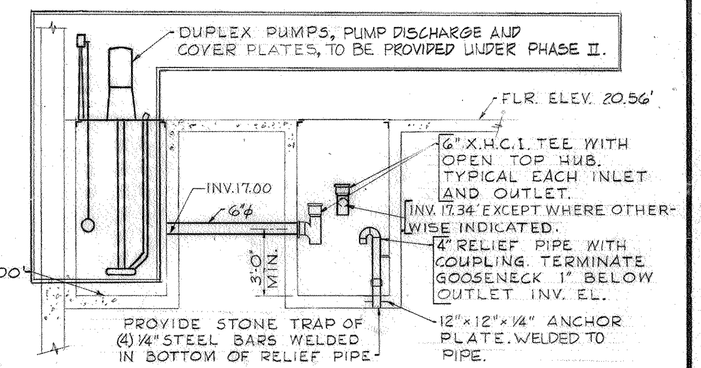

SECTION A/2A/2A
SCALE: 1/2"=1'-0"

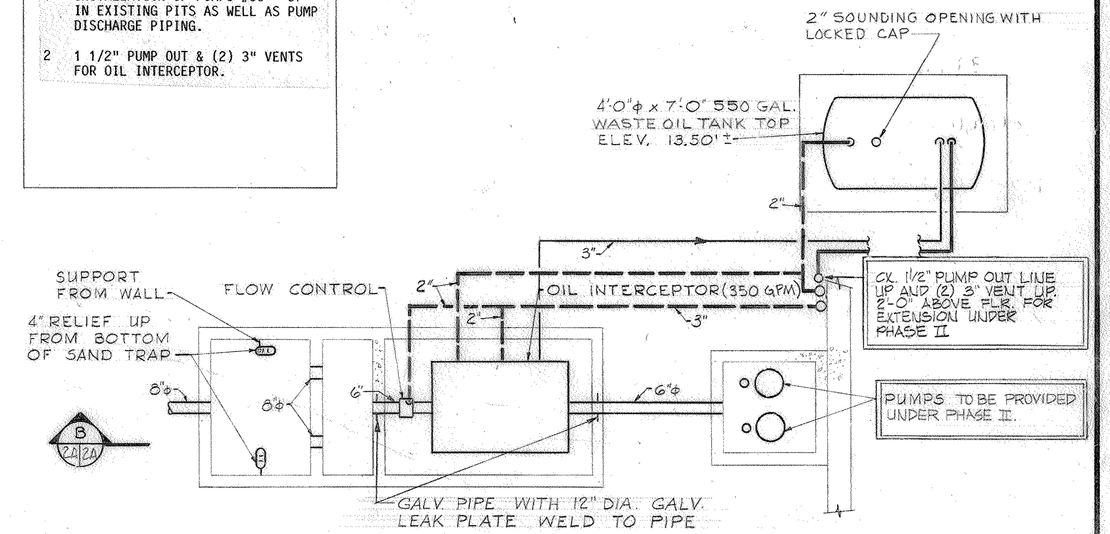

2/P2A DETAIL - SAND TRAP, OIL INTERCEPTOR AND SUMP PUMP
SCALE: 1/4"=1'-0"

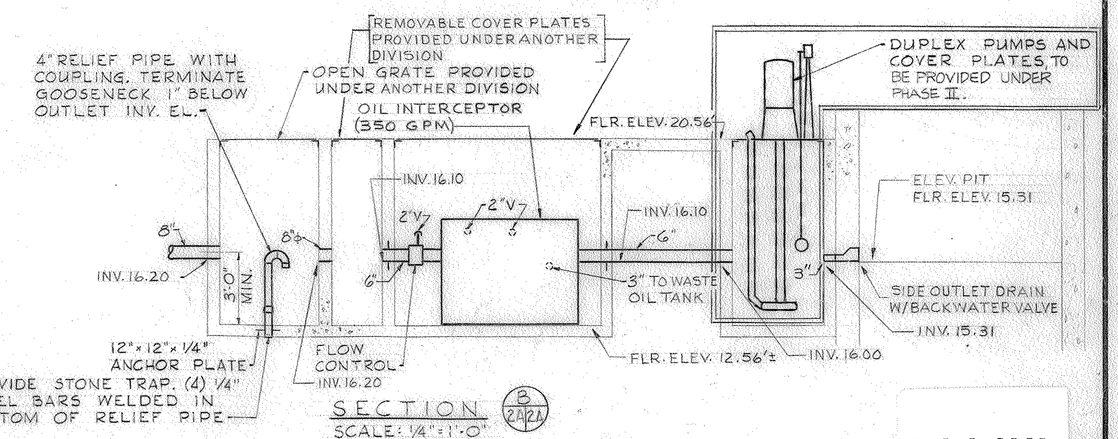

SECTION B/2A/2A
SCALE: 1/4"=1'-0"

8-0-1-1161

Revisions	Date
"AS BUILT"	6/17/94

RECORD DRAWING
CORRECTED ON BASIS OF DATA FURNISHED BY THE RESIDENT ENGINEER

Key Plan

Seal

RTKL / CSD / HENRY ADAMS (J.V.)
ARCHITECTS AND ENGINEERS
400 E. PRATT STREET
BALTIMORE, MARYLAND 21202

HENRY ADAMS, INC.
Consulting Engineers
Baltimore, Maryland

Drawing Title: FOUNDATION PLAN PLUMBING

Approved Project Director: J. Gilbert Miller

Scale: AS NOTED

Checked

Project Title: 324-BED REPLACEMENT HOSPITAL - PHASE II

Building Number: |

Location: VAMC - BALTIMORE, MD.

Date: 9/1/88

Project No.: 511-001D

DRAWING NO.: I-P2A

Dwg. 3 OF 71

Veterans Administration

VA FORM 08-6231, OCT 1978

V0022AO