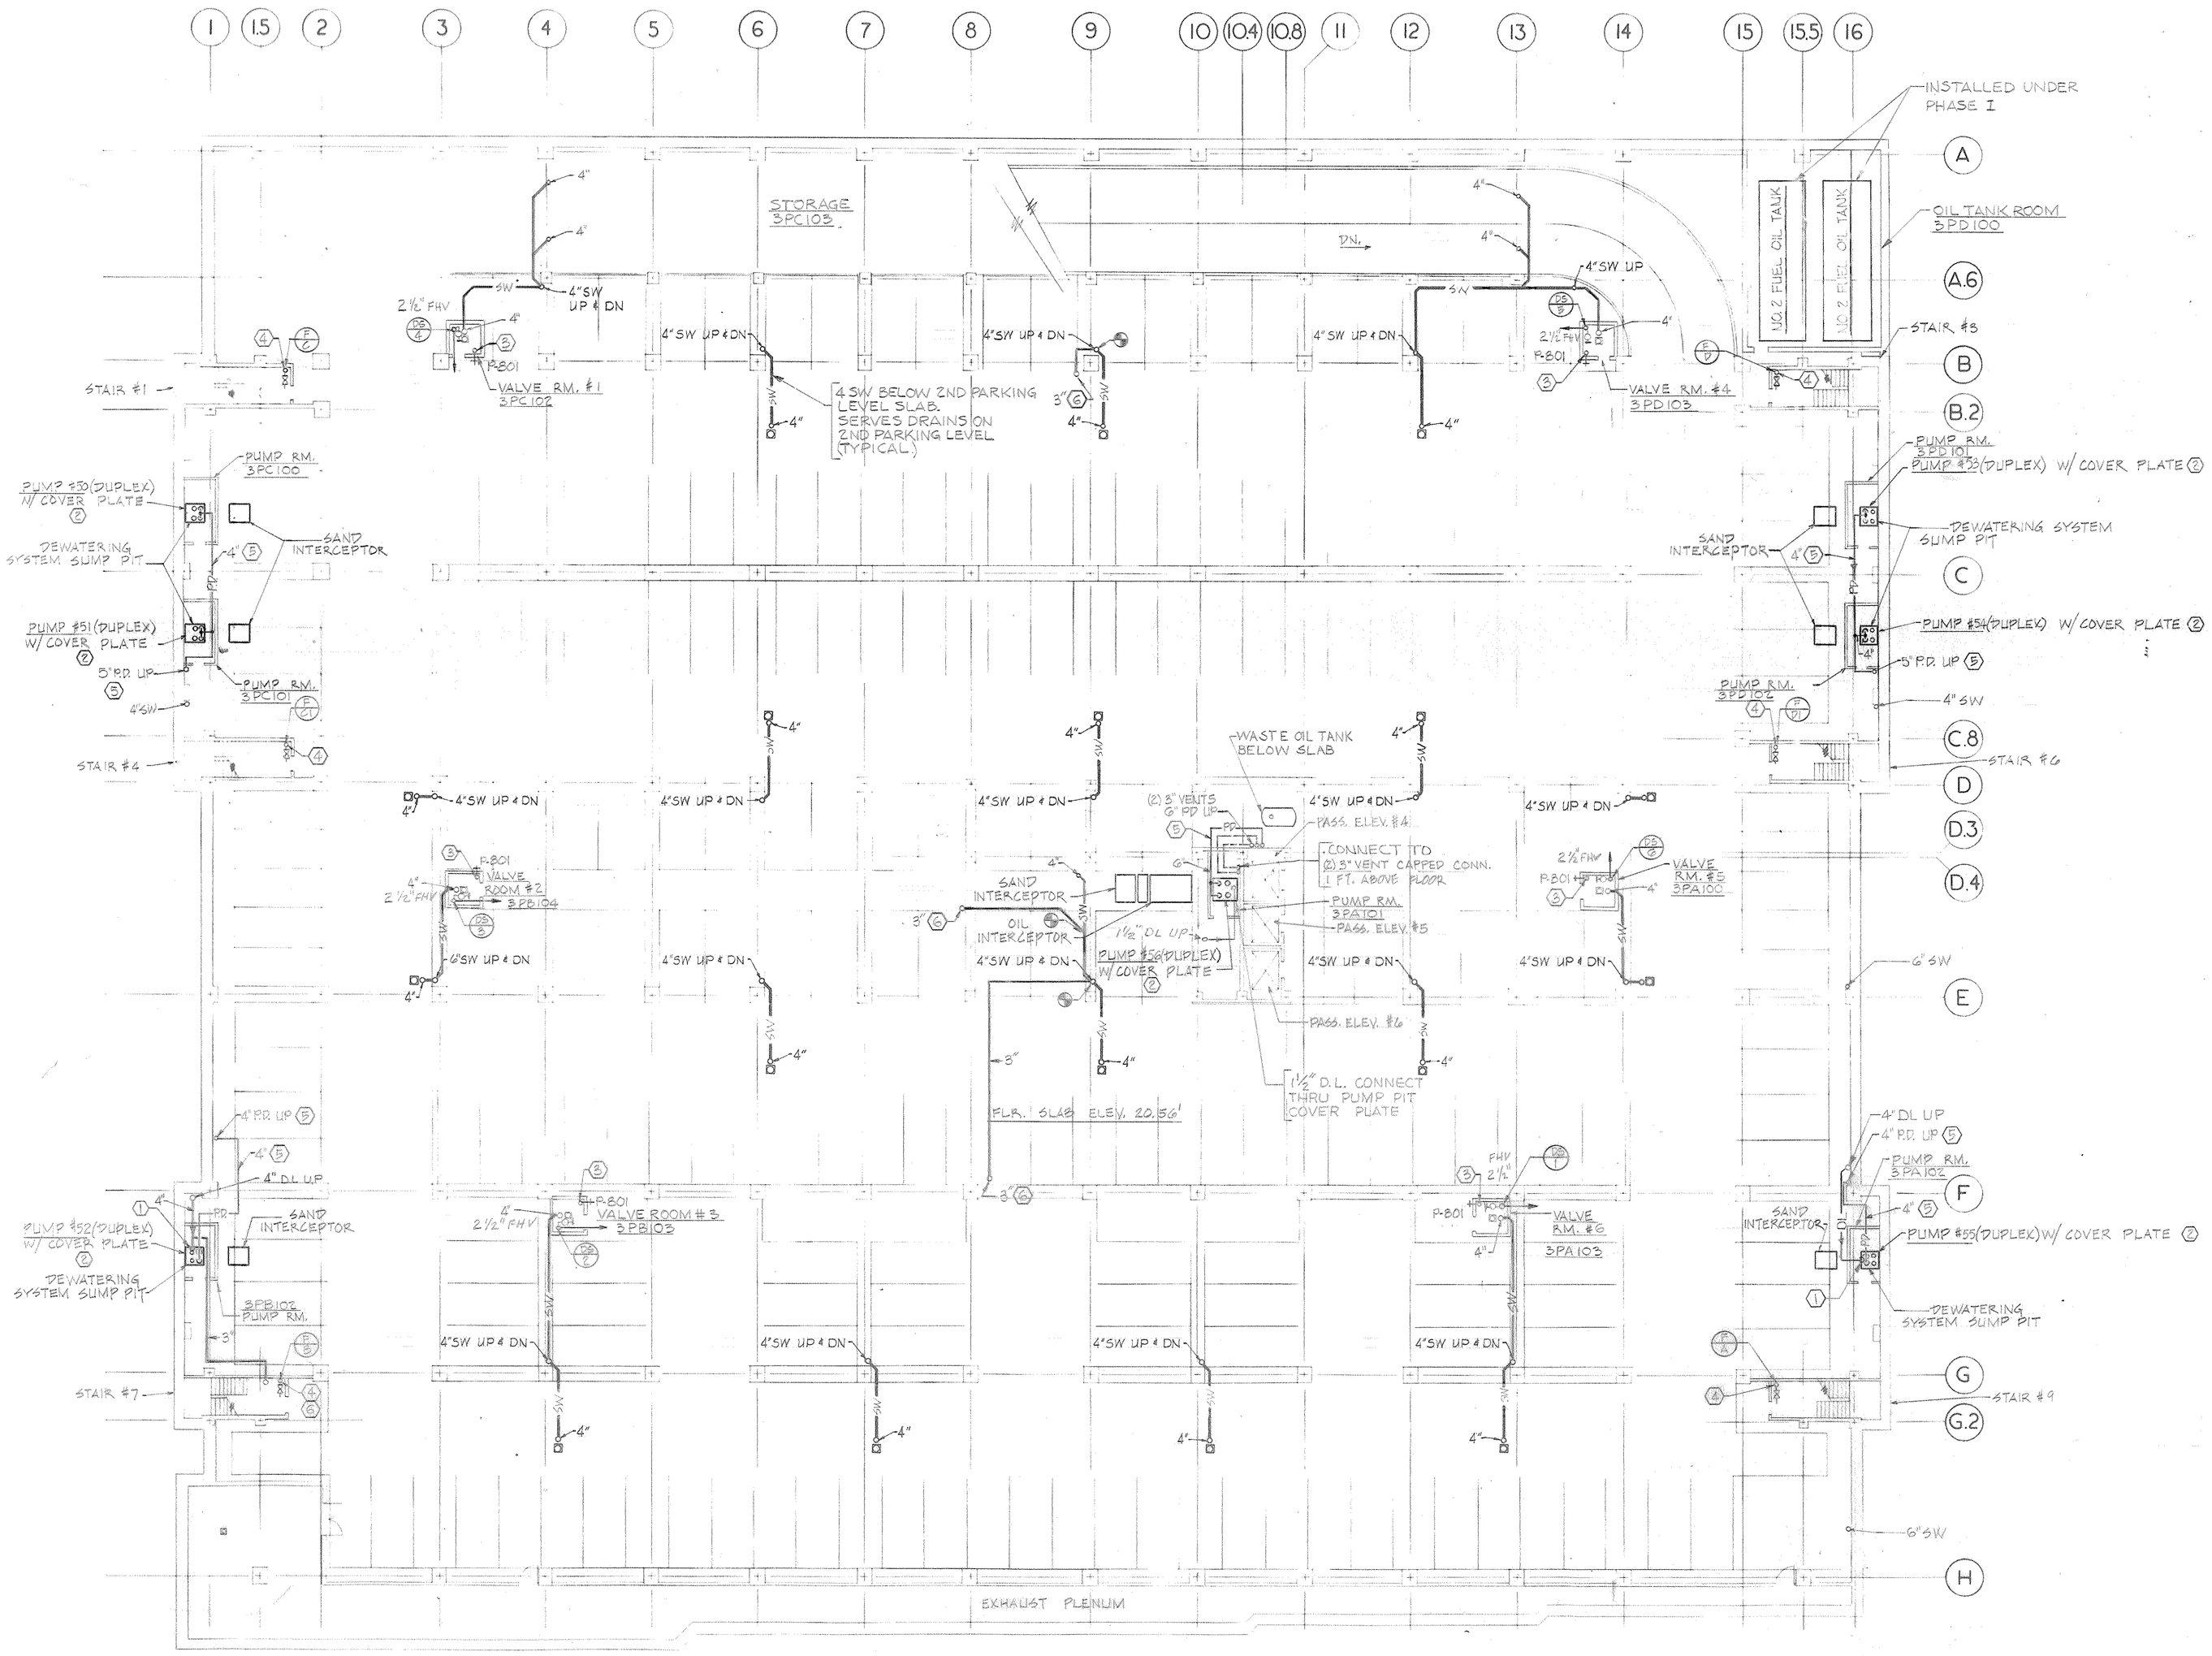


PROVIDE UNDER PHASE II

SPECIAL NOTES: (APPLY TO THIS DRAWING ONLY)

1. CX. 4" DL PROVIDED UNDER PHASE 1 (2 FT. ABOVE TOP OF SUMP). EXTEND TO SUMP.
2. PROVIDE PUMP AND COVER IN EXISTING PIT.
3. 1" CW UP THROUGH EX. SLEEVE.
4. 2-1/2" F UP WITH 2-1/2 FDV AT FLOOR LANDING. LOCATE FDV 60" AFF.
5. PROVIDE HEAT TAPE AND INSULATION OVER TAPE FOR ALL SUMP PUMP DISCHARGE FROM CHECK VALVE TO CEILING OF FIRST PARKING LEVEL. TYPICAL FOR PUMPS #50 THROUGH #56. HEAT TAPE PROVIDED UNDER ELECTRICAL DIVISION.
6. 3" DRAIN RISER UP FOR SPRINKLER DRAIN AND TEST. SEE DWG. 1-P66

FLOOR AND TRENCH DRAIN ARE UNDER EXISTING PROVIDED UNDER PHASE I

DRY SPRINKLER SYSTEM DESCRIPTION - PROVIDE UNDER PHASE II

1. GARAGE SPRINKLERS FOR SECOND AND THIRD PARKING LEVELS SHALL BE INSTALLED TO PROVIDE A MINIMUM CLEARANCE OF 7 FEET IN ALL DRIVING AND PARKING AREAS. CLEARANCE IN WALKWAY AREAS SHALL HAVE A MINIMUM CLEARANCE OF 6'-8".
2. GENERAL AREA OF COVERAGE FOR RISERS ON EACH LEVEL SHALL BE AS FOLLOWS:
   - A. DS 1 COLUMNS E-H AND 9-16. FIRE ALARM ZONE A
   - B. DS 2 COLUMNS E-H AND 1-9. FIRE ALARM ZONE B
   - C. DS 3 COLUMNS C-E AND 1-9. FIRE ALARM ZONE C
   - D. DS 4 COLUMNS A-C AND 1-9. FIRE ALARM ZONE C
   - E. DS 5 COLUMNS A-C AND 9-16. FIRE ALARM ZONE D
   - F. DS 6 COLUMNS C-E AND 9-16. FIRE ALARM ZONE D

NOTE: THIS PARKING FLOOR IS UNHEATED EXCEPT FOR VALVE ROOMS AND STAIRWAYS. THIS PARKING FLOOR DOES NOT HAVE SUSPENDED CEILING.

SCOPE OF WORK - PHASE II: (APPLIES TO THIS DWG. ONLY)

MECHANICAL WORK INDICATED HAS BEEN INSTALLED UNDER PHASE I - EXCEPT FOR THE FOLLOWING WHICH SHALL BE PROVIDED UNDER PHASE II.

1. DRY PIPE SPRINKLER SYSTEM, INCLUDING RISERS IN 6 VALVE ROOMS.
2. FIRE STANDPIPES AND 2-1/2 FDV'S IN STAIRS #1, 3, 4, 6, 7 AND 9.
3. C.W. RISERS AND P-801 IN 6 VALVE ROOMS.
4. INSTALLATION OF PUMPS #50 THROUGH #56 IN EXISTING PITS. P.D. FOR PUMPS #50 THROUGH #52.
5. TWO 3"ø VENTS FOR OIL INTERCEPTOR PROVIDED UNDER PHASE I.




PART PLAN - ROOM 1PB102

SCALE: ¼" = 1'-0"

9-0-1-1162

FULLY SPRINKLERED

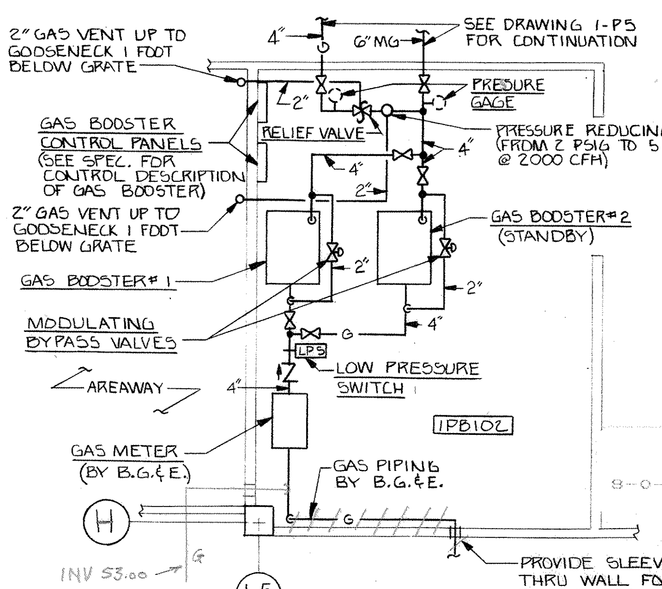RECORD DRAWING
CORRECTED ON BASIS OF DATA
FURNISHED BY THE RESIDENT ENGINEER

"AS BUILT" 6/17/94

Revisions | Date

Key Plan

NORTH

Seal

RTKL/CSD/HENRY ADAMS (J.V.)
ARCHITECTS AND ENGINEERS
400 E. PRATT STREET
BALTIMORE, MARYLAND 21202

HENRY ADAMS, INC.
Consulting Engineers
Baltimore, Maryland

Drawing Title: 3RD PARKING FLOOR PLAN PLUMBING

Approved Project Director: J. Gilbert Miller

Scale: 1/16" = 1'-0"

Checked

Project Title: 324-BED REPLACEMENT HOSPITAL-PHASE II

Building Number: 1

Location: VAMC - BALTIMORE, MD.

Date: 9/1/88

Project No.: 511-001D

DRAWING NO: 1-P3

Dwg. 4 of 74

Veterans Administration

VA FORM 08-6231, OCT 1978

VCO-2.AC