three inches = one foot
one and one-half inches = one foot
one inch = one foot
three-quarters inch = one foot
one-half inch = one foot
three-eighths inch = one foot
one-quarter inch = one foot
one-eighth inch = one foot

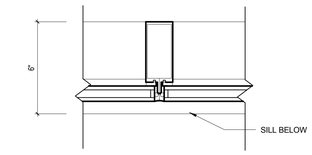

4 INTERMEDIATE VERTICAL MULLION
3" = 1'-0"

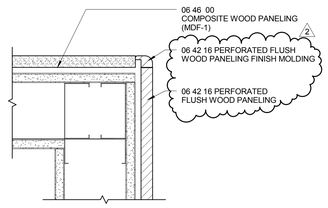

7 ACOUSTICAL WALL PANEL - CORNER
3" = 1'-0"

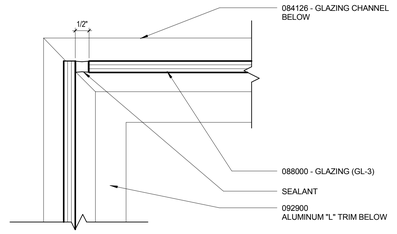

3 ALL GLASS STOREFRONT - CORNER
6" = 1'-0"

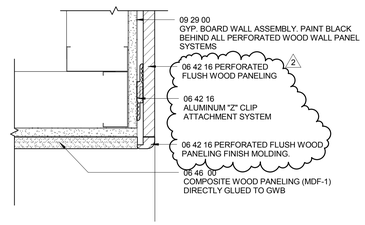

6 COMPOSITE WOOD WALL PANEL - SOFFIT
3" = 1'-0"

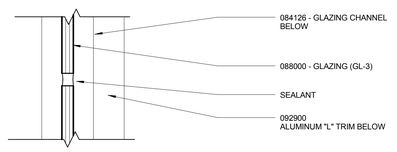

2 ALL GLASS STOREFRONT - BUTT JOINT
6" = 1'-0"

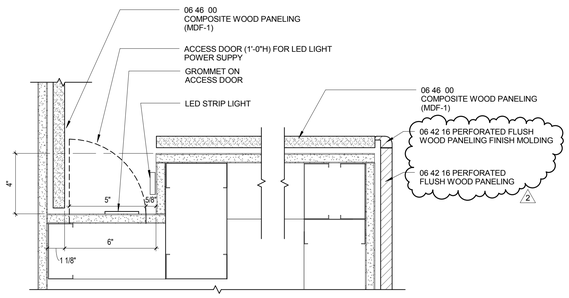

5 ACOUSTICAL WALL PANEL - LIGHT COVE
3" = 1'-0"

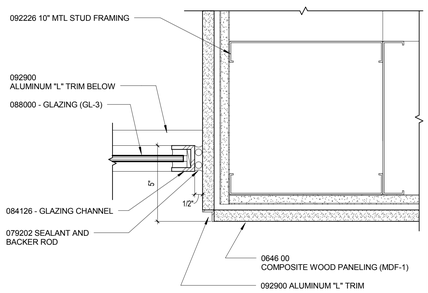

1 ALL GLASS STOREFRONT - JAMB AT COLUMN
3" = 1'-0"

GENERAL NOTES

KEY NOTES

LEGEND

PROJECT TRUE NORTH

ISSUE FOR BID

Revisions		Date
9		
8		
7		
6		
5		
4		
3		
2	ADDENDUM 2	05/16/2014
1	ADDENDUM 1	02/06/2014

CONSULTANTS:

Seals and Signatures

LICENSED ARCHITECT
CAREY S. WOO
C-25287
3 / 31 / 2015
Renewal Date
STATE OF CALIFORNIA

ARCHITECT/ENGINEERS:

CANNONDESIGN

201 Mission Street, Suite 2400, San Francisco, California 94105 415.243.4170

Baltimore ■ Boston ■ Buffalo ■ Calgary ■ Chicago
Houston ■ Los Angeles ■ Mumbai ■ New York ■ Phoenix
St. Louis ■ San Francisco ■ Shanghai ■ Toronto
Vancouver ■ Victoria ■ Washington DC

Drawing Title: LOBBY DETAILS

Approved: Project Director
Approver

Project Title: VA SIMULATION CENTER

Location: Veterans Affairs Palo Alto Heath Care System
3801 Miranda Ave,Palo Alto, CA 94304

Date: JUNE 14, 2013 | Checked: CW | Drawn: WK

VA Project Number: 640-385

Building Number: 105

Drawing No.: A0853

VA PAHCS Veterans Affairs Palo Alto Health Care System

Department of Veterans Affairs