


three inches = one foot
one and one-half inches = one foot
one inch = one foot
three-quarters inch = one foot
one-half inch = one foot
three-eighths inch = one foot
one-quarter inch = one foot
one-eighth inch = one foot

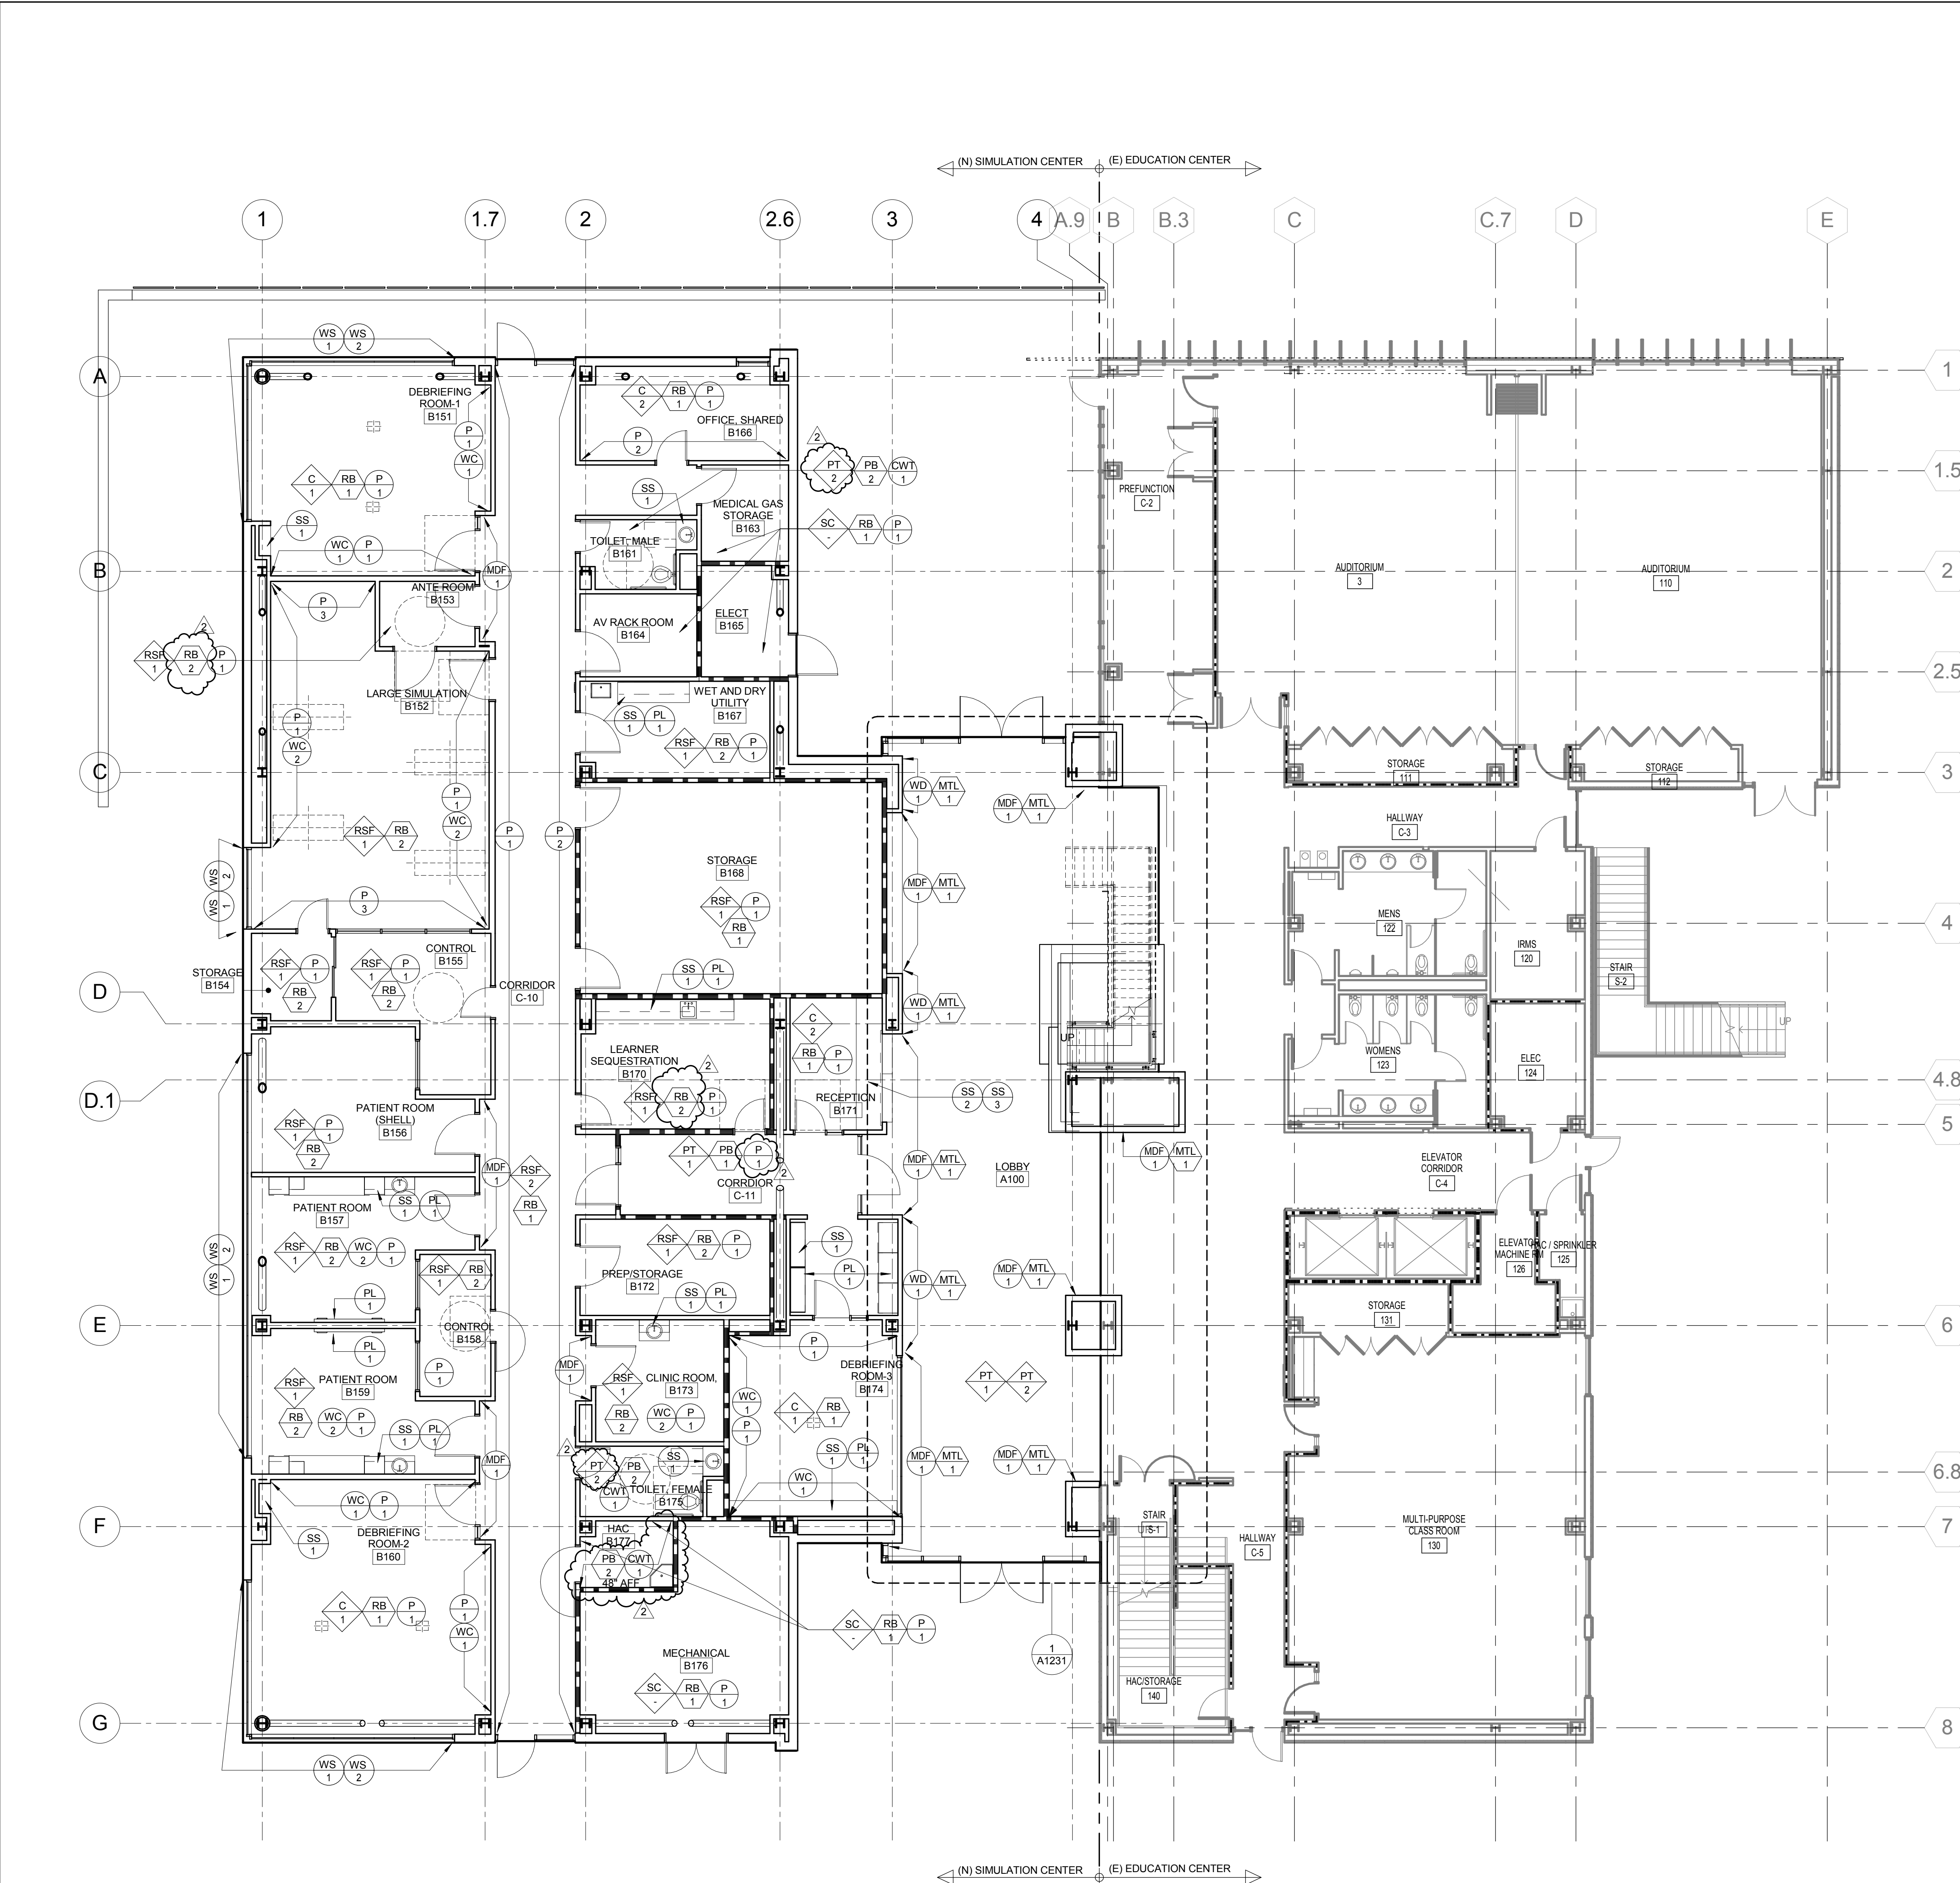

FINISH LEGEND

- CARPET**
- CARPET TILE
MFR: SHAW CONTRACT
STYLE: GLITZ 5090
COLOR: EDAMME
COLOR # 60309
 - CARPET TILE
MFR: SHAW CONTRACT
STYLE: RADIANCE 5091
COLOR: EDAMME
COLOR # 60309
- PORCELAIN TILE**
- MFR: ROCA TILE GROUP
PRODUCT: PACKSTONE
COLOR: ARENA
DIMENSIONS: 24"x48"
GROUT: HYDROMENT FLASH WALNUT H141
LOCATION: LOBBY
 - MFR: ROCA TILE GROUP
PRODUCT: PACKSTONE
COLOR: BAMBOO
DIMENSIONS: 12"x24"
GROUT: HYDROMENT FLASH WALNUT H141
LOCATION: LOBBY
- RESILIENT SHEET FLOORING**
- MFR: ARMSTRONG
SERIES: MEDINTONE SHEET
COLOR: NATURAL H832
LOCATION: VINYL SHEET FLOOR-SIMULATION ROOM AND ALL CLINICAL AREA
 - MFR: ARMSTRONG
SERIES: REJUVENATIONS SHEET
PATTERN: AMBIGU ALCHEMY 3803
COLOR: GINGER
LOCATION: VINYL SHEET FLOOR- CORRIDOR
- SEALED CONCRETE**
- SC
- WOOD FLOORING**
- MFR: ARMSTRONG
ITEM NUMBER: ESP240 NATURAL
SPECIES: MAPLE
FORM: PLANK
SIZE: 48"x9"x3/8" THK
LOCATION: ATRIUM - WAITING
- BASE**
- 6" RESILIENT BASE
JOHNSONITE 179 STEEL
 - 6" RESILIENT SHEET FLOORING COVE BASE
MFR: ARMSTRONG
SERIES: MATCH FLOOR
- 6" PORCELAIN TILE BASE**
- MFR: ROCA TILE GROUP
PRODUCT: PACKSTONE
COLOR: ARENA
DIMENSIONS: 6" HIGH
 - 6" PORCELAIN TILE BASE
MFR: UNITED STATES CERAMIC TILE
COLOR: BISQUIT
DIMENSIONS: 6" X 6"
- 6" PAINTED STEEL BASE**
- 1/8" THK SIZE PLATE
COLOR: C-2
- CERAMIC WALL TILE**
- MFR: UNITED STATES CERAMIC TILE
COLOR: BISQUIT
DIMENSIONS: 3" X 6"
GROUT: HYDROMENT DELOREAN GRAY H160
LOCATION: RESTROOM
- PAINT**
- MFR: KELLY-MOORE
COLOR: PRISTINE LINEN OV228-1
FINISH: EGG SHELL
LOCATION: GENERAL WHITE
 - MFR: BENJAMIN MOORE
COLOR: JACONSHINE 2140-60
FINISH: EGG SHELL
LOCATION: ACCENT
 - MFR: KELLY-MOORE
COLOR: PORTSMOUTH OLIVE KM 3405-2
FINISH: EGG SHELL
LOCATION: ACCENT
 - MFR: KELLY-MOORE
COLOR: OPENING NIGHT KM 3832-5
FINISH: SEMI-GLOSS
LOCATION: MTL WALL BASE
 - MFR: KELLY-MOORE
COLOR: DUNGEON AC259-5
FINISH: SEMI-GLOSS
LOCATION: BEHIND WALL OF PERFORATED WOOD WALL PANEL (WD-1)
- PLASTIC LAMINATE**
- MFR: WILSONART
COLOR: FUSION MAPLE 7909-60
LOCATION: CASEWORK
- SOLID SURFACE**
- MFR: CORIAN
COLOR: WHISPER
LOCATION: COUNTERTOP, TYPICAL
 - MFR: CORIAN
COLOR: MEDIA
LOCATION: RECEPTION DESK COUNTERTOP
 - MFR: 3FORM
STYLE: STONE SERIES -TRACE BONE
FINISH: POLISHED
THICKNESS: 3/8"
LOCATION: RECEPTION DESK CASEWORK
- WOOD**
- MFR: ARMSTRONG
SERIES: WOODWORK WALL PANEL
SPECIES: NATURAL MAPLE (MATCH EDUCATION BUILDING WOOD CEILING)
PERFORATION: ROUND STRAIGHT (W2)
LOCATION: ATRIUM
 - MFR: MARSHFIELD
SPECIES: FSC CERTIFIED WHITE MAPLE
FINISH: QUARTER SLICED, SLIP MATCHED, CENTER BALANCED, CLEAR FINISH (MATCH EDUCATION BUILDING)
LOCATION: DOOR
- MDF**
- MFR: INTERLAM
STYLE: VALCHROMAT
COLOR: BLACK
THICKNESS: 3/4" (19 MM)
LOCATION: ACCENT WALL
- WINDOW SHADES**
- MFR: MECHOSHADE
PRODUCT: THERMOVEIL 1300 SERIES 5%
COLOR: SILVER BROCH #1319
LOCATION: TYPICAL WINDOW, UON
 - MFR: MECHOSHADE
PRODUCT: EQUINOX BLACKOUT 0100 SERIES
COLOR: SILVER #0105
LOCATION: DEBRIEFING ROOMS, SIMULATION ROOMS & PATIENT ROOMS
- WALLCOVERING**
- MFR: CARNEGIE
SERIES: KOREL
PATTERN: NEXUS 417
LOCATION: FABRIC WRAPPED ACOUSTICAL PANEL IN DEBRIEFING ROOMS
 - MFR: KOROSAL
SERIES: KASHI
PATTERN: INCENSE STICK 7621-02
LOCATION: FABRIC WRAPPED ACOUSTICAL PANEL IN LARGE SIMULATION ROOM, PATIENT ROOMS & CLINIC ROOM
- WALK OFF MAT**
- MFR: CONSTRUCTION SPECIALTIES (C-S GROUP)
SERIES: PEDIMAT
TYPE: PEDIMAT M1 - ALUMINUM TAPERED ANGLE FRAME
LOCATION: FRONT ENTRY

GENERAL NOTES

- ALL EXPOSED SURFACES TO BE PAINTED
- COLOR: P-1, U.N.O.
- VERIFY EXISTING FLOOR TILE PATTERN TO MATCH NEW FLOOR TILE AT ATRIUM.

KEY NOTES

LEGEND

ISSUE FOR BID

PROJECT NORTH

Drawing Title LEVEL 1 INTERIOR FINISH PLAN	Project Title VA SIMULATION CENTER	VA Project Number: 640-385
Approved: Project Director Approver	Location Veterans Affairs Palo Alto Heath Care System 3801 Miranda Ave, Palo Alto, CA 94304	Building Number: 105
Date JUNE 14, 2013	Checked CW	Drawn WK
Drawing No. A1201		

VA PAHCS
Veterans Affairs Palo Alto Health Care System

Department of Veterans Affairs