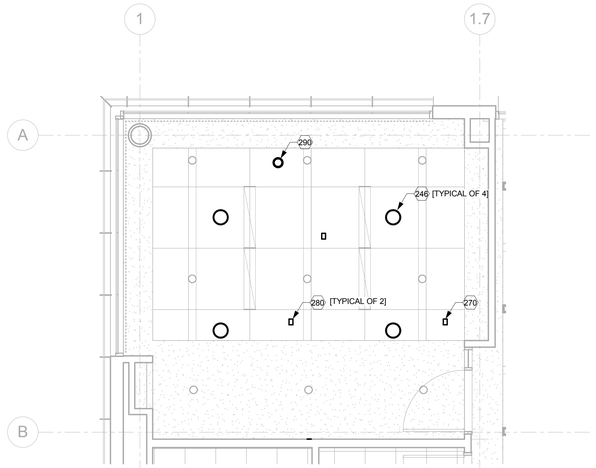

DEBRIEFING ROOM #1 151
2 REFLECTED CEILING PLAN - AV FACILITIES
1/4" = 1'-0"

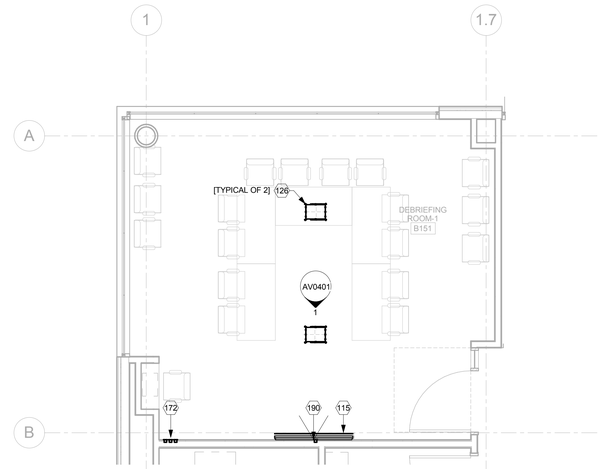

DEBRIEFING ROOM #1 151
1 FLOOR PLAN - AV FACILITIES
1/4" = 1'-0"

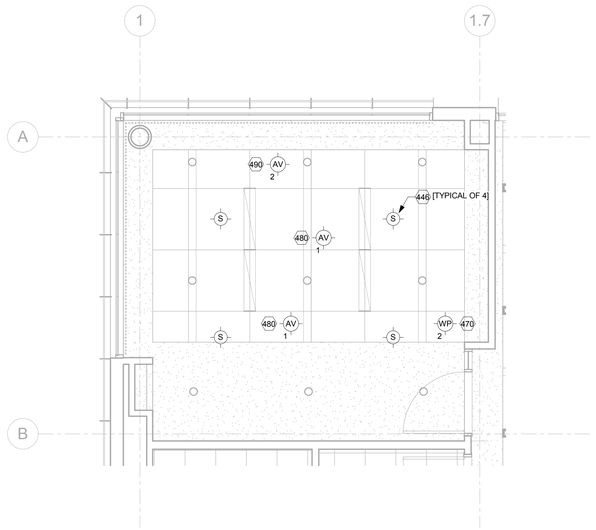

DEBRIEFING ROOM #1 151
4 REFLECTED CEILING PLAN - AV ELECTRICAL
1/4" = 1'-0"

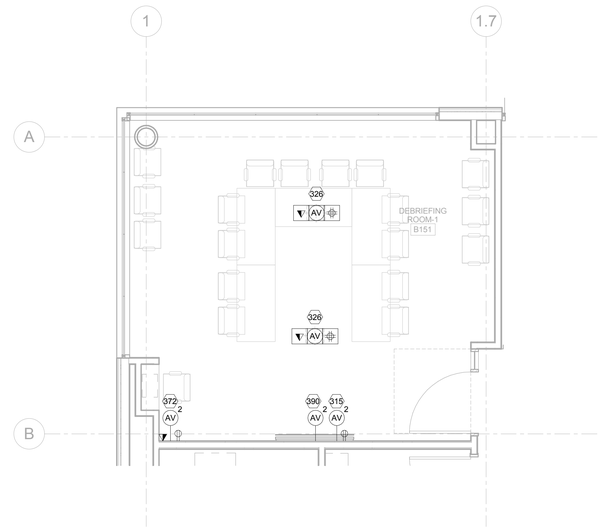

DEBRIEFING ROOM #1 151
3 FLOOR PLAN - AV ELECTRICAL
1/4" = 1'-0"

AV FLOOR PLAN FACILITIES NOTES:

115 70" FLAT PANEL DISPLAY - OFCI
2 126 FLOOR BOX - BY E.C.
172 AV CONNECTION PANEL - OFCI
190 WALL-MOUNTED CAMERA - OFCI

AV RCP FACILITIES NOTES:

246 CEILING-RECESSED LOUDSPEAKER - OFCI
280 CEILING MICROPHONE (BOUNDARY LAYER) - OFCI
290 CEILING CAMERA - OFCI

AV FLOOR PLAN ELECTRICAL NOTES:

315 70" FLAT PANEL DISPLAY
- (1) 1" EMT

326 FLOOR BOX
- (2) 1-1/4" EMT

372 AV CONNECTION PANEL
- (1) 1" EMT

390 WALL-MOUNTED CAMERA
- (1) 1" EMT

AV RCP ELECTRICAL NOTES:

446 CEILING-RECESSED LOUDSPEAKER
- (1) 3/4 EMT TO FIRST SPEAKER THEN,
- (1) 3/4 EMT BETWEEN LOUDSPEAKERS

470 WIRELESS ACCESS POINT
- (1) 3/4" EMT

480 CEILING MICROPHONE
- (1) 3/4" EMT

490 CEILING CAMERA
- (1) 1" EMT

GENERAL NOTES

1. REFER TO TELECOMMUNICATIONS DRAWINGS FOR PRIMARY CABLE PATHWAYS AND CABLE MANAGEMENT INFORMATION.
2. STUB ALL AV CONDUIT ABOVE FINISHED CEILING IN AN ACCESSIBLE LOCATION U.O.N. IF AN ACCESSIBLE LOCATION CAN NOT BE PROVIDED STUB CONDUIT TO NEAREST CABLE TRAY.
3. NON-CONTINUOUS CABLE SUPPORT IS REQUIRED FOR SECONDARY CABLE PATHWAYS ABOVE ACCESSIBLE CEILINGS.
4. ELECTRICAL AND TELECOMMUNICATION SYMBOLS SHOWN FOR INFORMATION AND COORDINATION ONLY.

KEY NOTES

LEGEND

PROJECT NORTH
TRUE NORTH

ISSUE FOR BID

Revisions		Date
2	ADDENDUM 2	05/16/2014
1	ADDENDUM 1	02/06/2014

CONSULTANTS:

SM&W
SHEN MILSOM WILKE
33 New Montgomery Street
San Francisco, CA 94105
Tel: 415-391-7610
Fax: 415-391-0171

Seals and Signatures

ARCHITECT/ENGINEERS:

CANNONDESIGN
201 Mission Street, Suite 2400, San Francisco, California 94105 415.243.4170
Baltimore ■ Boston ■ Buffalo ■ Calgary ■ Chicago
Houston ■ Los Angeles ■ Mumbai ■ New York ■ Phoenix
St. Louis ■ San Francisco ■ Shanghai ■ Toronto
Vancouver ■ Victoria ■ Washington DC

Drawing Title
AV SYSTEMS DEBRIEFING ROOM #1 151 ENLARGED PLANS

Approved: Project Director
Approver

Project Title
VA SIMULATION CENTER

Location
Veterans Affairs Palo Alto Heath Care System
3801 Miranda Ave,Palo Alto, CA 94304

Date: JUNE 14, 2013
Checked: SS
Drawn: RM

VA Project Number: 640-385
Building Number: 105
Drawing No. AV0302

VA PAHCS Veterans Affairs Palo Alto Health Care System
Department of Veterans Affairs

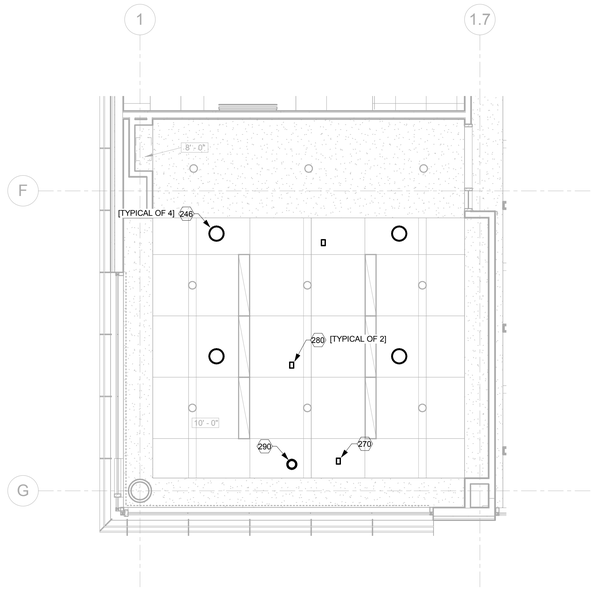

2 DEBRIEFING ROOM #2 160
REFLECTED CEILING PLAN - AV FACILITIES
1/4" = 1'-0"

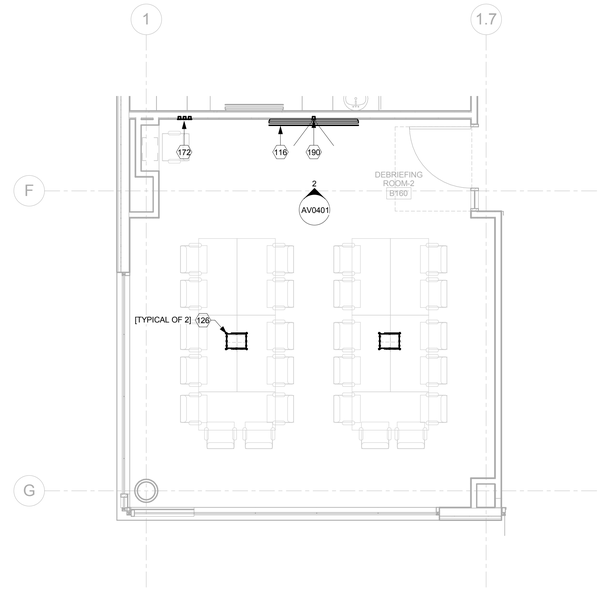

1 DEBRIEFING ROOM #2 160
FLOOR PLAN - AV FACILITIES
1/4" = 1'-0"

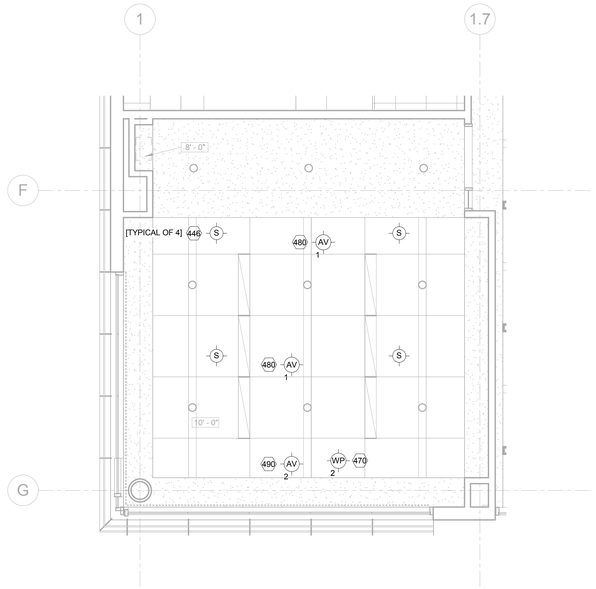

4 DEBRIEFING ROOM #2 160
REFLECTED CEILING PLAN - AV ELECTRICAL
1/4" = 1'-0"

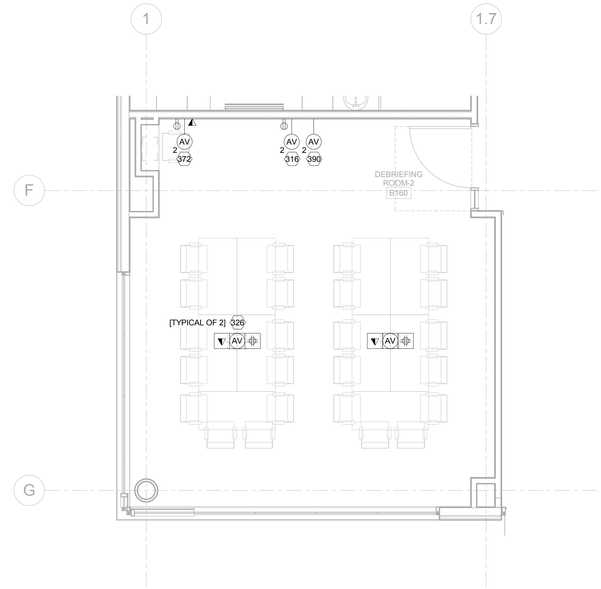

3 DEBRIEFING ROOM #2 160
FLOOR PLAN - AV ELECTRICAL
1/4" = 1'-0"

AV FLOOR PLAN FACILITIES NOTES:

116 80" FLAT PANEL DISPLAY - OFCI
126 FLOOR BOX - BY E.C.
172 AV CONNECTION PANEL - OFCI
190 WALL-MOUNTED CAMERA - OFCI

AV RCP FACILITIES NOTES:

246 CEILING-RECESSED LOUDSPEAKER - OFCI
270 WIRELESS ACCESS POINT - OFCI
280 CEILING MICROPHONE (BOUNDARY LAYER) - OFCI
290 CEILING CAMERA - OFCI

AV FLOOR PLAN ELECTRICAL NOTES:

316 80" FLAT PANEL DISPLAY
- (1) 1" EMT

326 FLOOR BOX
- (2) 1-1/4" EMT

372 AV CONNECTION PANEL (ROOM COMPUTER)
- (1) 1" EMT

390 WALL-MOUNTED CAMERA
- (1) 1" EMT

AV RCP ELECTRICAL NOTES:

446 CEILING-RECESSED LOUDSPEAKER
- (1) 3/4 EMT TO FIRST SPEAKER THEN,
- (1) 3/4 EMT BETWEEN LOUDSPEAKERS

470 WIRELESS ACCESS POINT
- (1) 3/4 EMT

480 CEILING MICROPHONE
- (1) 3/4" EMT

490 CEILING CAMERA
- (1) 1" EMT

GENERAL NOTES

1. REFER TO TELECOMMUNICATIONS DRAWINGS FOR PRIMARY CABLE PATHWAYS AND CABLE MANAGEMENT INFORMATION.
2. STUB ALL AV CONDUIT ABOVE FINISHED CEILING IN AN ACCESSIBLE LOCATION U.O.N. IF AN ACCESSIBLE LOCATION CAN NOT BE PROVIDED STUB CONDUIT TO NEAREST CABLE TRAY.
3. NON-CONTINUOUS CABLE SUPPORT IS REQUIRED FOR SECONDARY CABLE PATHWAYS ABOVE ACCESSIBLE CEILINGS.
4. ELECTRICAL AND TELECOMMUNICATION SYMBOLS SHOWN FOR INFORMATION AND COORDINATION ONLY.

KEY NOTES

LEGEND

PROJECT NORTH
TRUE NORTH

ISSUE FOR BID

Revisions		Date
2	ADDENDUM 2	05/16/2014
1	ADDENDUM 1	02/06/2014

CONSULTANTS:

SM&W
SHEN MILSOM WILKE
33 New Montgomery Street
San Francisco, CA 94105
Tel: 415-391-7610
Fax: 415-391-0171

Seals and Signatures

ARCHITECT/ENGINEERS:

CANNONDESIGN
201 Mission Street, Suite 2400, San Francisco, California 94105 415.243.4170
Baltimore ■ Boston ■ Buffalo ■ Calgary ■ Chicago
Houston ■ Los Angeles ■ Mumbai ■ New York ■ Phoenix
St. Louis ■ San Francisco ■ Shanghai ■ Toronto
Vancouver ■ Victoria ■ Washington DC

Drawing Title
AV SYSTEMS DEBRIEFING ROOM #2 160 ENLARGED PLANS

Approved: Project Director
Approver

Project Title
VA SIMULATION CENTER

Location
Veterans Affairs Palo Alto Heath Care System
3801 Miranda Ave,Palo Alto, CA 94304

Date: JUNE 14, 2013
Checked: SS
Drawn: RM

VA Project Number: 640-385
Building Number: 105
Drawing No. AV0303

VA PAHCS Veterans Affairs Palo Alto Health Care System
Department of Veterans Affairs

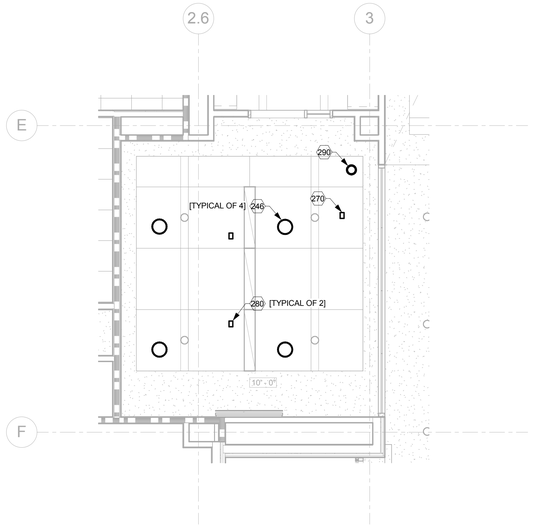

DEBRIEFING ROOM #3 174
REFLECTED CEILING PLAN - AV FACILITIES
2 1/4" = 1'-0"

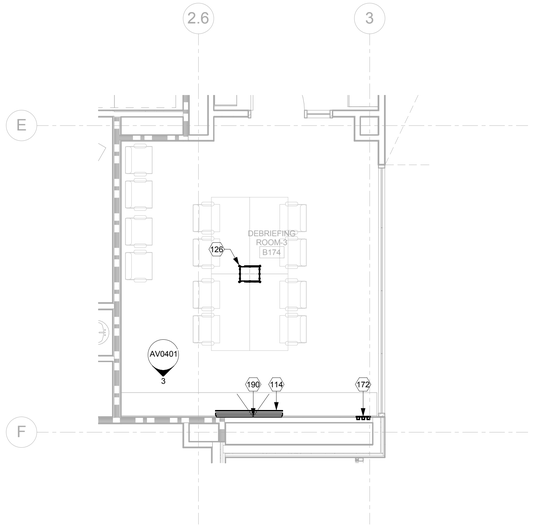

DEBRIEFING ROOM #3 174
FLOOR PLAN - AV FACILITIES
1 1/4" = 1'-0"

AV FLOOR PLAN FACILITIES NOTES:

114 60" FLAT PANEL DISPLAY - OFCI
126 FLOOR BOX - BY E.C. (2)
172 AV CONNECTION PANEL - OFCI
190 WALL-MOUNTED CAMERA - OFCI

AV RCP FACILITIES NOTES:

246 CEILING-RECESSED LOUDSPEAKER - OFCI
270 WIRELESS ACCESS POINT - OFCI
280 CEILING MICROPHONE (BOUNDARY LAYER) - OFCI
290 CEILING CAMERA - OFCI

AV FLOOR PLAN ELECTRICAL NOTES:

314 60" FLAT PANEL DISPLAY
- (1) 1" EMT

326 FLOOR BOX
- (2) 1-1/4" EMT

372 AV CONNECTION PANEL
- (1) 1" EMT

390 WALL-MOUNTED CAMERA
- (1) 1" EMT

AV RCP ELECTRICAL NOTES:

446 CEILING-RECESSED LOUDSPEAKER
- (1) 3/4 EMT TO FIRST SPEAKER THEN,
- (1) 3/4 EMT BETWEEN LOUDSPEAKERS

470 WIRELESS ACCESS POINT
- (1) 3/4" EMT

480 CEILING MICROPHONE
- (1) 3/4" EMT

490 CEILING CAMERA
- (1) 1" EMT

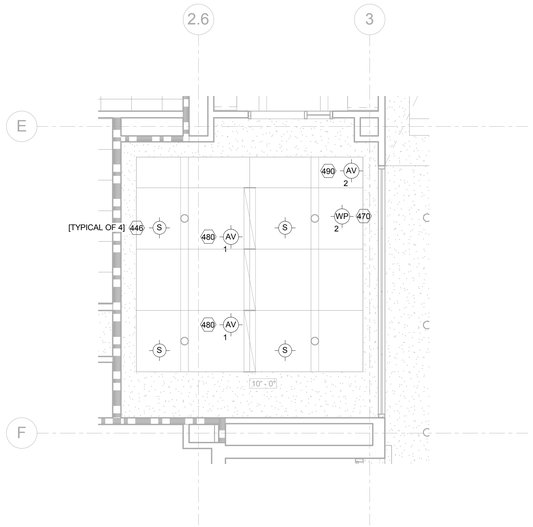

DEBRIEFING ROOM #3 174
REFLECTED CEILING PLAN - AV ELECTRICAL
4 1/4" = 1'-0"

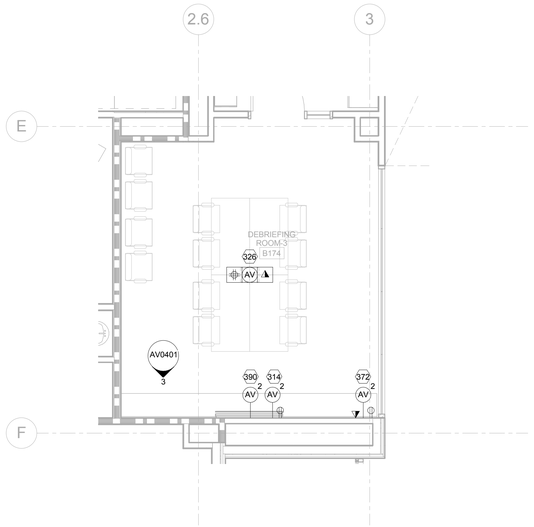

DEBRIEFING ROOM #3 174
FLOOR PLAN - AV ELECTRICAL
3 1/4" = 1'-0"

GENERAL NOTES

1. REFER TO TELECOMMUNICATIONS DRAWINGS FOR PRIMARY CABLE PATHWAYS AND CABLE MANAGEMENT INFORMATION.
2. STUB ALL AV CONDUIT ABOVE FINISHED CEILING IN AN ACCESSIBLE LOCATION U.O.N. IF AN ACCESSIBLE LOCATION CAN NOT BE PROVIDED STUB CONDUIT TO NEAREST CABLE TRAY.
3. NON-CONTINUOUS CABLE SUPPORT IS REQUIRED FOR SECONDARY CABLE PATHWAYS ABOVE ACCESSIBLE CEILINGS.
4. ELECTRICAL AND TELECOMMUNICATION SYMBOLS SHOWN FOR INFORMATION AND COORDINATION ONLY.

KEY NOTES

LEGEND

PROJECT NORTH
TRUE NORTH

ISSUE FOR BID

Revisions		Date
2	ADDENDUM 2	05/16/2014
1	ADDENDUM 1	02/06/2014

CONSULTANTS:

SHEN MILSOM WILKE
33 New Montgomery Street
San Francisco, CA 94105
Tel: 415-391-7610
Fax: 415-391-0171

Seals and Signatures

ARCHITECT/ENGINEERS:

CANNONDESIGN
201 Mission Street, Suite 2400, San Francisco, California 94105 415.243.4170
Baltimore ■ Boston ■ Buffalo ■ Calgary ■ Chicago
Houston ■ Los Angeles ■ Mumbai ■ New York ■ Phoenix
St. Louis ■ San Francisco ■ Shanghai ■ Toronto
Vancouver ■ Victoria ■ Washington DC

Drawing Title
AV SYSTEMS DEBRIEFING ROOM #3 174 ENLARGED PLANS

Approved: Project Director
Approver

Project Title
VA SIMULATION CENTER

Location
Veterans Affairs Palo Alto Heath Care System
3801 Miranda Ave,Palo Alto, CA 94304

Date JUNE 14, 2013 | Checked SS | Drawn RM

VA Project Number: 640-385
Building Number: 105
Drawing No. AV0304

VA PAHCS Veterans Affairs Palo Alto Health Care System
Department of Veterans Affairs

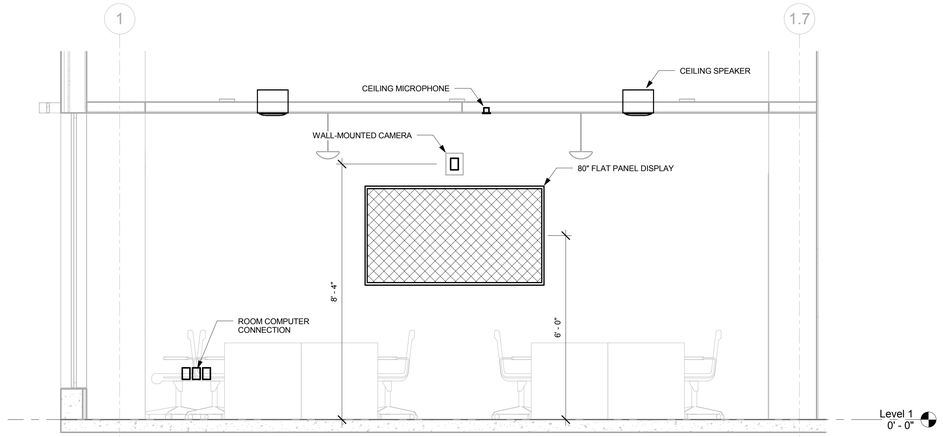

2 DEBRIEFING ROOM #2 160
FRONT WALL ELEVATION
1/2" = 1'-0"

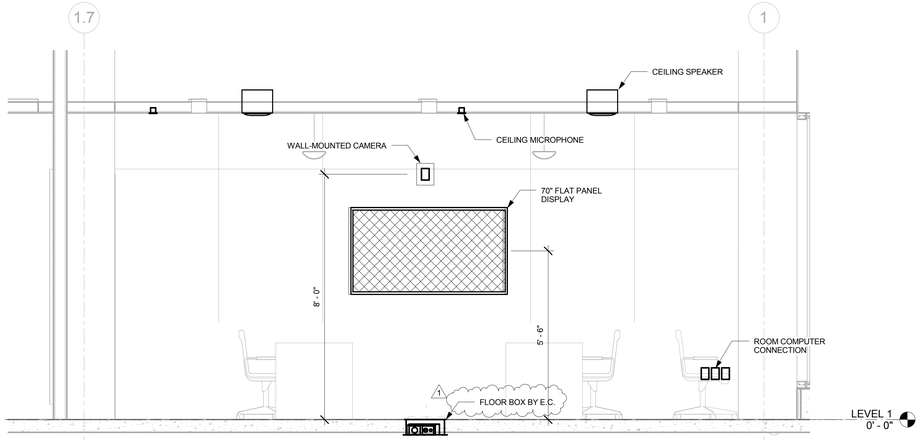

1 DEBRIEFING ROOM #1 151
FRONT WALL ELEVATION
1/2" = 1'-0"

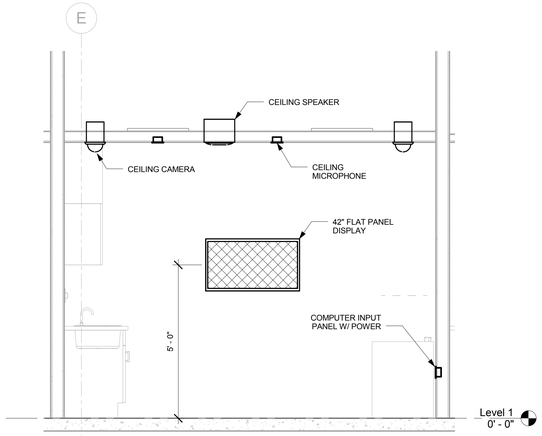

4 CLINIC ROOM 173
FRONT WALL ELEVATION
1/2" = 1'-0"

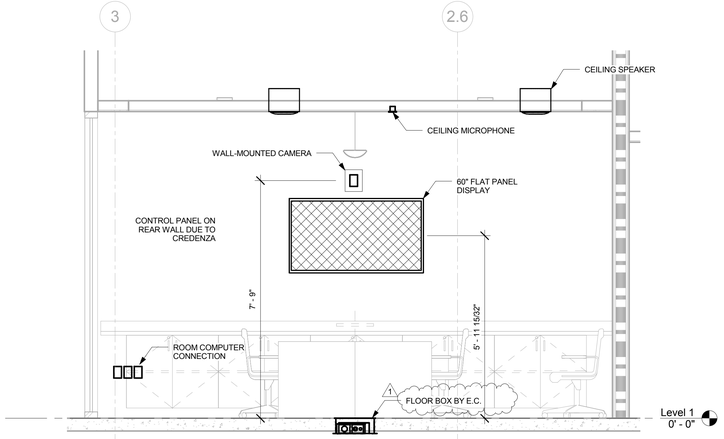

3 DEBRIEFING ROOM #3 174
FRONT WALL ELEVATION
1/2" = 1'-0"

GENERAL NOTES

KEY NOTES

LEGEND

ISSUE FOR BID

1	ADDENDUM 2	05/16/2014
Revisions		Date

CONSULTANTS:

SHEN MILSOM WILKE
33 New Montgomery Street
San Francisco, CA 94105
Tel: 415-391-7610
Fax: 415-391-0171

Seals and Signatures

ARCHITECT/ENGINEERS:

CANNONDESIGN
201 Mission Street, Suite 2400, San Francisco, California 94105 415.243.4170
Baltimore ■ Boston ■ Buffalo ■ Calgary ■ Chicago
Houston ■ Los Angeles ■ Mumbai ■ New York ■ Phoenix
St. Louis ■ San Francisco ■ Shanghai ■ Toronto
Vancouver ■ Victoria ■ Washington DC

Drawing Title: AV SYSTEMS ELEVATIONS

Approved: Project Director
Approver

Project Title: VA SIMULATION CENTER

Location: Veterans Affairs Palo Alto Heath Care System
3801 Miranda Ave,Palo Alto, CA 94304

Date: JUNE 14, 2013 | Checked: SS | Drawn: RM

VA Project Number: 640-385
Building Number: 105
Drawing No. AV0401

VA PAHCS Veterans Affairs Palo Alto Health Care System
Department of Veterans Affairs

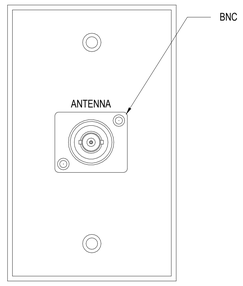

3 CPT–3
CUSTOM PLATE DETAIL
SCALE: 1"=1"

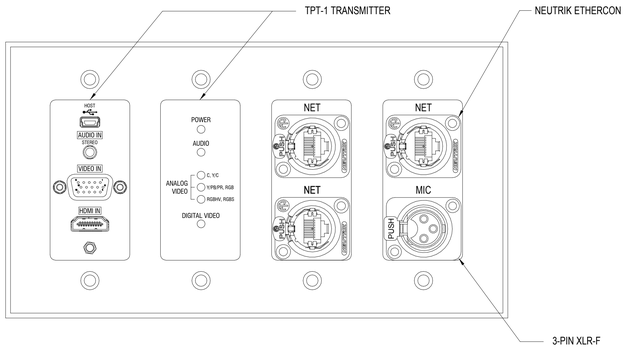

2 CPT–2
CUSTOM PLATE DETAIL
SCALE: 1"=1"

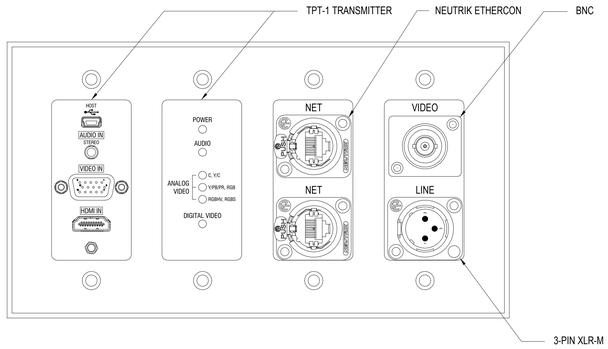

1 CPT–1
CUSTOM PLATE DETAIL
SCALE: 1"=1"

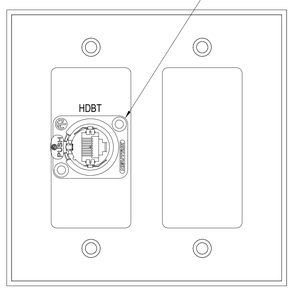

6 CPT–6
CUSTOM PLATE DETAIL
SCALE: 1"=1"

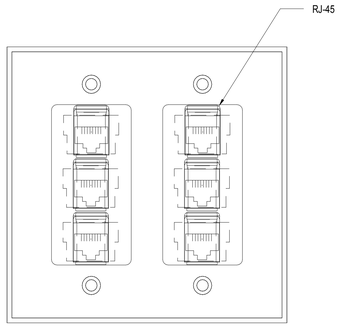

5 CPT–5
CUSTOM PLATE DETAIL
SCALE: 1"=1"

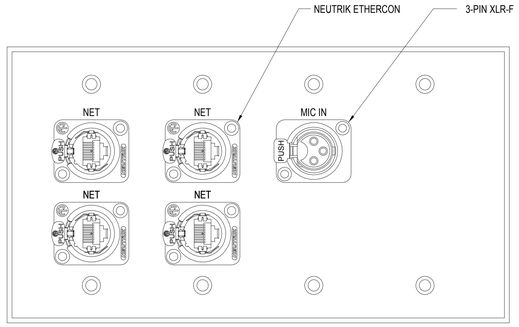

4 CPT–4
CUSTOM PLATE DETAIL
SCALE: 1"=1"

2

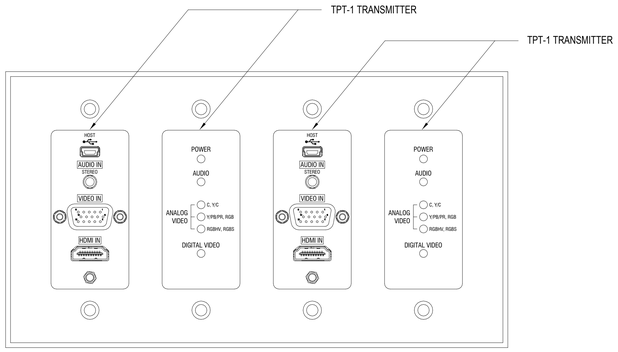

8 CPT–8
CUSTOM PLATE DETAIL
SCALE: 1"=1"

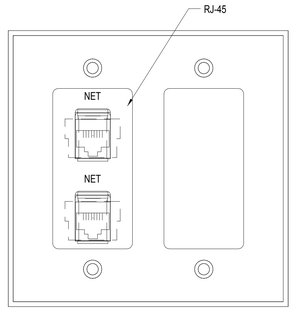

7 CPT–7
CUSTOM PLATE DETAIL
SCALE: 1"=1"

NOTE:
ALL HARDWARE COMPONENTS INDICATED ON THIS SHEET SHALL BE OWNER FURNISHED CONTRACTOR INSTALLED (OFCI)

GENERAL NOTES

KEY NOTES

LEGEND

ISSUE FOR BID

Revisions		Date
2	ADDENDUM 2	05/16/2014
1	ADDENDUM 1	02/06/2014

CONSULTANTS:

SM&W
SHEN MILSOM WILKE
33 New Montgomery Street
San Francisco, CA 94105
Tel: 415-391-7610
Fax: 415-391-0171

Seals and Signatures

ARCHITECT/ENGINEERS:

CANNONDESIGN
201 Mission Street, Suite 2400, San Francisco, California 94105 415.243.4170
Baltimore ■ Boston ■ Buffalo ■ Calgary ■ Chicago
Houston ■ Los Angeles ■ Mumbai ■ New York ■ Phoenix
St. Louis ■ San Francisco ■ Shanghai ■ Toronto
Vancouver ■ Victoria ■ Washington DC

Drawing Title: AV SYSTEMS DETAILS

Approved: Project Director
Approver

Project Title: VA SIMULATION CENTER

Location: Veterans Affairs Palo Alto Heath Care System, 3801 Miranda Ave,Palo Alto, CA 94304

Date: JUNE 14, 2013 | Checked: SS | Drawn: RM

VA Project Number: 640-385
Building Number: 105
Drawing No. AV0500

VA PAHCS Veterans Affairs Palo Alto Health Care System
Department of Veterans Affairs

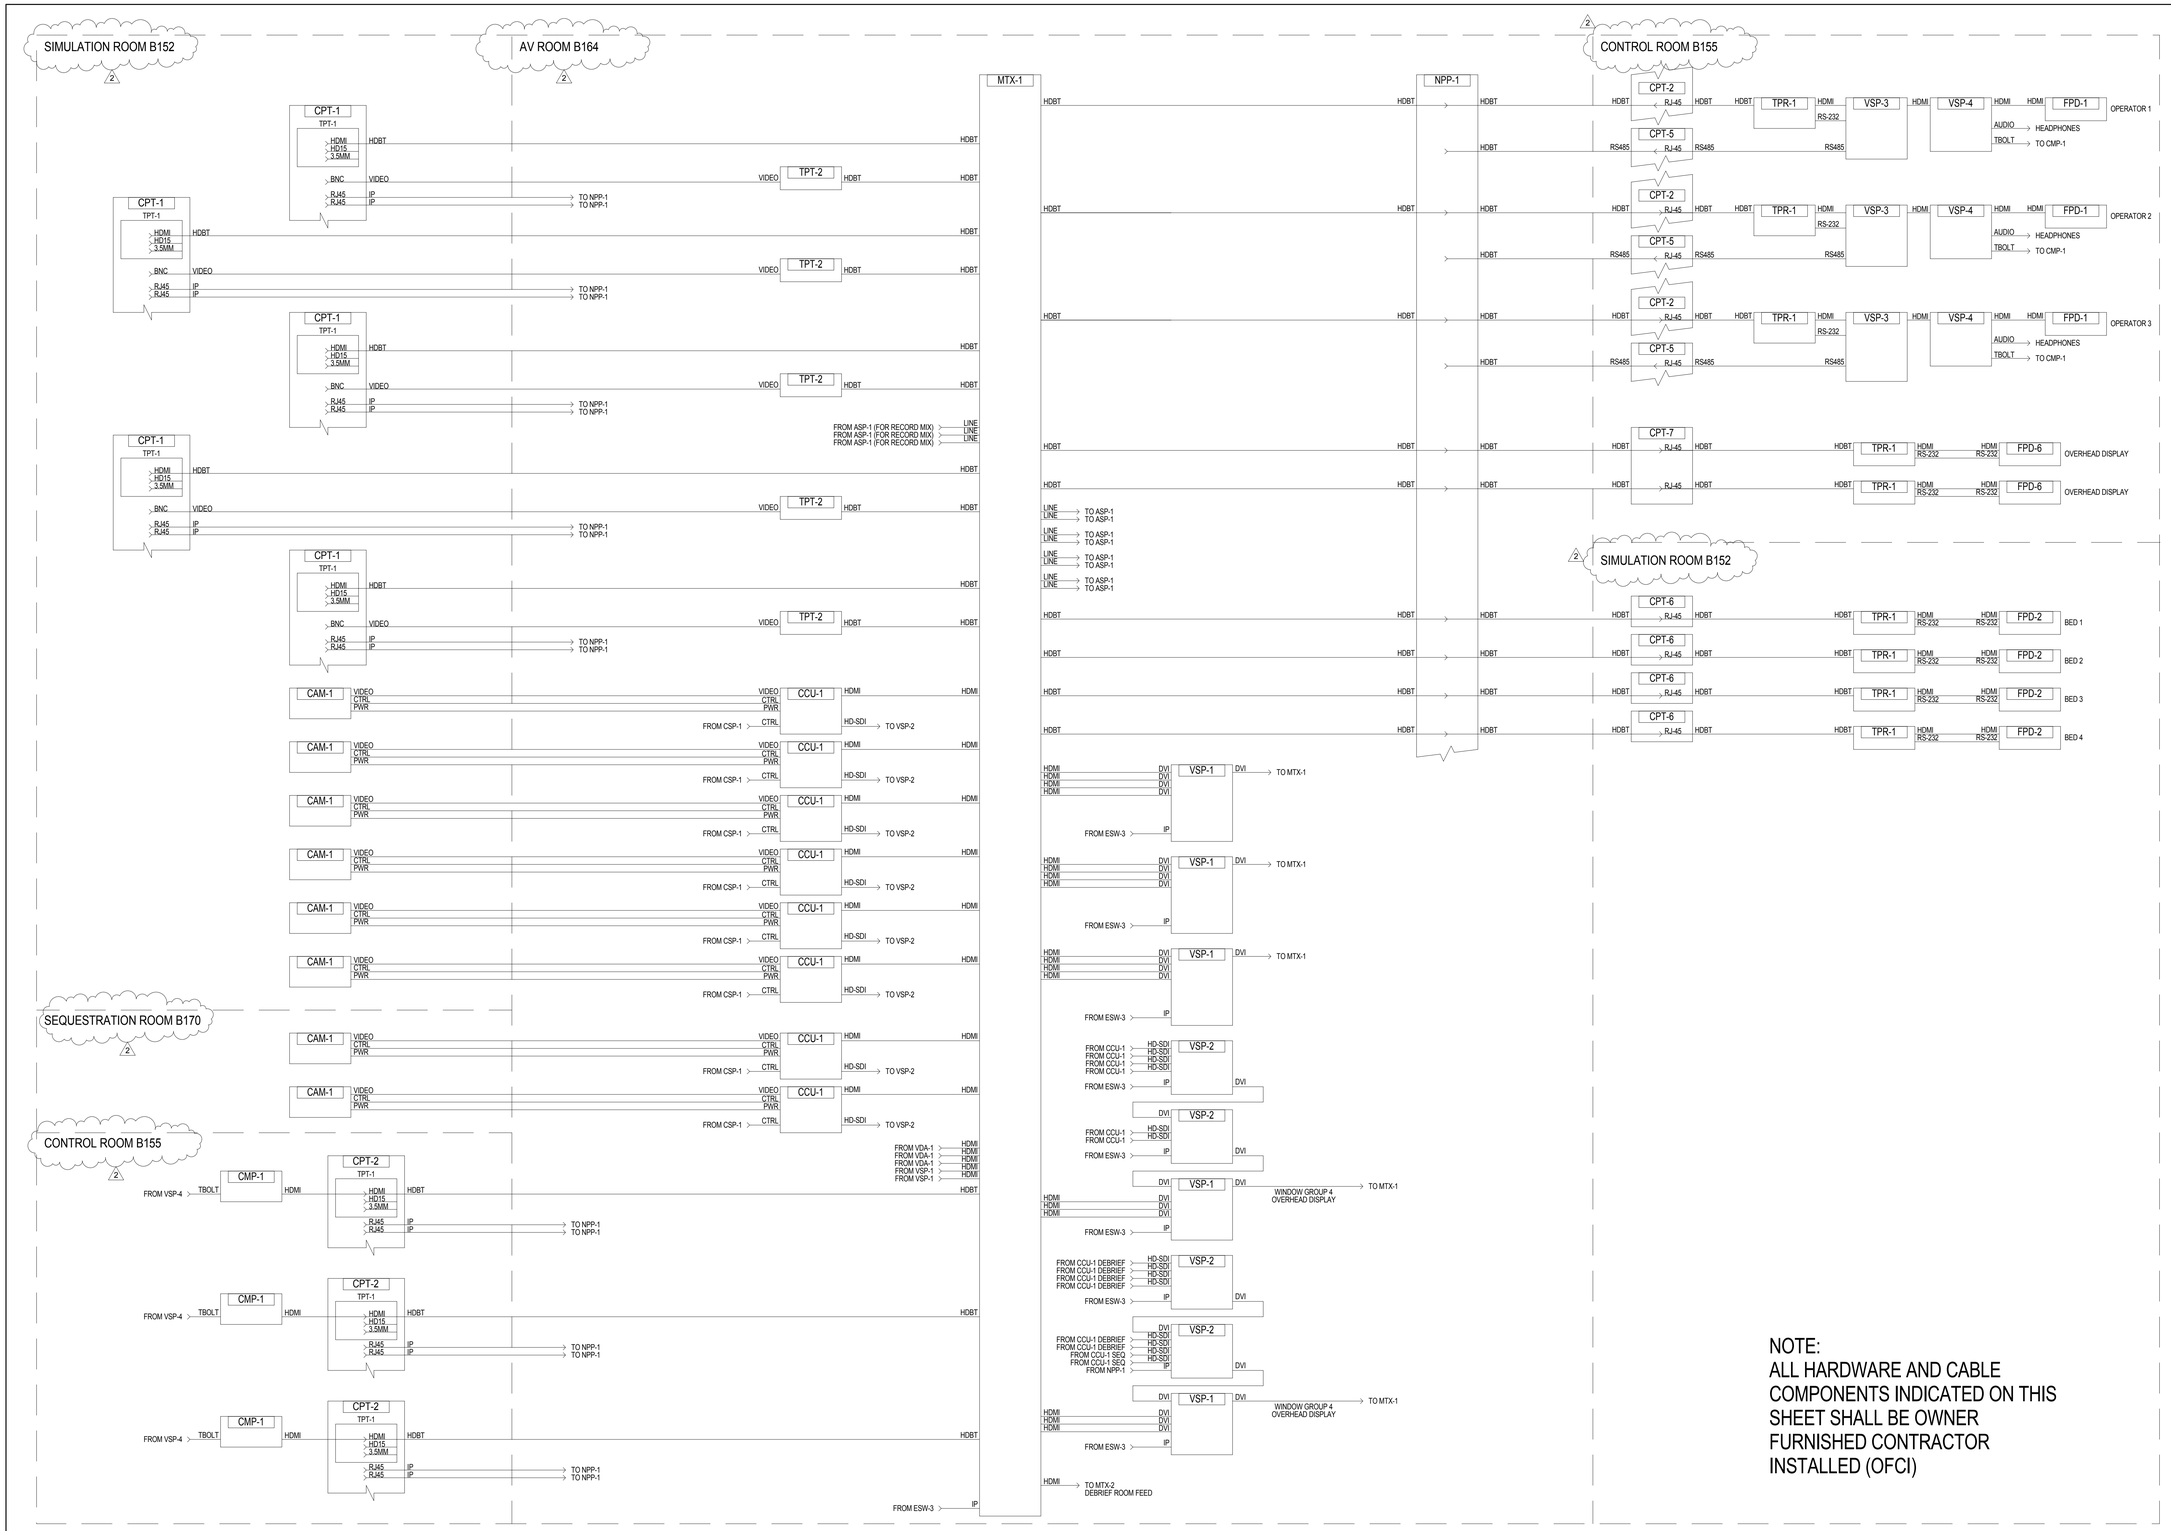

NOTE:
ALL HARDWARE AND CABLE COMPONENTS INDICATED ON THIS SHEET SHALL BE OWNER FURNISHED CONTRACTOR INSTALLED (OFCI)

GENERAL NOTES

KEY NOTES

LEGEND

ISSUE FOR BID

Revisions		Date
2	ADDENDUM 2	05/16/2014
1	ADDENDUM 1	02/06/2014

CONSULTANTS:

SHEN MILSOM WILKE
33 New Montgomery Street
San Francisco, CA 94105
Tel: 415-391-7610
Fax: 415-391-0171

Seals and Signatures

ARCHITECT/ENGINEERS:

CANNONDESIGN
201 Mission Street, Suite 2400, San Francisco, California 94105 415.243.4170
Baltimore ■ Boston ■ Buffalo ■ Calgary ■ Chicago
Houston ■ Los Angeles ■ Mumbai ■ New York ■ Phoenix
St. Louis ■ San Francisco ■ Shanghai ■ Toronto
Vancouver ■ Victoria ■ Washington DC

Drawing Title: AV SYSTEMS LARGE SIMULATION ROOM VIDEO FUNCTIONAL DIAGRAM

Project Title: VA SIMULATION CENTER

VA Project Number: 640-385

Building Number: 105

Approved: Project Director
Approver

Location: Veterans Affairs Palo Alto Heath Care System, 3801 Miranda Ave,Palo Alto, CA 94304

Date: JUNE 14, 2013 | Checked: SS | Drawn: RM

Drawing No. AV0600

VA PAHCS Veterans Affairs Palo Alto Health Care System

Department of Veterans Affairs

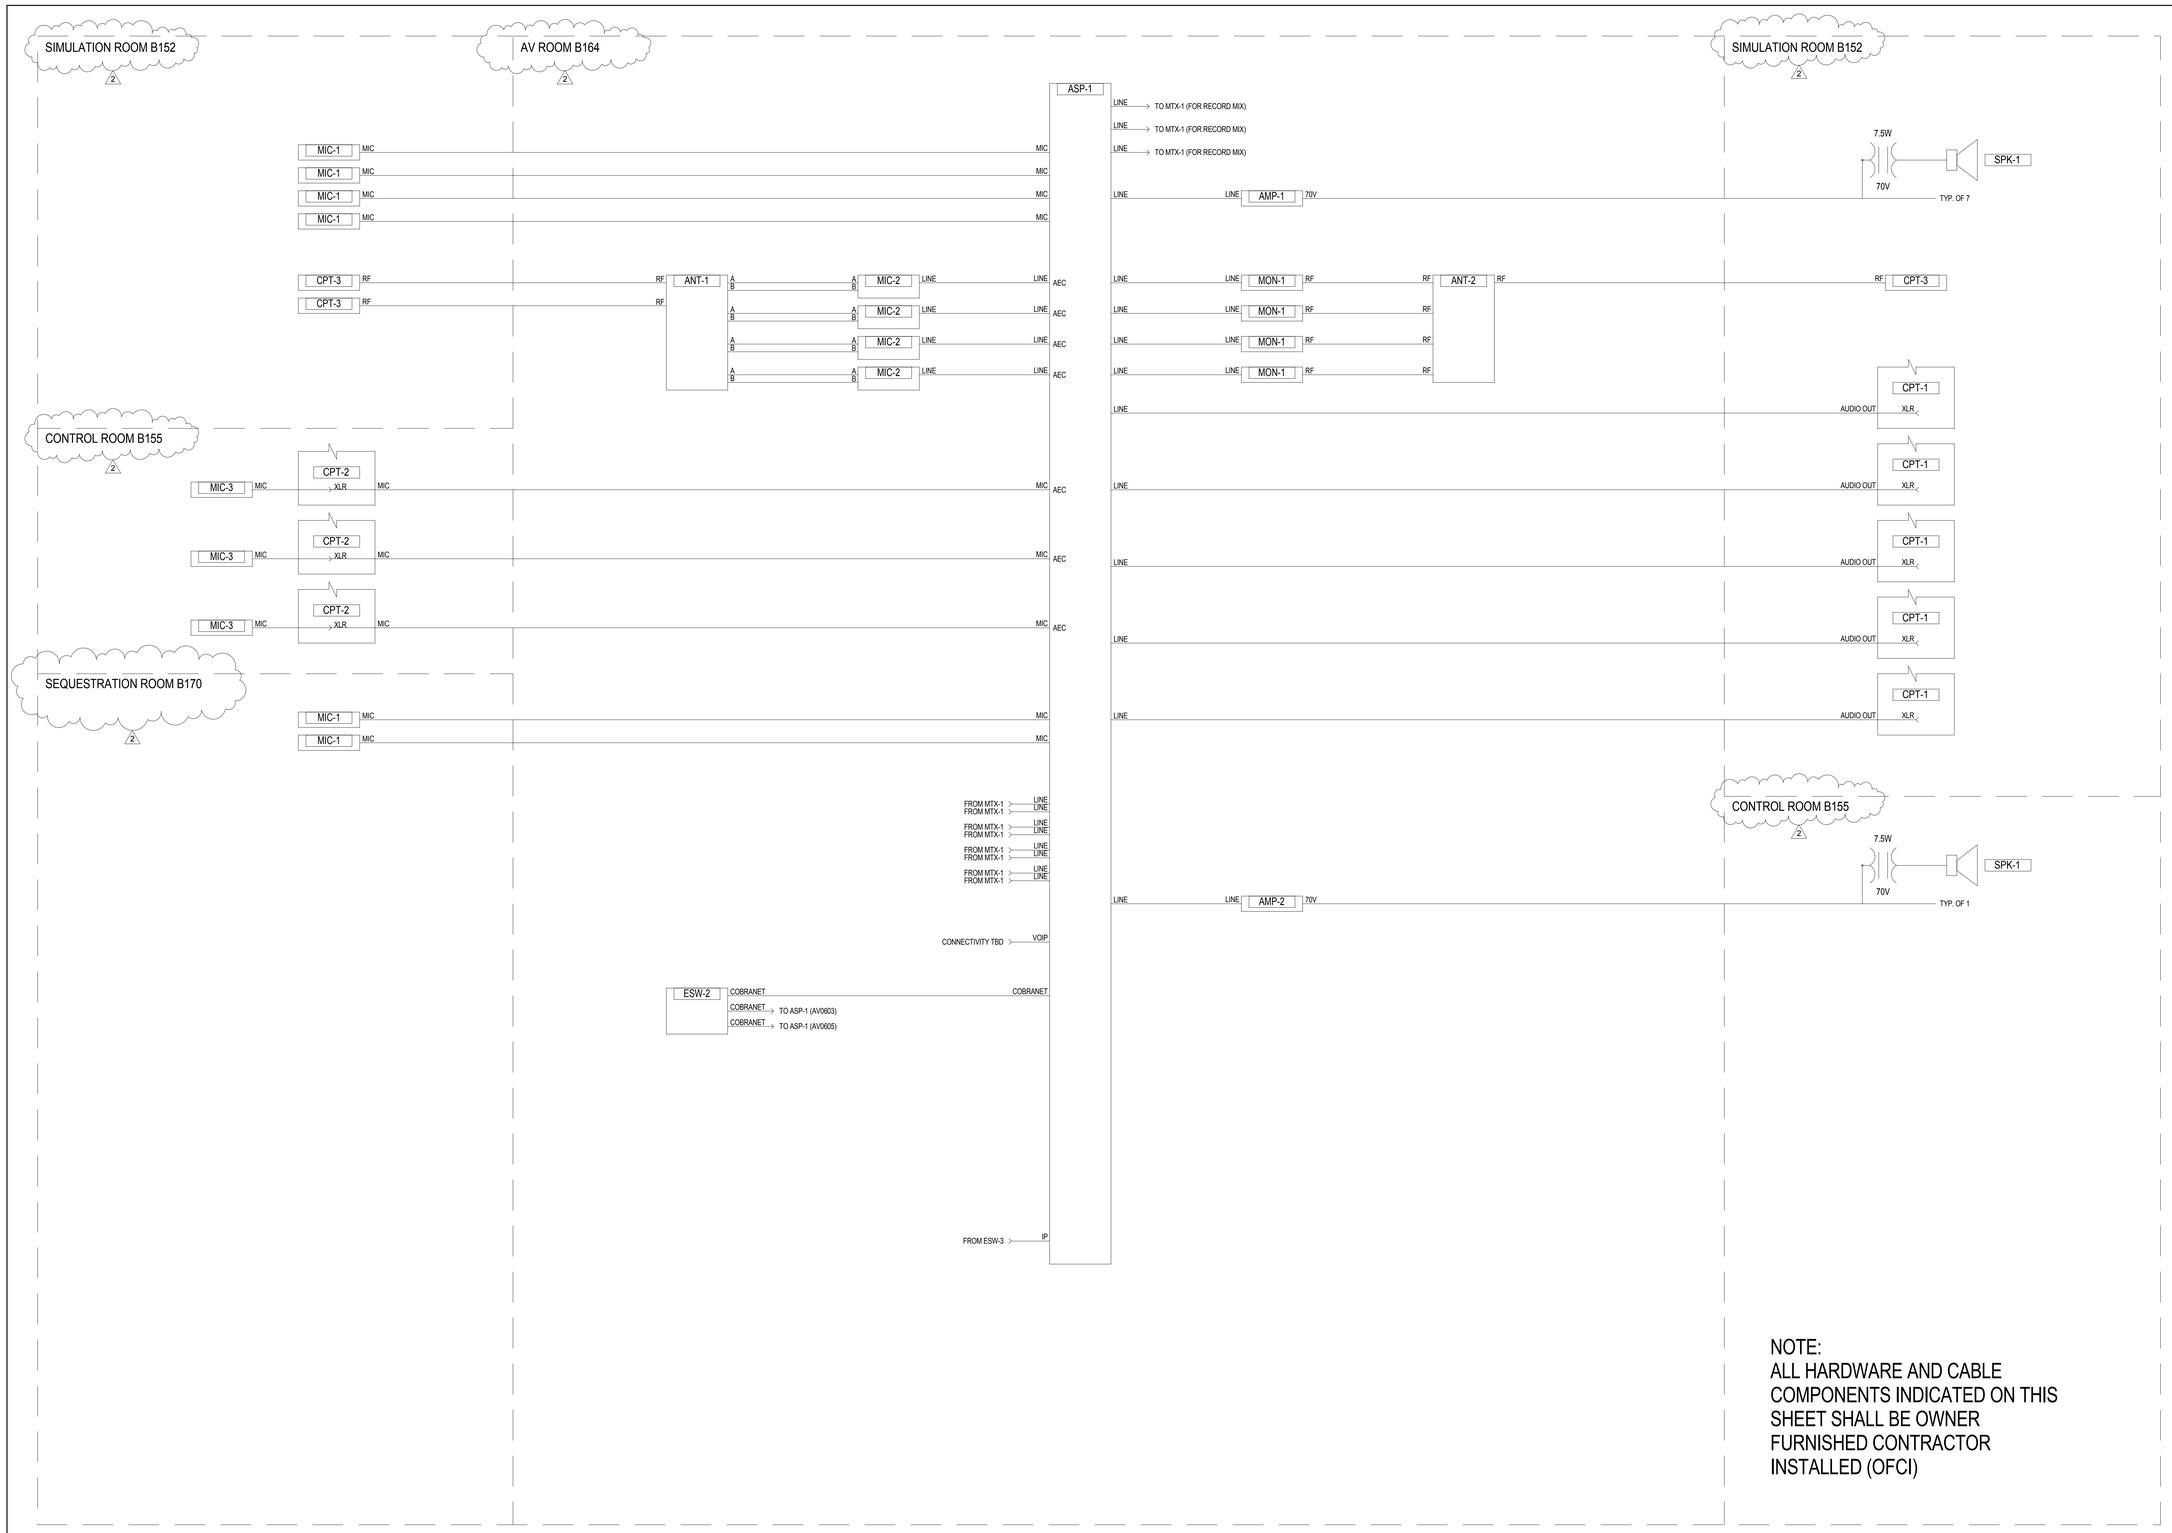

NOTE:
ALL HARDWARE AND CABLE COMPONENTS INDICATED ON THIS SHEET SHALL BE OWNER FURNISHED CONTRACTOR INSTALLED (OFCI)

GENERAL NOTES

KEY NOTES

LEGEND

ISSUE FOR BID

Revisions		Date
2	ADDENDUM 2	05/16/2014
1	ADDENDUM 1	02/06/2014

CONSULTANTS:

SM&W
SHEN MILSOM WILKE
33 New Montgomery Street
San Francisco, CA 94105
Tel: 415-391-7610
Fax: 415-391-0171

Seals and Signatures

ARCHITECT/ENGINEERS:

CANNONDESIGN
201 Mission Street, Suite 2400, San Francisco, California 94105 415.243.4170
Baltimore ■ Boston ■ Buffalo ■ Calgary ■ Chicago
Houston ■ Los Angeles ■ Mumbai ■ New York ■ Phoenix
St. Louis ■ San Francisco ■ Shanghai ■ Toronto
Vancouver ■ Victoria ■ Washington DC

Drawing Title
AV SYSTEMS LARGE SIMULATION ROOM AUDIO FUNCTIONAL DIAGRAM

Approved: Project Director
Approver

Project Title
VA SIMULATION CENTER

Location
Veterans Affairs Palo Alto Heath Care System
3801 Miranda Ave,Palo Alto, CA 94304

Date: JUNE 14, 2013
Checked: SS
Drawn: RM

VA Project Number: 640-385
Building Number: 105
Drawing No. AV0601

VA PAHCS Veterans Affairs Palo Alto Health Care System
Department of Veterans Affairs

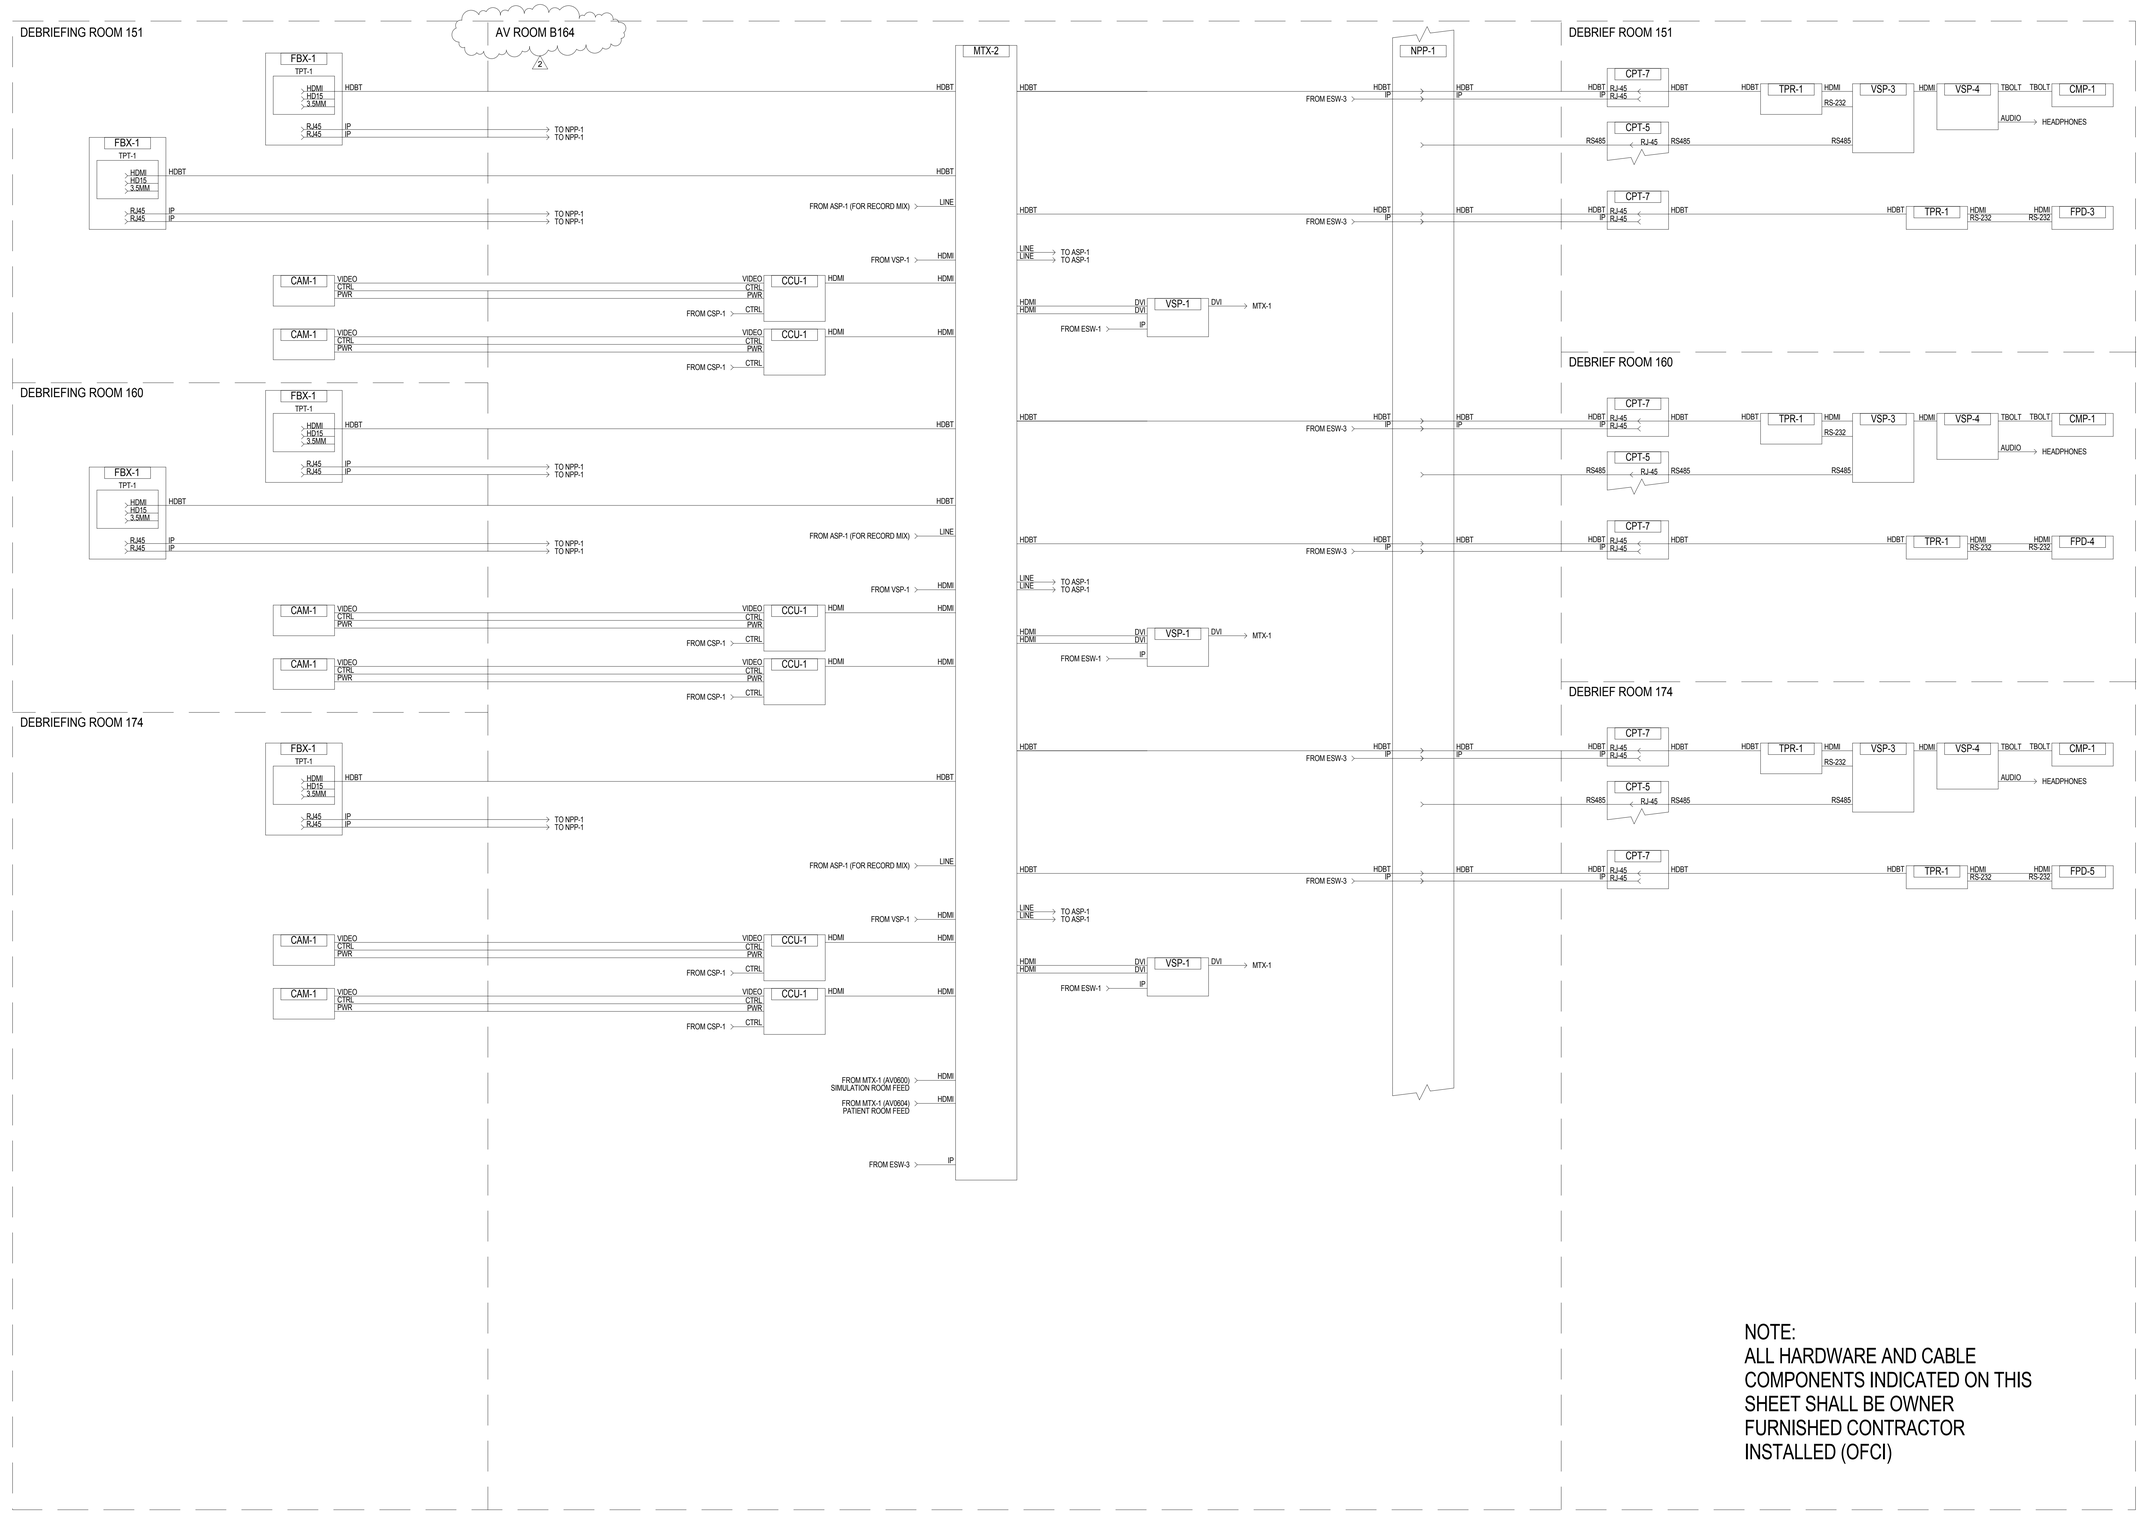

NOTE:
ALL HARDWARE AND CABLE COMPONENTS INDICATED ON THIS SHEET SHALL BE OWNER FURNISHED CONTRACTOR INSTALLED (OFCI)

GENERAL NOTES

KEY NOTES

LEGEND

ISSUE FOR BID

Revisions		Date
2	ADDENDUM 2	05/16/2014
1	ADDENDUM 1	02/06/2014

CONSULTANTS:

SHEN MILSOM WILKE
33 New Montgomery Street
San Francisco, CA 94105
Tel: 415-391-7610
Fax: 415-391-0171

Seals and Signatures

ARCHITECT/ENGINEERS:

CANNONDESIGN
201 Mission Street, Suite 2400, San Francisco, California 94105 415.243.4170
Baltimore ■ Boston ■ Buffalo ■ Calgary ■ Chicago
Houston ■ Los Angeles ■ Mumbai ■ New York ■ Phoenix
St. Louis ■ San Francisco ■ Shanghai ■ Toronto
Vancouver ■ Victoria ■ Washington DC

Drawing Title
AV SYSTEMS DEBRIEFING ROOMS VIDEO FUNCTIONAL DIAGRAM

Approved: Project Director
Approver

Project Title
VA SIMULATION CENTER

Location
Veterans Affairs Palo Alto Heath Care System
3801 Miranda Ave,Palo Alto, CA 94304

Date: JUNE 14, 2013
Checked: SS
Drawn: RM

VA Project Number: 640-385
Building Number: 105
Drawing No. AV0602

VA PAHCS Veterans Affairs Palo Alto Health Care System
Department of Veterans Affairs

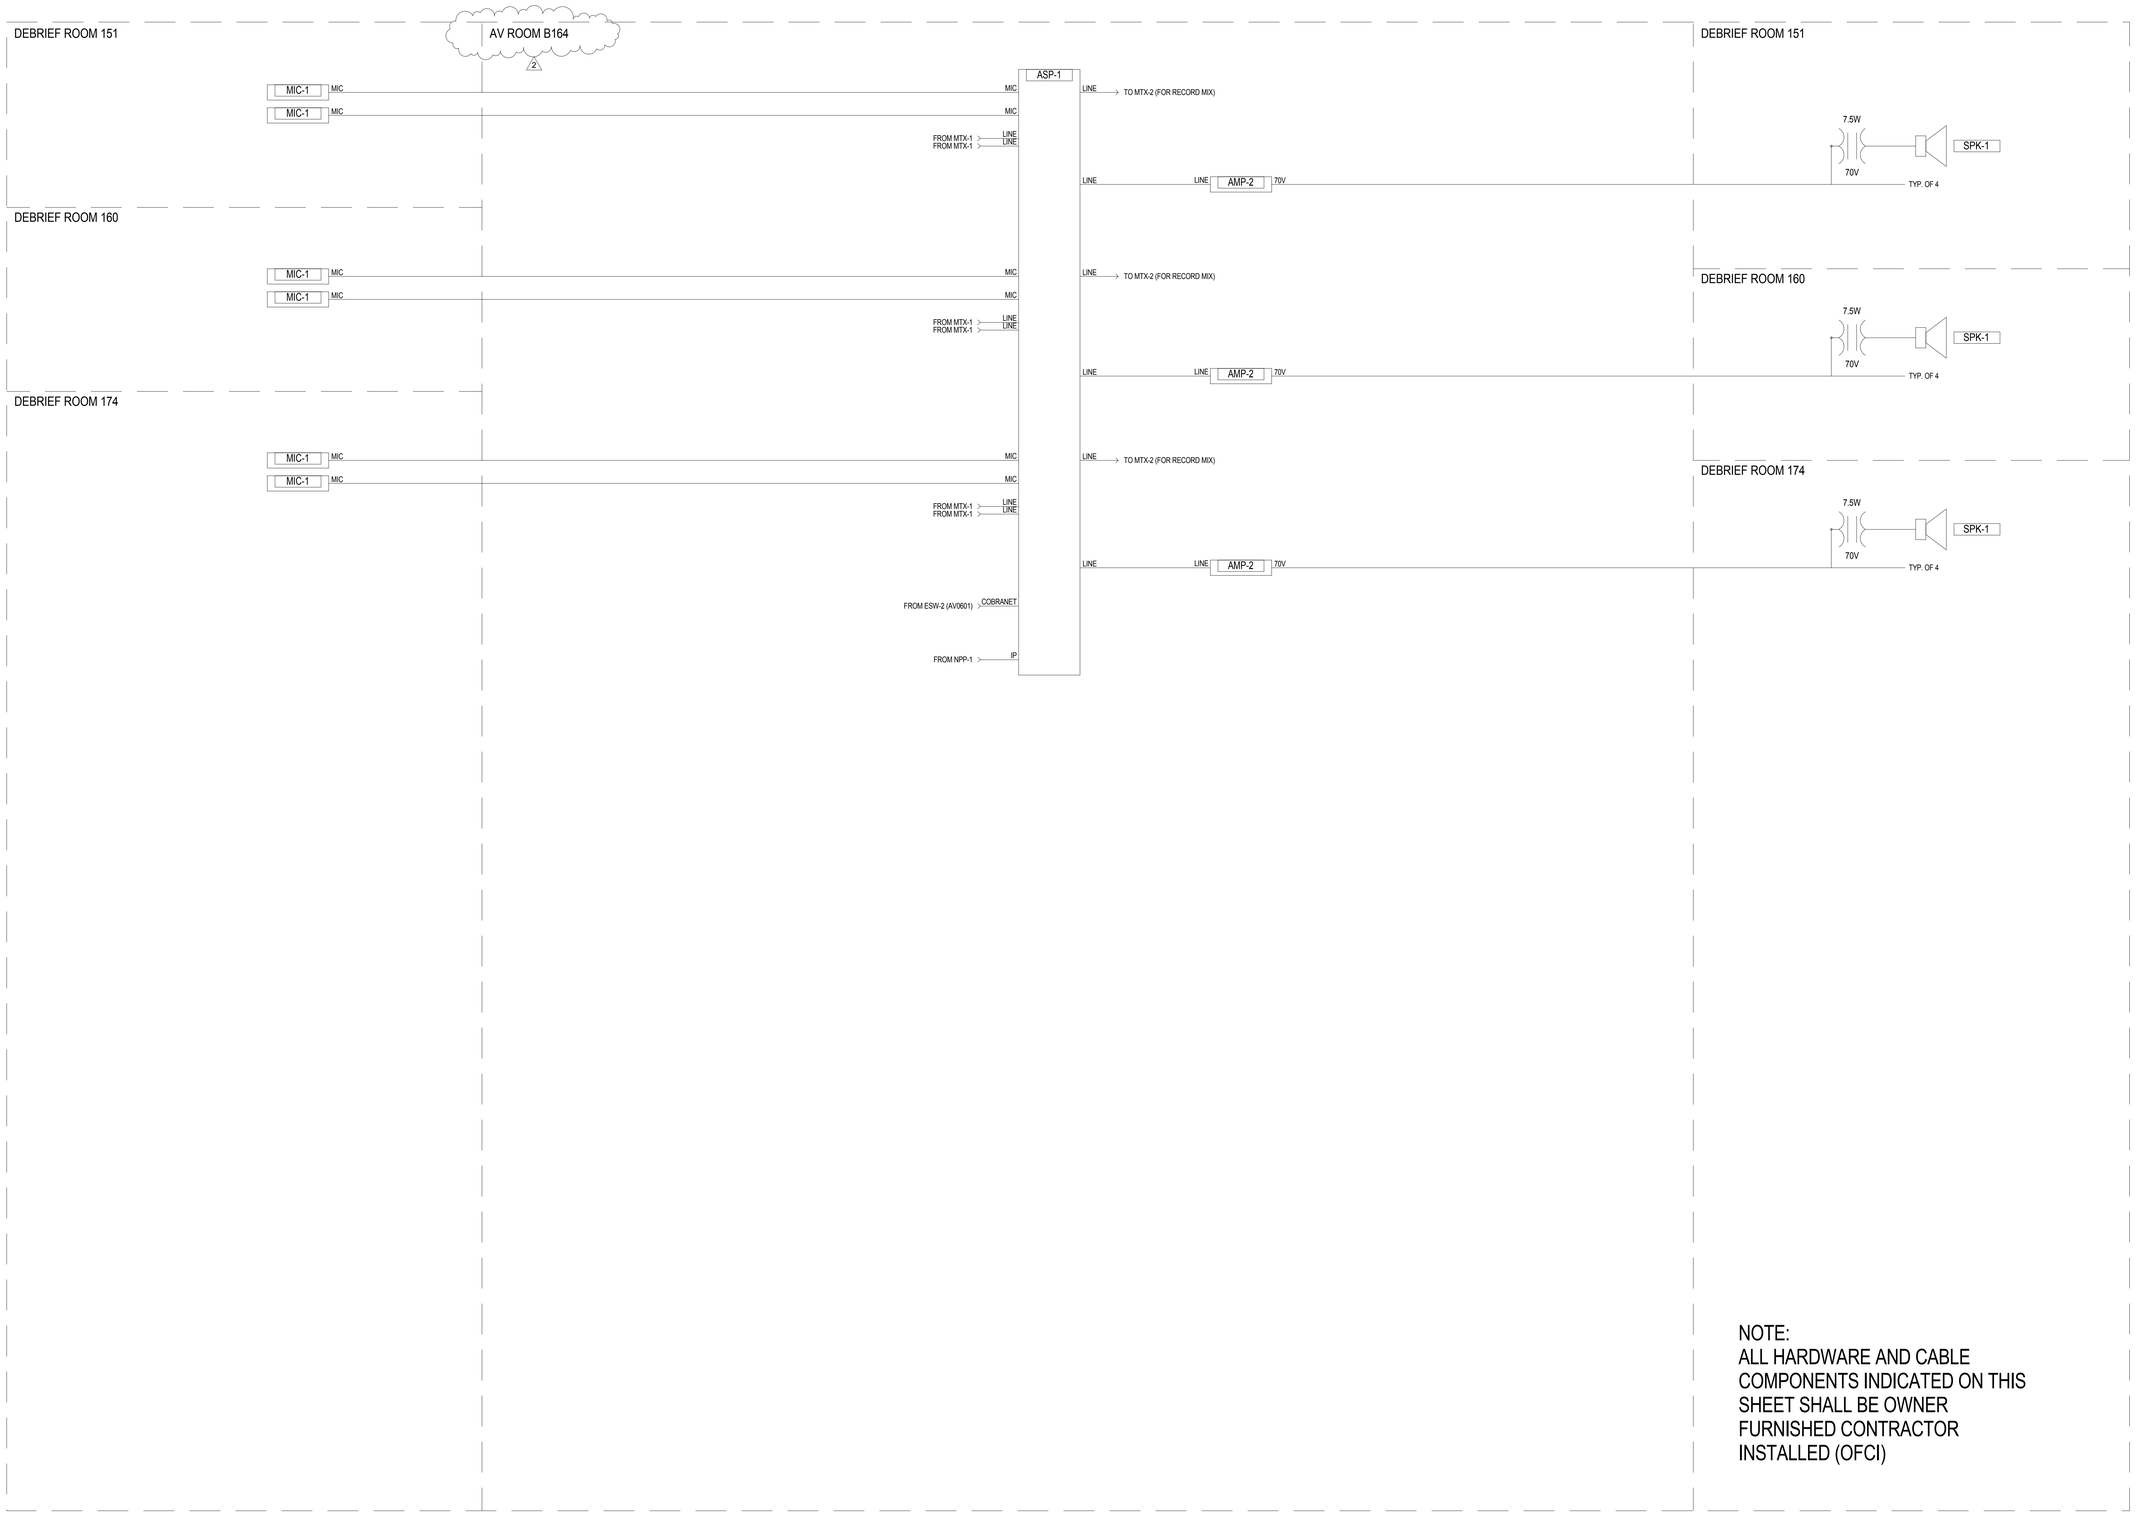

NOTE:
ALL HARDWARE AND CABLE COMPONENTS INDICATED ON THIS SHEET SHALL BE OWNER FURNISHED CONTRACTOR INSTALLED (OFCI)

GENERAL NOTES

KEY NOTES

LEGEND

ISSUE FOR BID

Revisions		Date
2	ADDENDUM 2	05/16/2014
1	ADDENDUM 1	02/06/2014

CONSULTANTS:

SM&W
SHEN MILSOM WILKE
33 New Montgomery Street
San Francisco, CA 94105
Tel: 415-391-7610
Fax: 415-391-0171

Seals and Signatures

ARCHITECT/ENGINEERS:

CANNONDESIGN
201 Mission Street, Suite 2400, San Francisco, California 94105 415.243.4170
Baltimore ■ Boston ■ Buffalo ■ Calgary ■ Chicago
Houston ■ Los Angeles ■ Mumbai ■ New York ■ Phoenix
St. Louis ■ San Francisco ■ Shanghai ■ Toronto
Vancouver ■ Victoria ■ Washington DC

Drawing Title
AV SYSTEMS DEBRIEFING ROOMS AUDIO FUNCTIONAL DIAGRAM

Approved: Project Director
Approver

Project Title
VA SIMULATION CENTER

Location
Veterans Affairs Palo Alto Heath Care System
3801 Miranda Ave,Palo Alto, CA 94304

Date: JUNE 14, 2013
Checked: SS
Drawn: RM

VA Project Number: 640-385
Building Number: 105
Drawing No. AV0603

VA PAHCS Veterans Affairs Palo Alto Health Care System
Department of Veterans Affairs

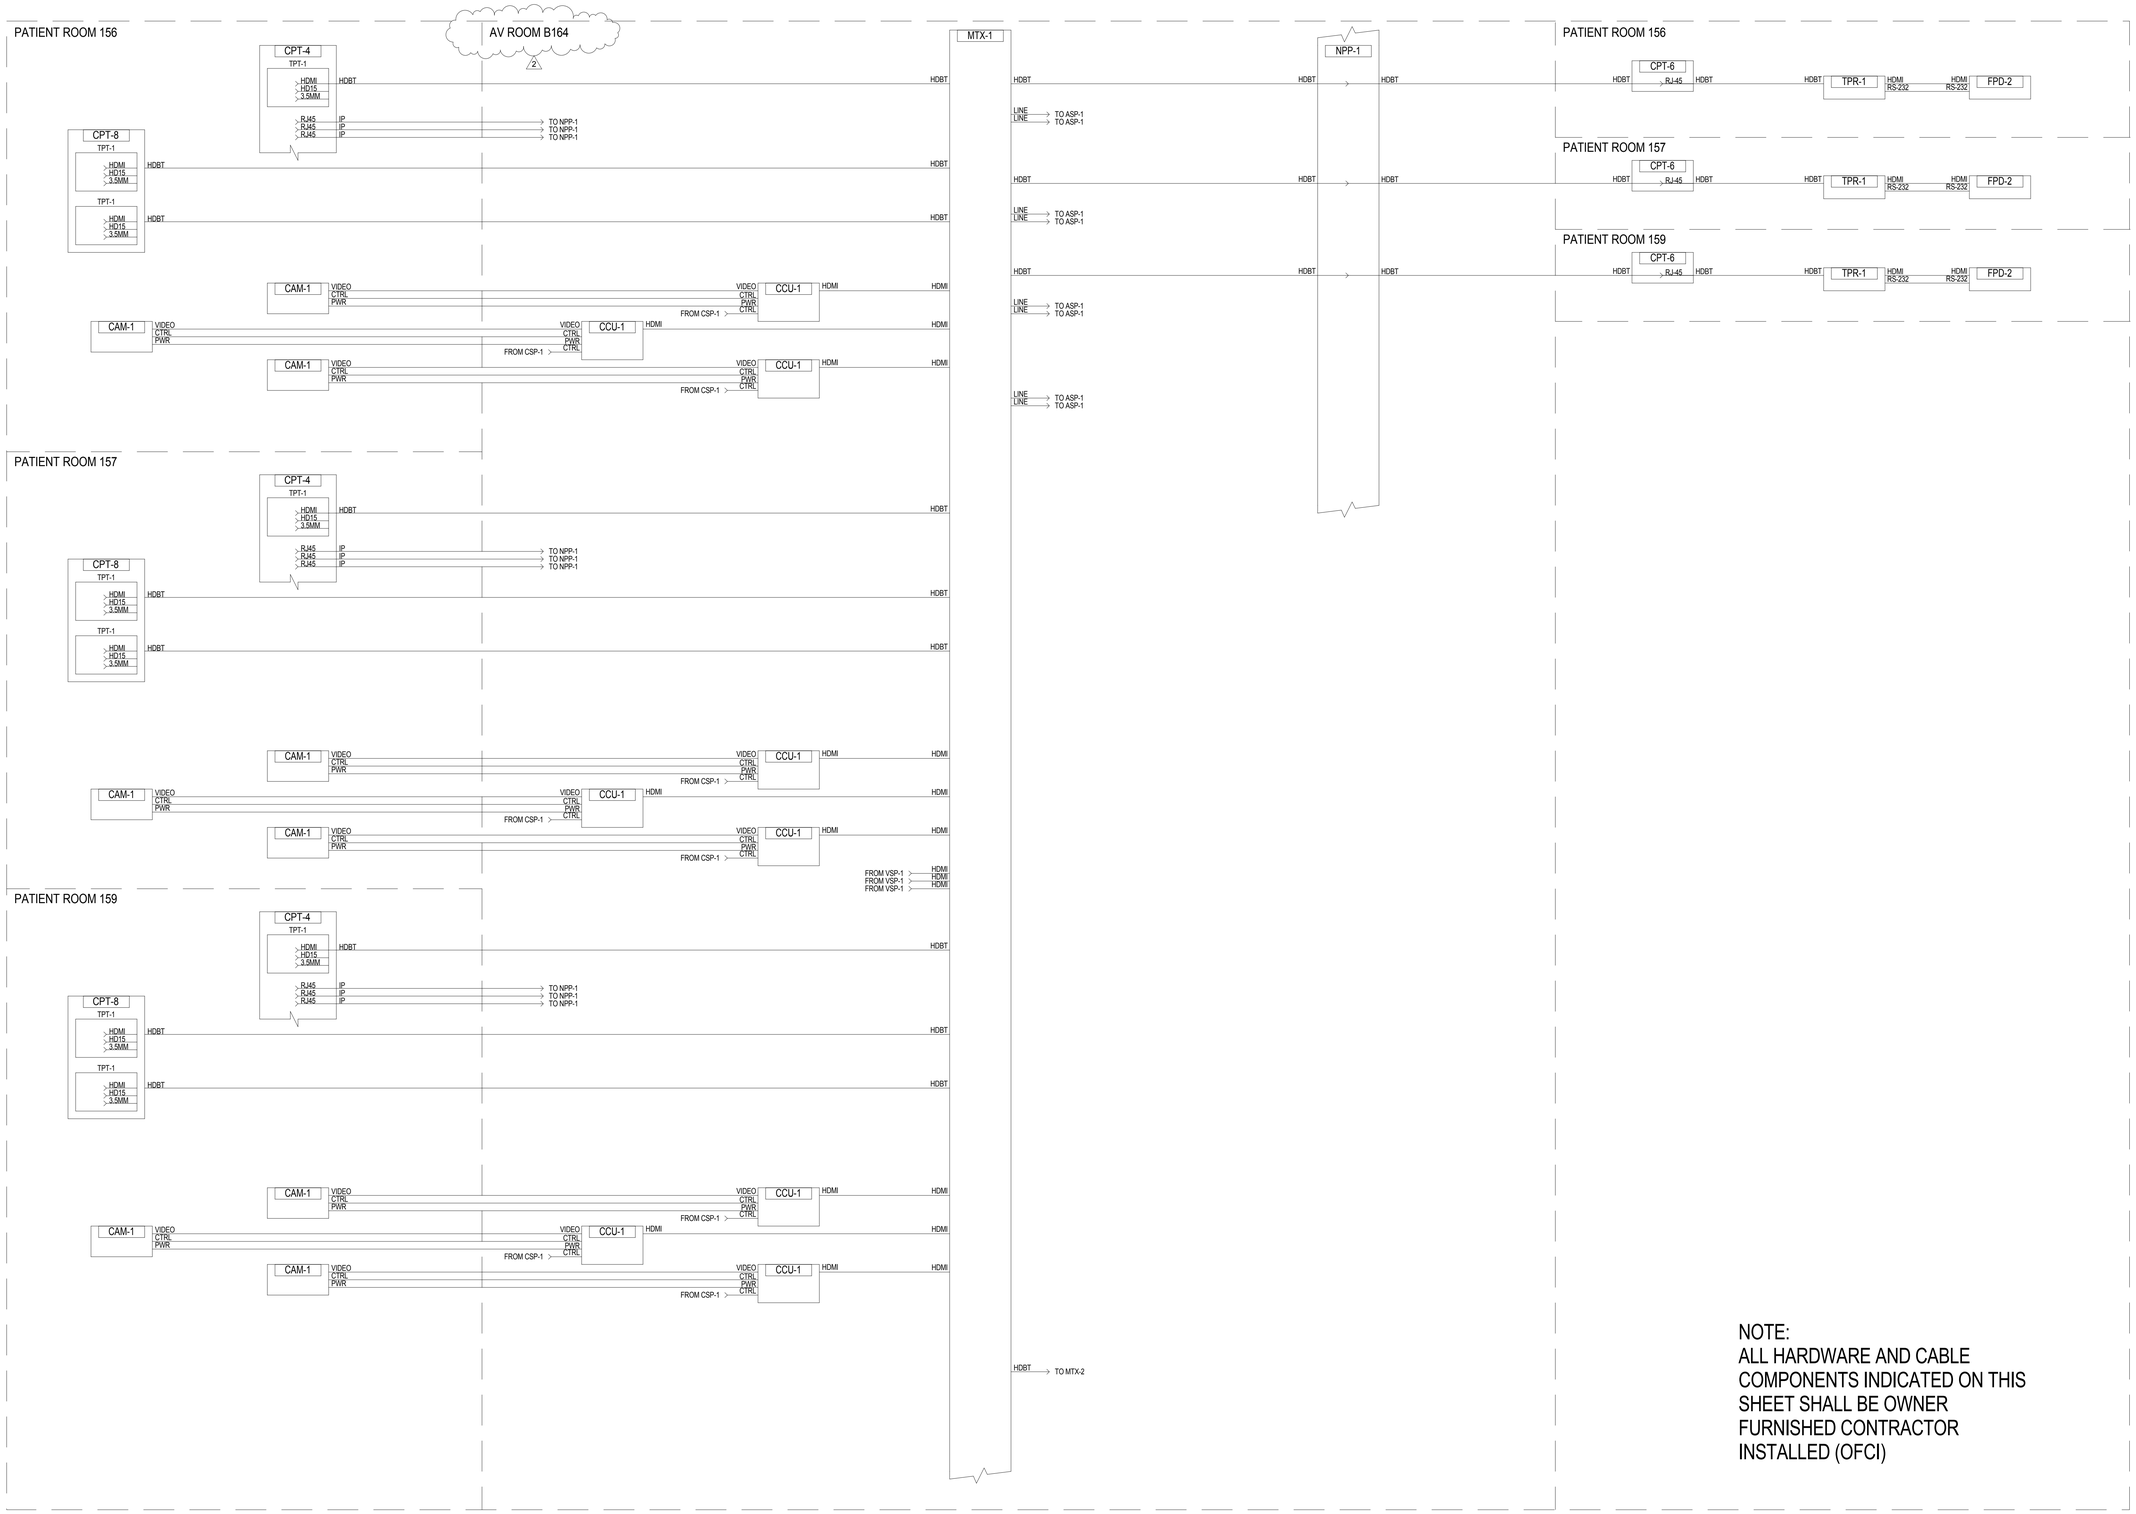

NOTE:
ALL HARDWARE AND CABLE COMPONENTS INDICATED ON THIS SHEET SHALL BE OWNER FURNISHED CONTRACTOR INSTALLED (OFCI)

GENERAL NOTES

KEY NOTES

LEGEND

ISSUE FOR BID

Revisions		Date
2	ADDENDUM 2	05/16/2014
1	ADDENDUM 1	02/06/2014

CONSULTANTS:

SM&W
SHEN MILSOM WILKE
33 New Montgomery Street
San Francisco, CA 94105
Tel: 415-391-7610
Fax: 415-391-0171

Seals and Signatures

ARCHITECT/ENGINEERS:

CANNONDESIGN
201 Mission Street, Suite 2400, San Francisco, California 94105 415.243.4170
Baltimore ■ Boston ■ Buffalo ■ Calgary ■ Chicago
Houston ■ Los Angeles ■ Mumbai ■ New York ■ Phoenix
St. Louis ■ San Francisco ■ Shanghai ■ Toronto
Vancouver ■ Victoria ■ Washington DC

Drawing Title: AV SYSTEMS PATIENT ROOMS & CLINICAL ROOM VIDEO FUNCTIONAL DIAGRAM

Approved: Project Director
Approver

Project Title: VA SIMULATION CENTER

Location: Veterans Affairs Palo Alto Heath Care System, 3801 Miranda Ave,Palo Alto, CA 94304

Date: JUNE 14, 2013 | Checked: SS | Drawn: RM

VA Project Number: 640-385
Building Number: 105
Drawing No. AV0604

VA PAHCS Veterans Affairs Palo Alto Health Care System
Department of Veterans Affairs

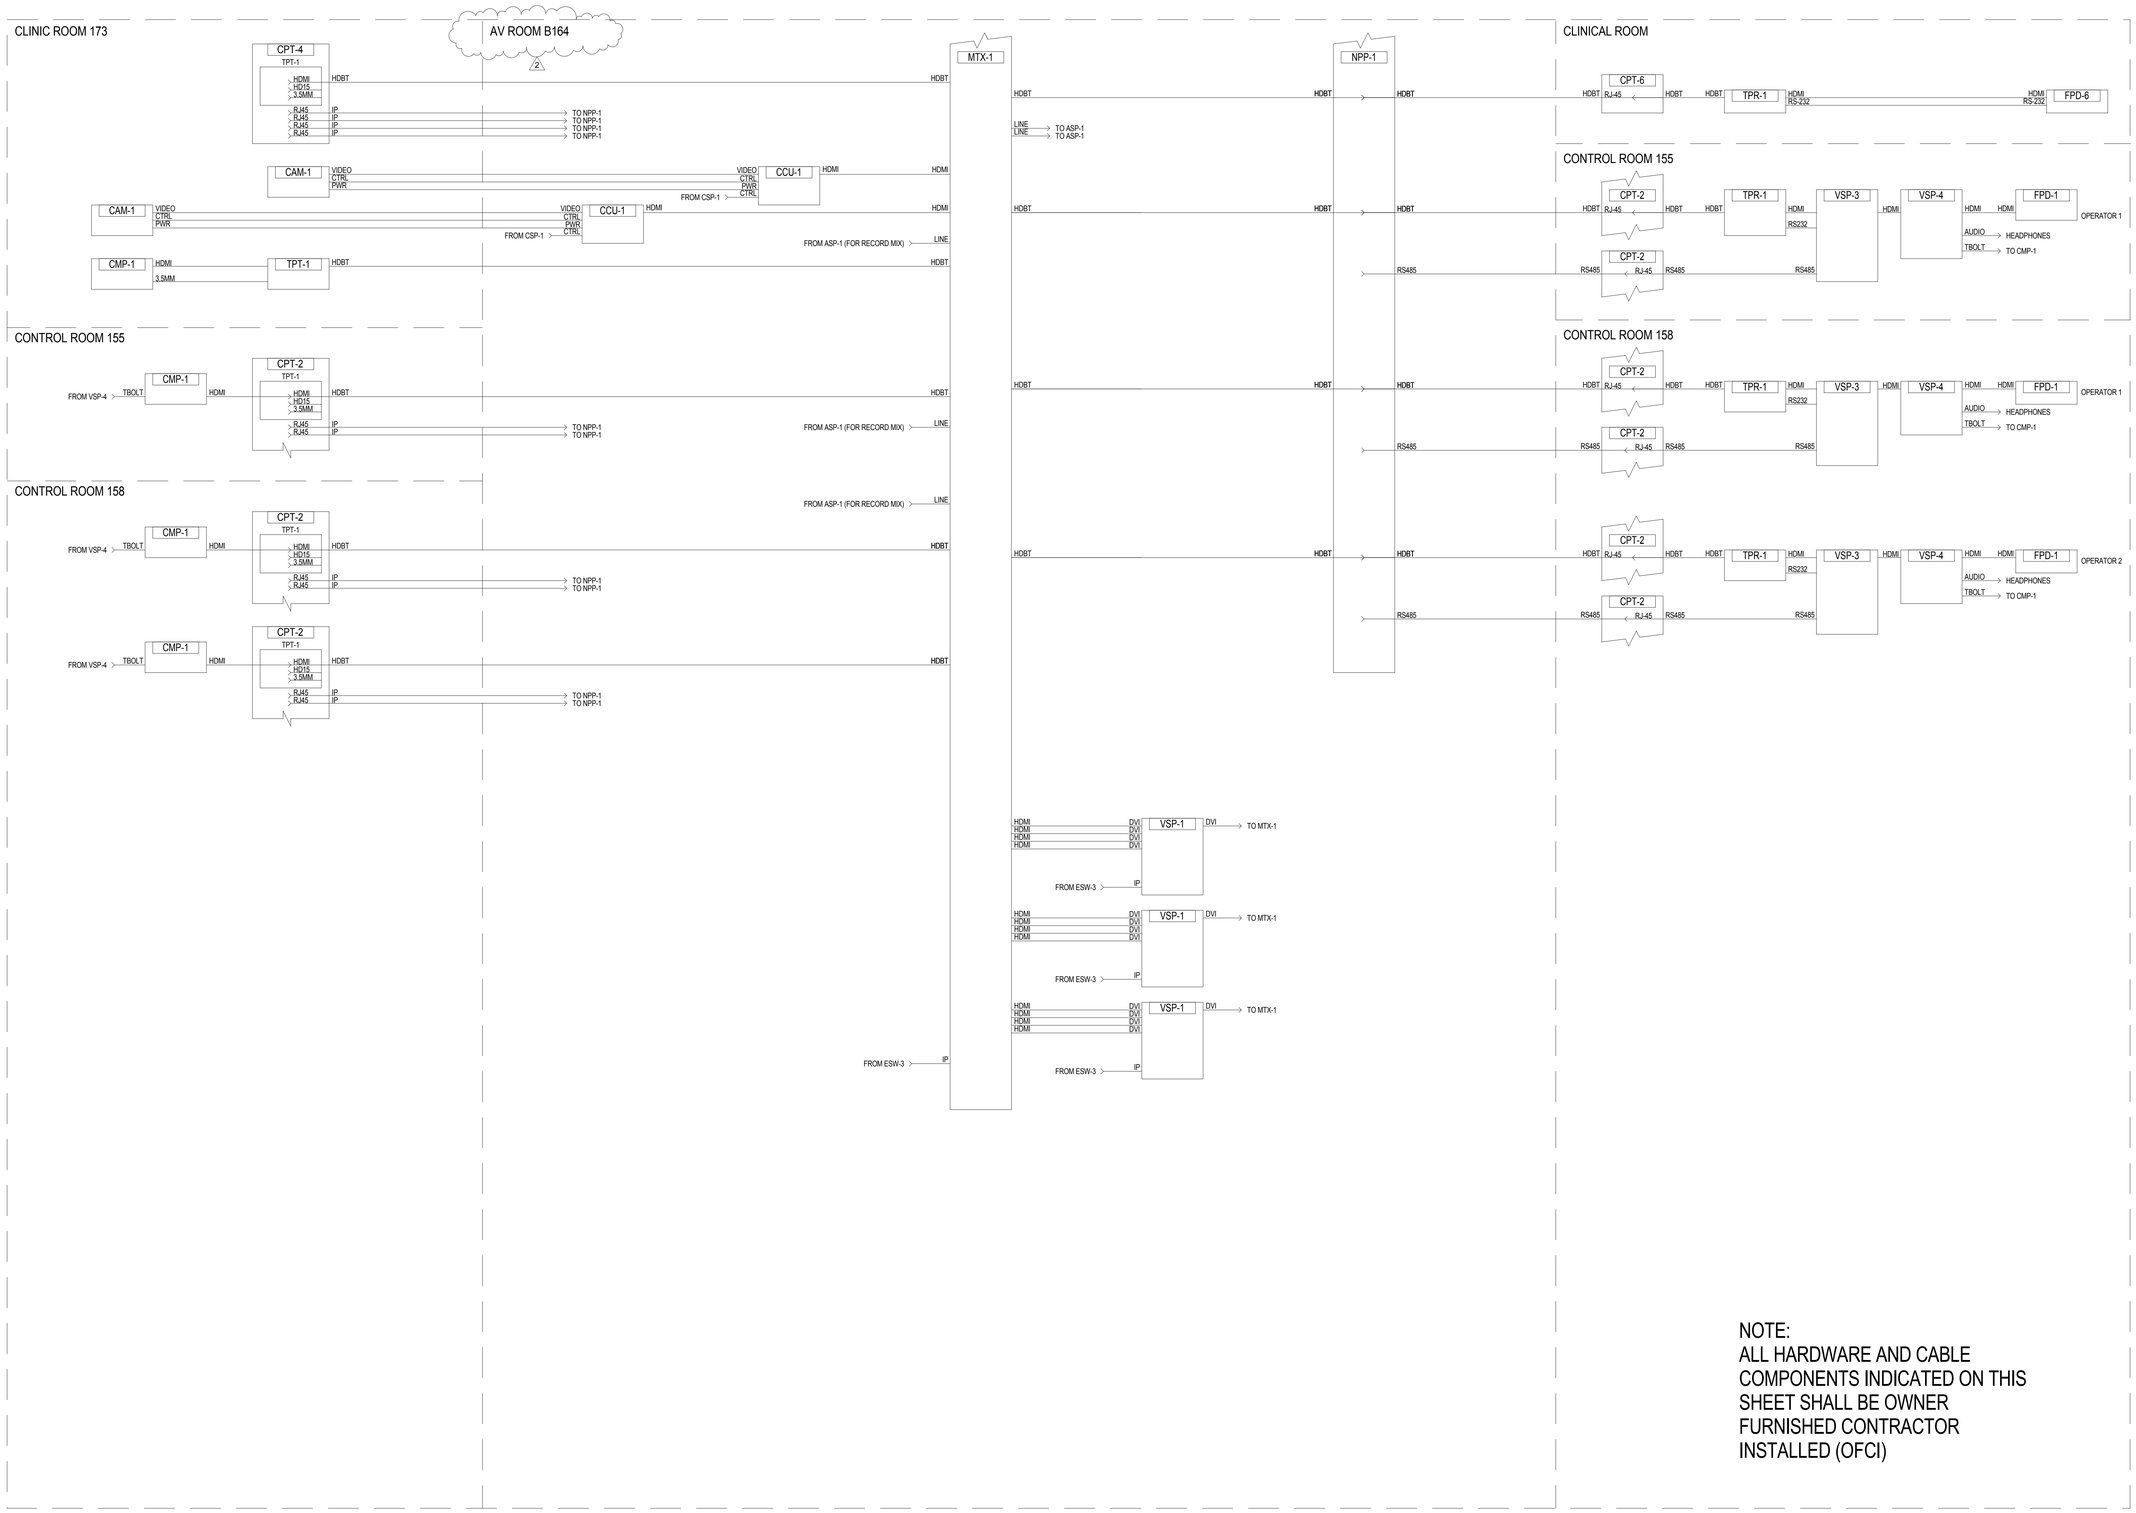

NOTE:
ALL HARDWARE AND CABLE COMPONENTS INDICATED ON THIS SHEET SHALL BE OWNER FURNISHED CONTRACTOR INSTALLED (OFCI)

GENERAL NOTES

KEY NOTES

LEGEND

PROJECT NORTH
TRUE NORTH

ISSUE FOR BID

Revisions		Date
2	ADDENDUM 2	05/16/2014
1	ADDENDUM 1	02/06/2014

CONSULTANTS:

SM&W
SHEN MILSOM WILKE
33 New Montgomery Street
San Francisco, CA 94105
Tel: 415-391-7610
Fax: 415-391-0171

Seals and Signatures

ARCHITECT/ENGINEERS:

CANNONDESIGN
201 Mission Street, Suite 2400, San Francisco, California 94105 415.243.4170
Baltimore ■ Boston ■ Buffalo ■ Calgary ■ Chicago
Houston ■ Los Angeles ■ Mumbai ■ New York ■ Phoenix
St. Louis ■ San Francisco ■ Shanghai ■ Toronto
Vancouver ■ Victoria ■ Washington DC

Drawing Title
AV SYSTEMS PATIENT ROOMS & CLINICAL ROOM VIDEO FUNCTIONAL DIAGRAM

Approved: Project Director
Approver

Project Title
VA SIMULATION CENTER

Location
Veterans Affairs Palo Alto Heath Care System
3801 Miranda Ave,Palo Alto, CA 94304

Date: JUNE 14, 2013
Checked: SS
Drawn: RM

VA Project Number: 640-385
Building Number: 105
Drawing No. AV0605

VA PAHCS Veterans Affairs Palo Alto Health Care System
Department of Veterans Affairs

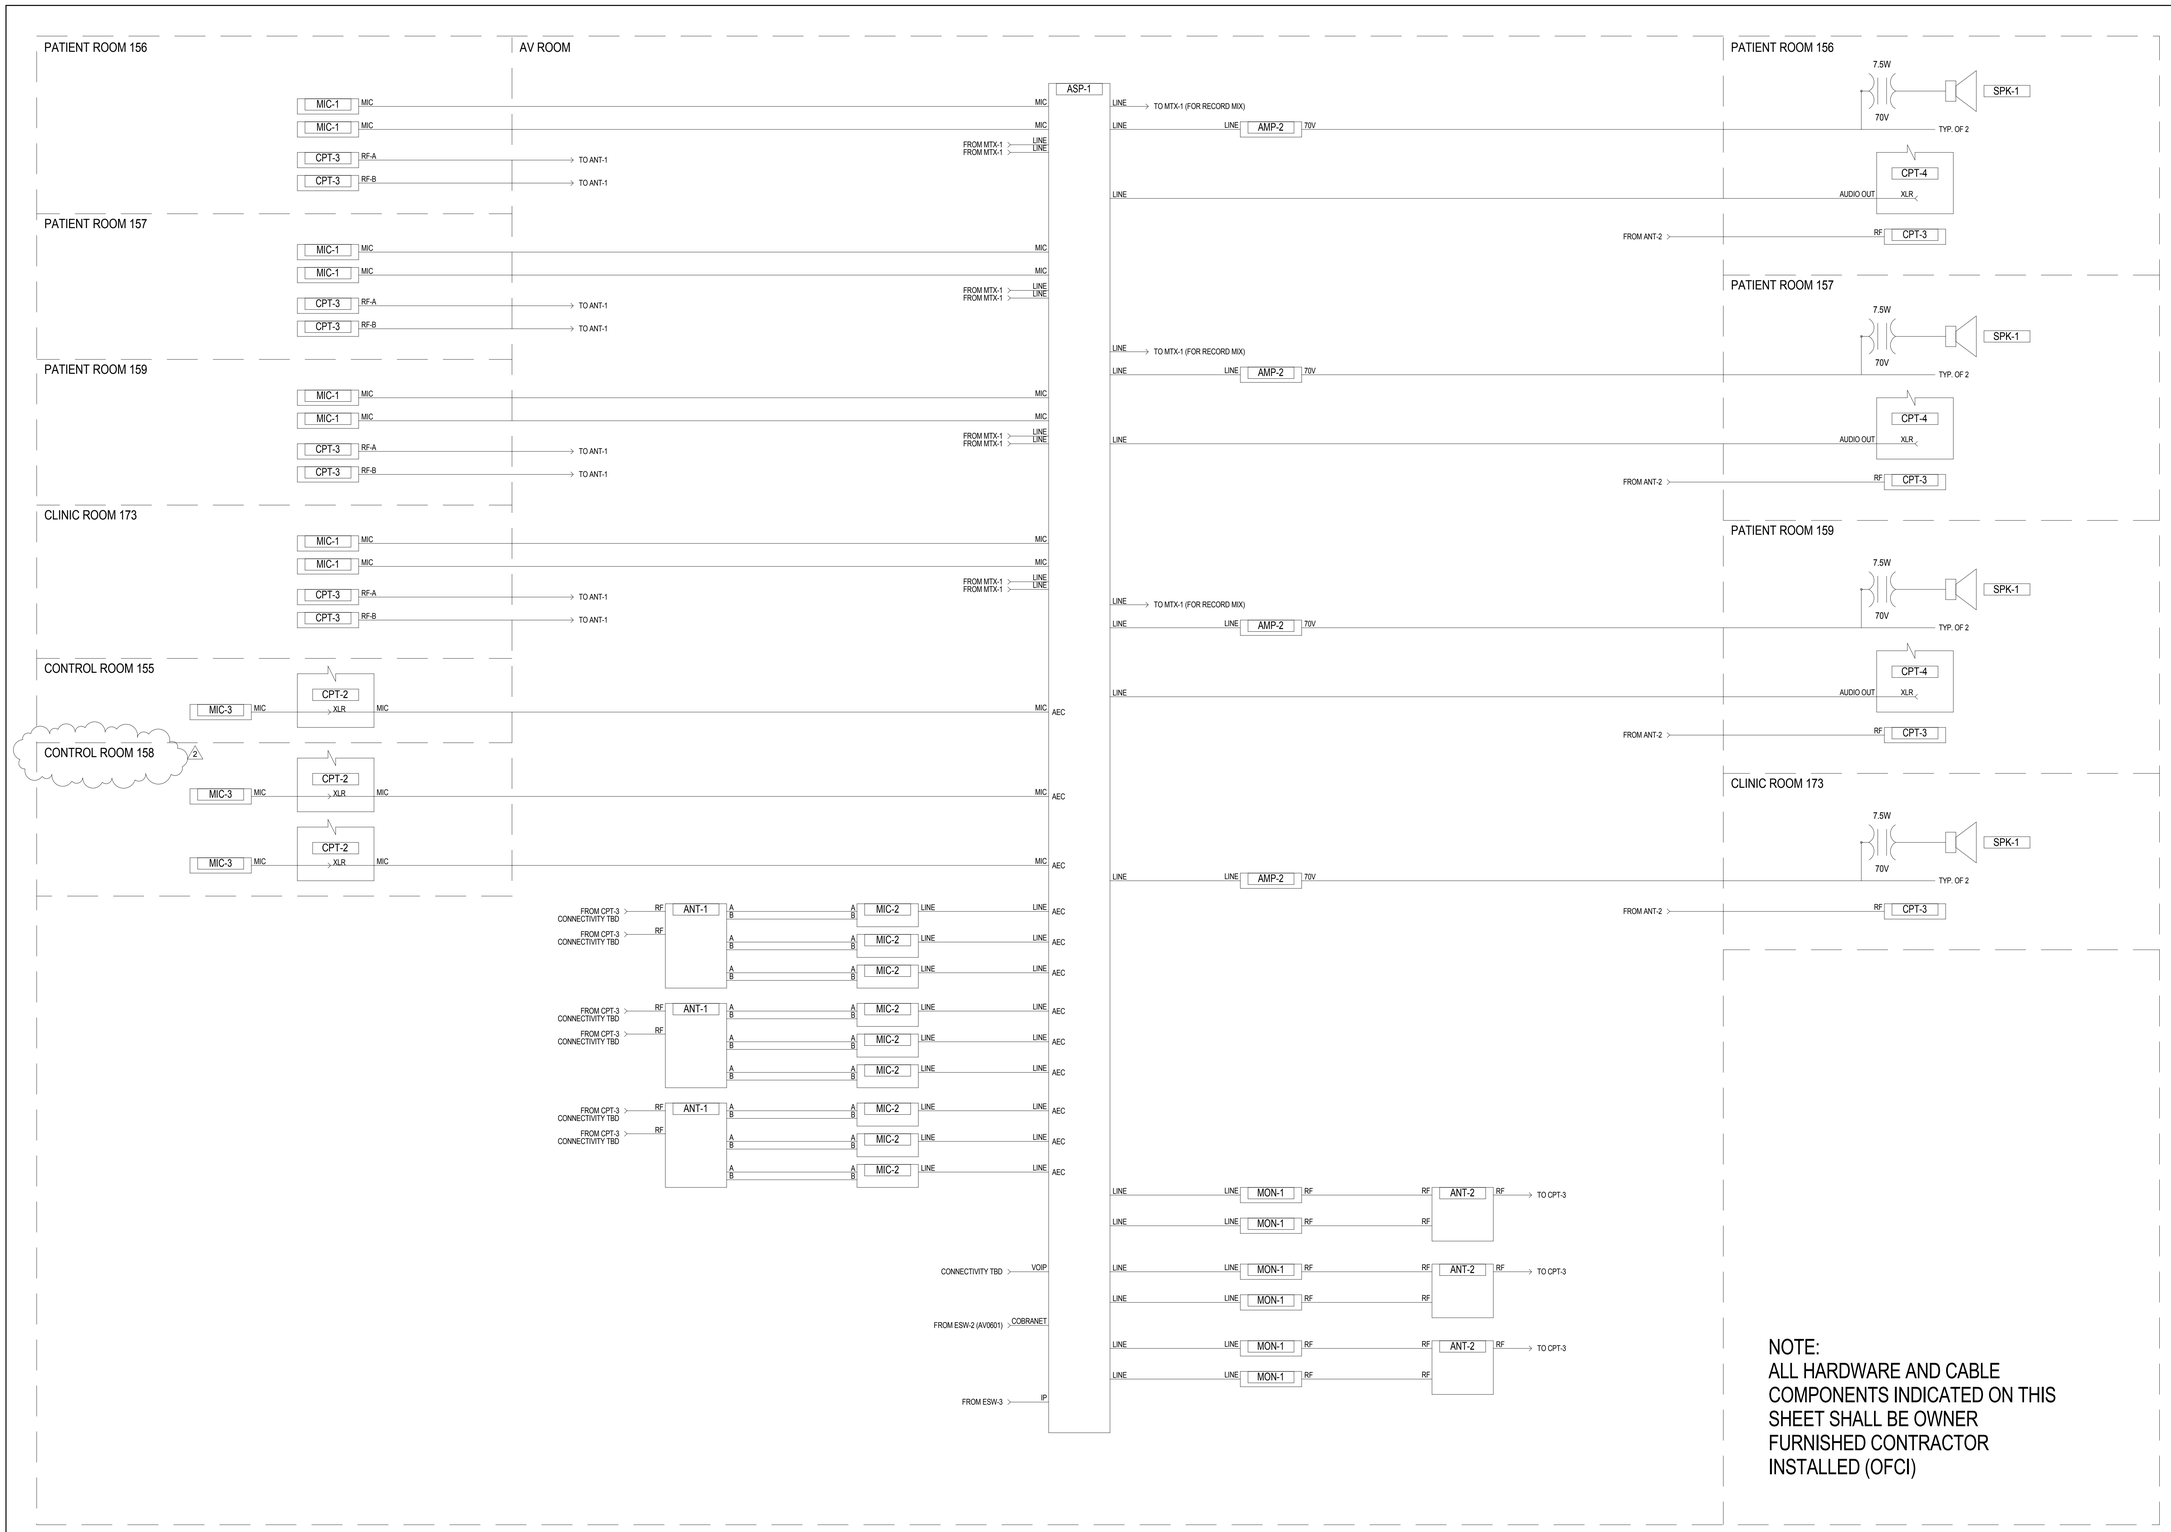

NOTE:
ALL HARDWARE AND CABLE COMPONENTS INDICATED ON THIS SHEET SHALL BE OWNER FURNISHED CONTRACTOR INSTALLED (OFCI)

GENERAL NOTES

KEY NOTES

LEGEND

ISSUE FOR BID

Revisions		Date
2	ADDENDUM 2	05/16/2014
1	ADDENDUM 1	02/06/2014

CONSULTANTS:

SHEN MILSOM WILKE
33 New Montgomery Street
San Francisco, CA 94105
Tel: 415-391-7610
Fax: 415-391-0171

Seals and Signatures

ARCHITECT/ENGINEERS:

CANNONDESIGN
201 Mission Street, Suite 2400, San Francisco, California 94105 415.243.4170
Baltimore ■ Boston ■ Buffalo ■ Calgary ■ Chicago
Houston ■ Los Angeles ■ Mumbai ■ New York ■ Phoenix
St. Louis ■ San Francisco ■ Shanghai ■ Toronto
Vancouver ■ Victoria ■ Washington DC

Drawing Title
AV SYSTEMS PATIENT ROOMS AUDIO FUNCTIONAL DIAGRAM

Approved: Project Director
Approver

Project Title
VA SIMULATION CENTER

Location
Veterans Affairs Palo Alto Heath Care System
3801 Miranda Ave,Palo Alto, CA 94304

Date: JUNE 14, 2013
Checked: SS
Drawn: RM

VA Project Number: 640-385
Building Number: 105
Drawing No. AV0606

VA PAHCS Veterans Affairs Palo Alto Health Care System
Department of Veterans Affairs