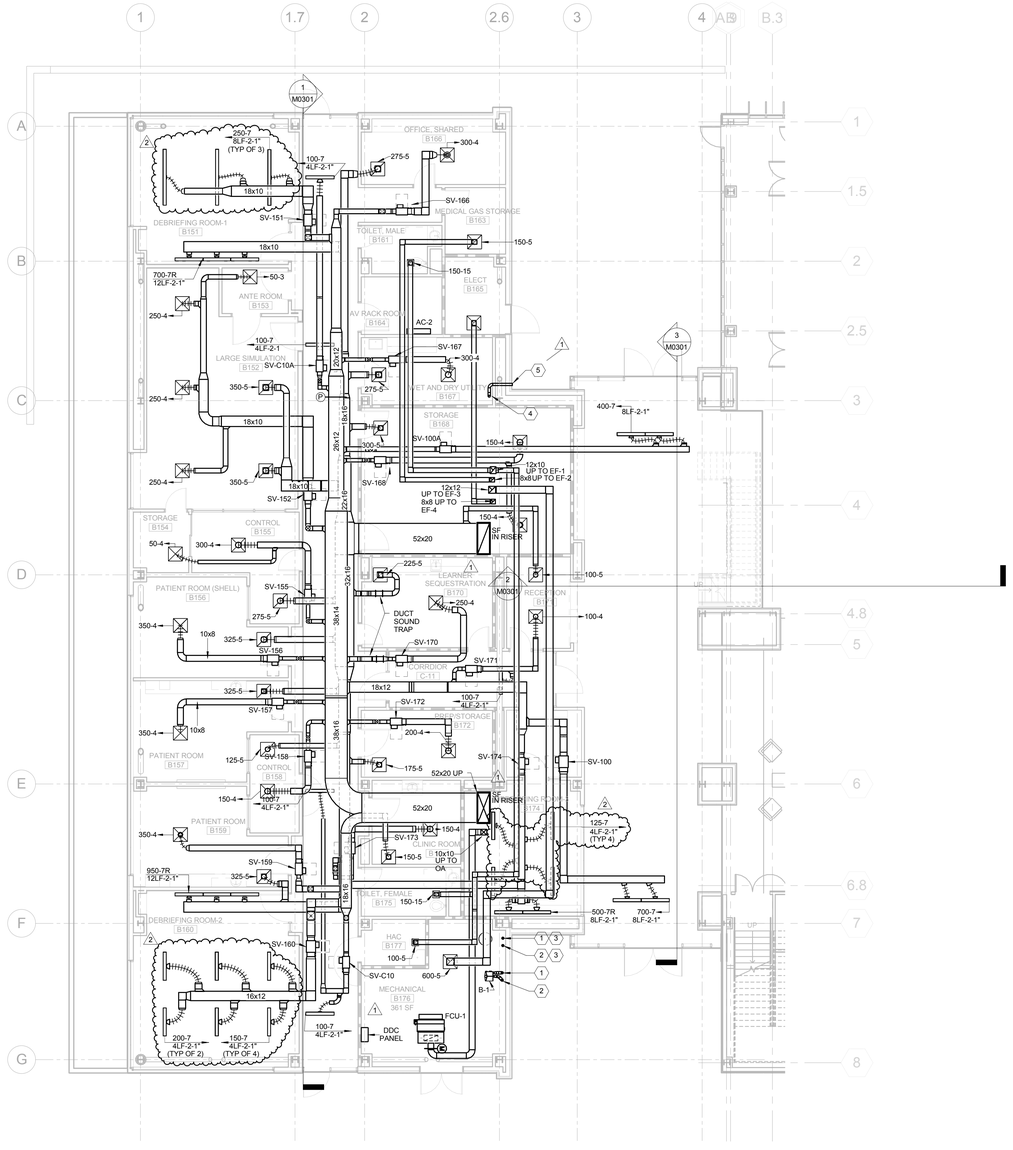

1 LEVEL 1
1/8" = 1'-0"

GENERAL NOTES

1. BALANCE DAMPERS AT BRANCH TAKEOFFS AND RUNOUTS NOT SHOWN. SEE DETAIL 5/M0701.

KEY NOTES

NOTES:

1. 4"ø COMBUSTION AIR INTAKE UP. TERMINATE 3' ABOVE FINISHED ROOF WITH GOOSENECK.
2. 4"ø COMBUSTION EXHAUST UP. TERMINATE 3' ABOVE FINISHED ROOF.
3. CONNECT TO DOMESTIC WATER HEATER DWH-1. SEE PLUMBING DRAWINGS.
4. 4"Ø DRYER EXHAUST DOWN TO WASHER/DRYER COMBO UNIT
5. 4"Ø DRYER EXHAUST TO TERMINATE THROUGH SIDEWALL WITH DRYER VENT. SEE DETAIL 11/M0701.

LEGEND

PROJECT NORTH
TRUE NORTH

ISSUE FOR BID

Revisions		Date
9		
8		
7		
6		
5		
4		
3		
2	ADDENDUM 2	05/16/2014
1	ADDENDUM 1	02/06/2014

CONSULTANTS:

Seals and Signatures

ARCHITECT/ENGINEERS:

CANNONDESIGN

201 Mission Street, Suite 2400, San Francisco, California 94105 415.243.4170

Baltimore ■ Boston ■ Buffalo ■ Calgary ■ Chicago
Houston ■ Los Angeles ■ Mumbai ■ New York ■ Phoenix
St. Louis ■ San Francisco ■ Shanghai ■ Toronto
Vancouver ■ Victoria ■ Washington DC

Drawing Title: LEVEL 1 - HVAC DUCTWORK PLAN

Approved: Project Director
Approver

Project Title: VA SIMULATION CENTER

Location: Veterans Affairs Palo Alto Heath Care System
3801 Miranda Ave,Palo Alto, CA 94304

Date: JUNE 14, 2013 | Checked: JN | Drawn: JRC

VA Project Number: 640-385

Building Number: 105

Drawing No.: M0101

VA PAHCS Veterans Affairs Palo Alto Health Care System

Department of Veterans Affairs

three inches = one foot
one and one-half inches = one foot
one inch = one foot
three-quarters inch = one foot
one-half inch = one foot
three-eighths inch = one foot
one-quarter inch = one foot
one-eighth inch = one foot