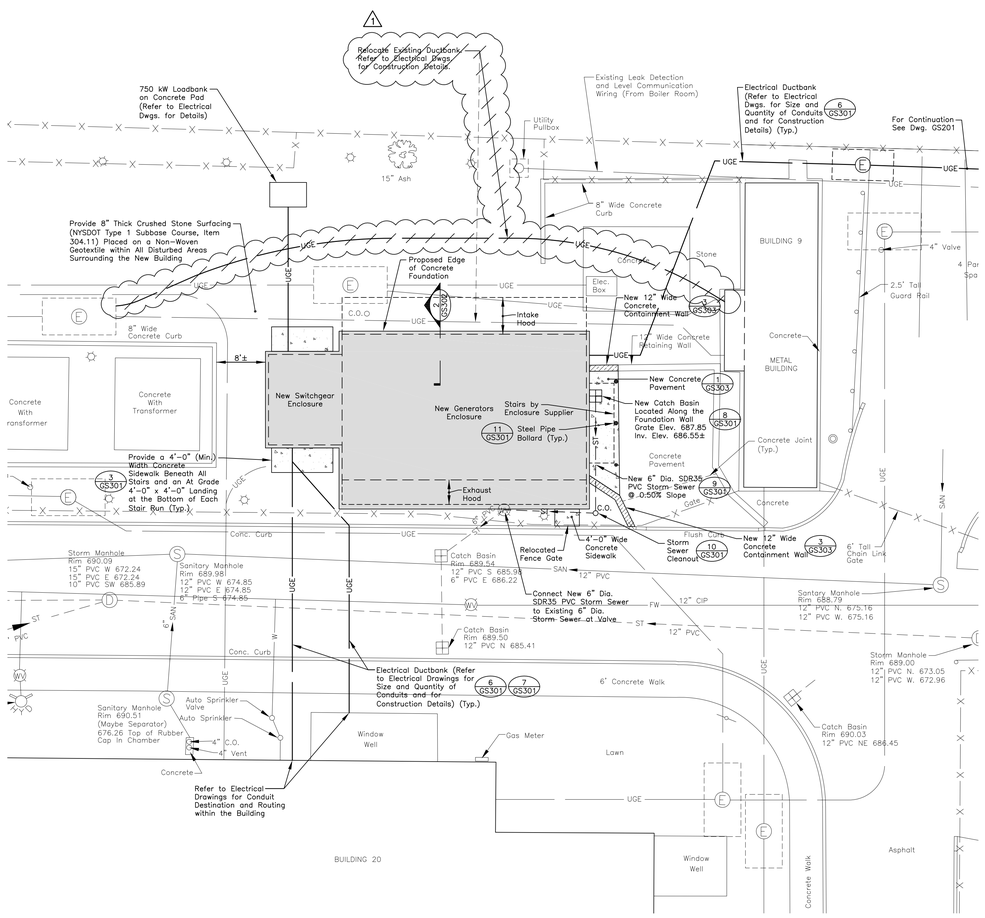

1 GS202 NEW GENERATOR BUILDING SITE PLAN

SCALE: 1" = 10'

SCALE (FEET) 0 10 20

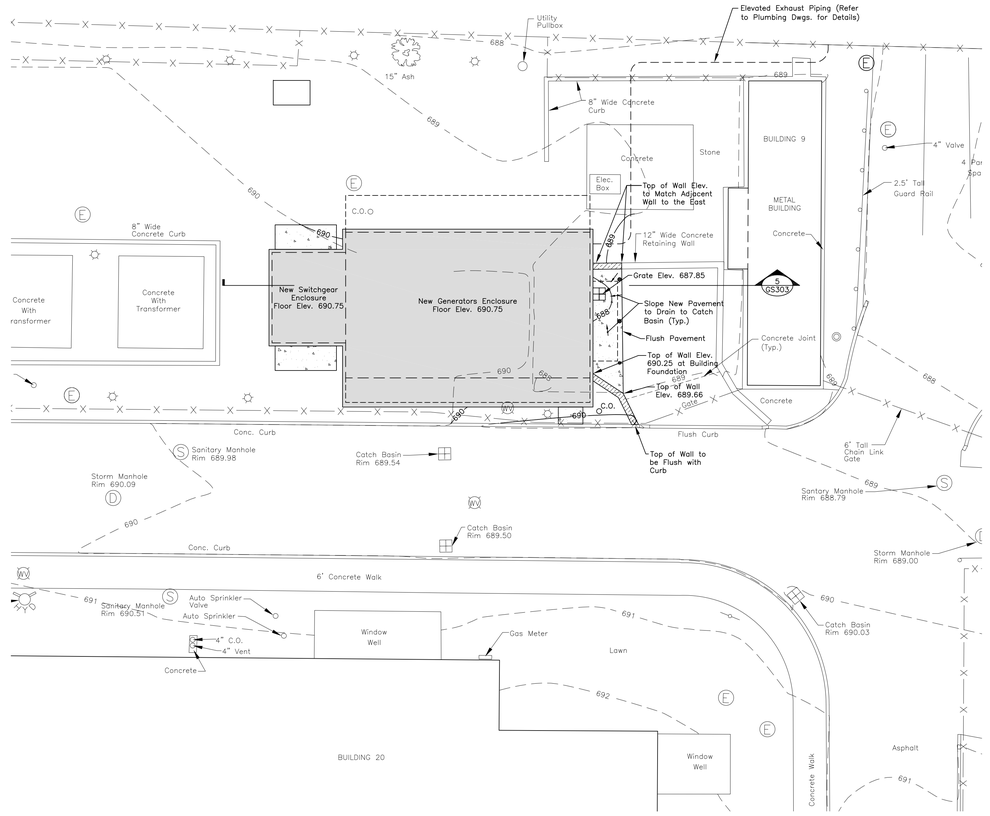

2 GS202 NEW GENERATOR BUILDING GRADING PLAN

SCALE: 1" = 10'

SCALE (FEET) 0 10 20

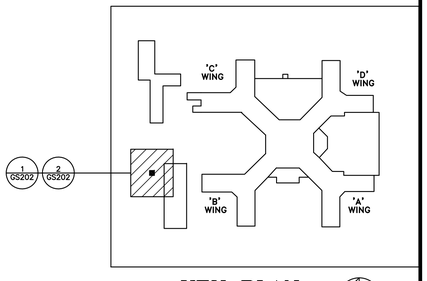

KEY PLAN

SCALE: NONE

N

Revisions	Date
⚠ Deleted Ductbank Relocation	5/22/14

VA WESTERN NEW YORK HEALTHCARE SYSTEM
3495 BAILEY AVENUE
BUFFALO, NEW YORK 14215

Consultant

ECAB engineering, p.c.
15 Schoen Place, Suite 300, Pittsford, NY 14534
Phone: (585) 641-7121
Fax: (585) 362-4175
www.ecab.com

stamp

Architect / Engineer

THORNTON ENGINEERING LLP
30 Assembly Drive, Suite 106, Mendon, New York 14506
Consultant Engineers

CARDIOLOGY MANAGER	DATE	ENGINEERING MANAGER	DATE
INFECTION CONTROL	DATE	CARELINE MANAGER	DATE
SAFETY OFFICER	DATE	CHIEF OF STAFF	DATE
MEDICAL CENTER DIRECTOR	DATE		
ASSOCIATE MEDICAL CENTER DIRECTOR	DATE		

Drawing Title: NEW GENERATOR BUILDING SITE/GRADING PLAN

Project Title: VA BUFFALO EMERGENCY POWER UPGRADES

Building Number: 1 | Checked: GFT | Drawn: HKT

Location: V.A.M.C. BUFFALO, NEW YORK

Date: April 8, 2014

Station No.: 528-13-102

13-102-GS202

Office of Facilities

Department of Veterans Affairs