



- GENERAL NOTES:
- A. REMOVE EXISTING PIPING LABELS AND PROVIDE NEW LABELS TO EXISTING LPS PIPING CHANGING TO MPS.
 - B. FIRE STOP ALL PIPING PENETRATION THROUGH STAIR AND CORRIDOR WALLS.


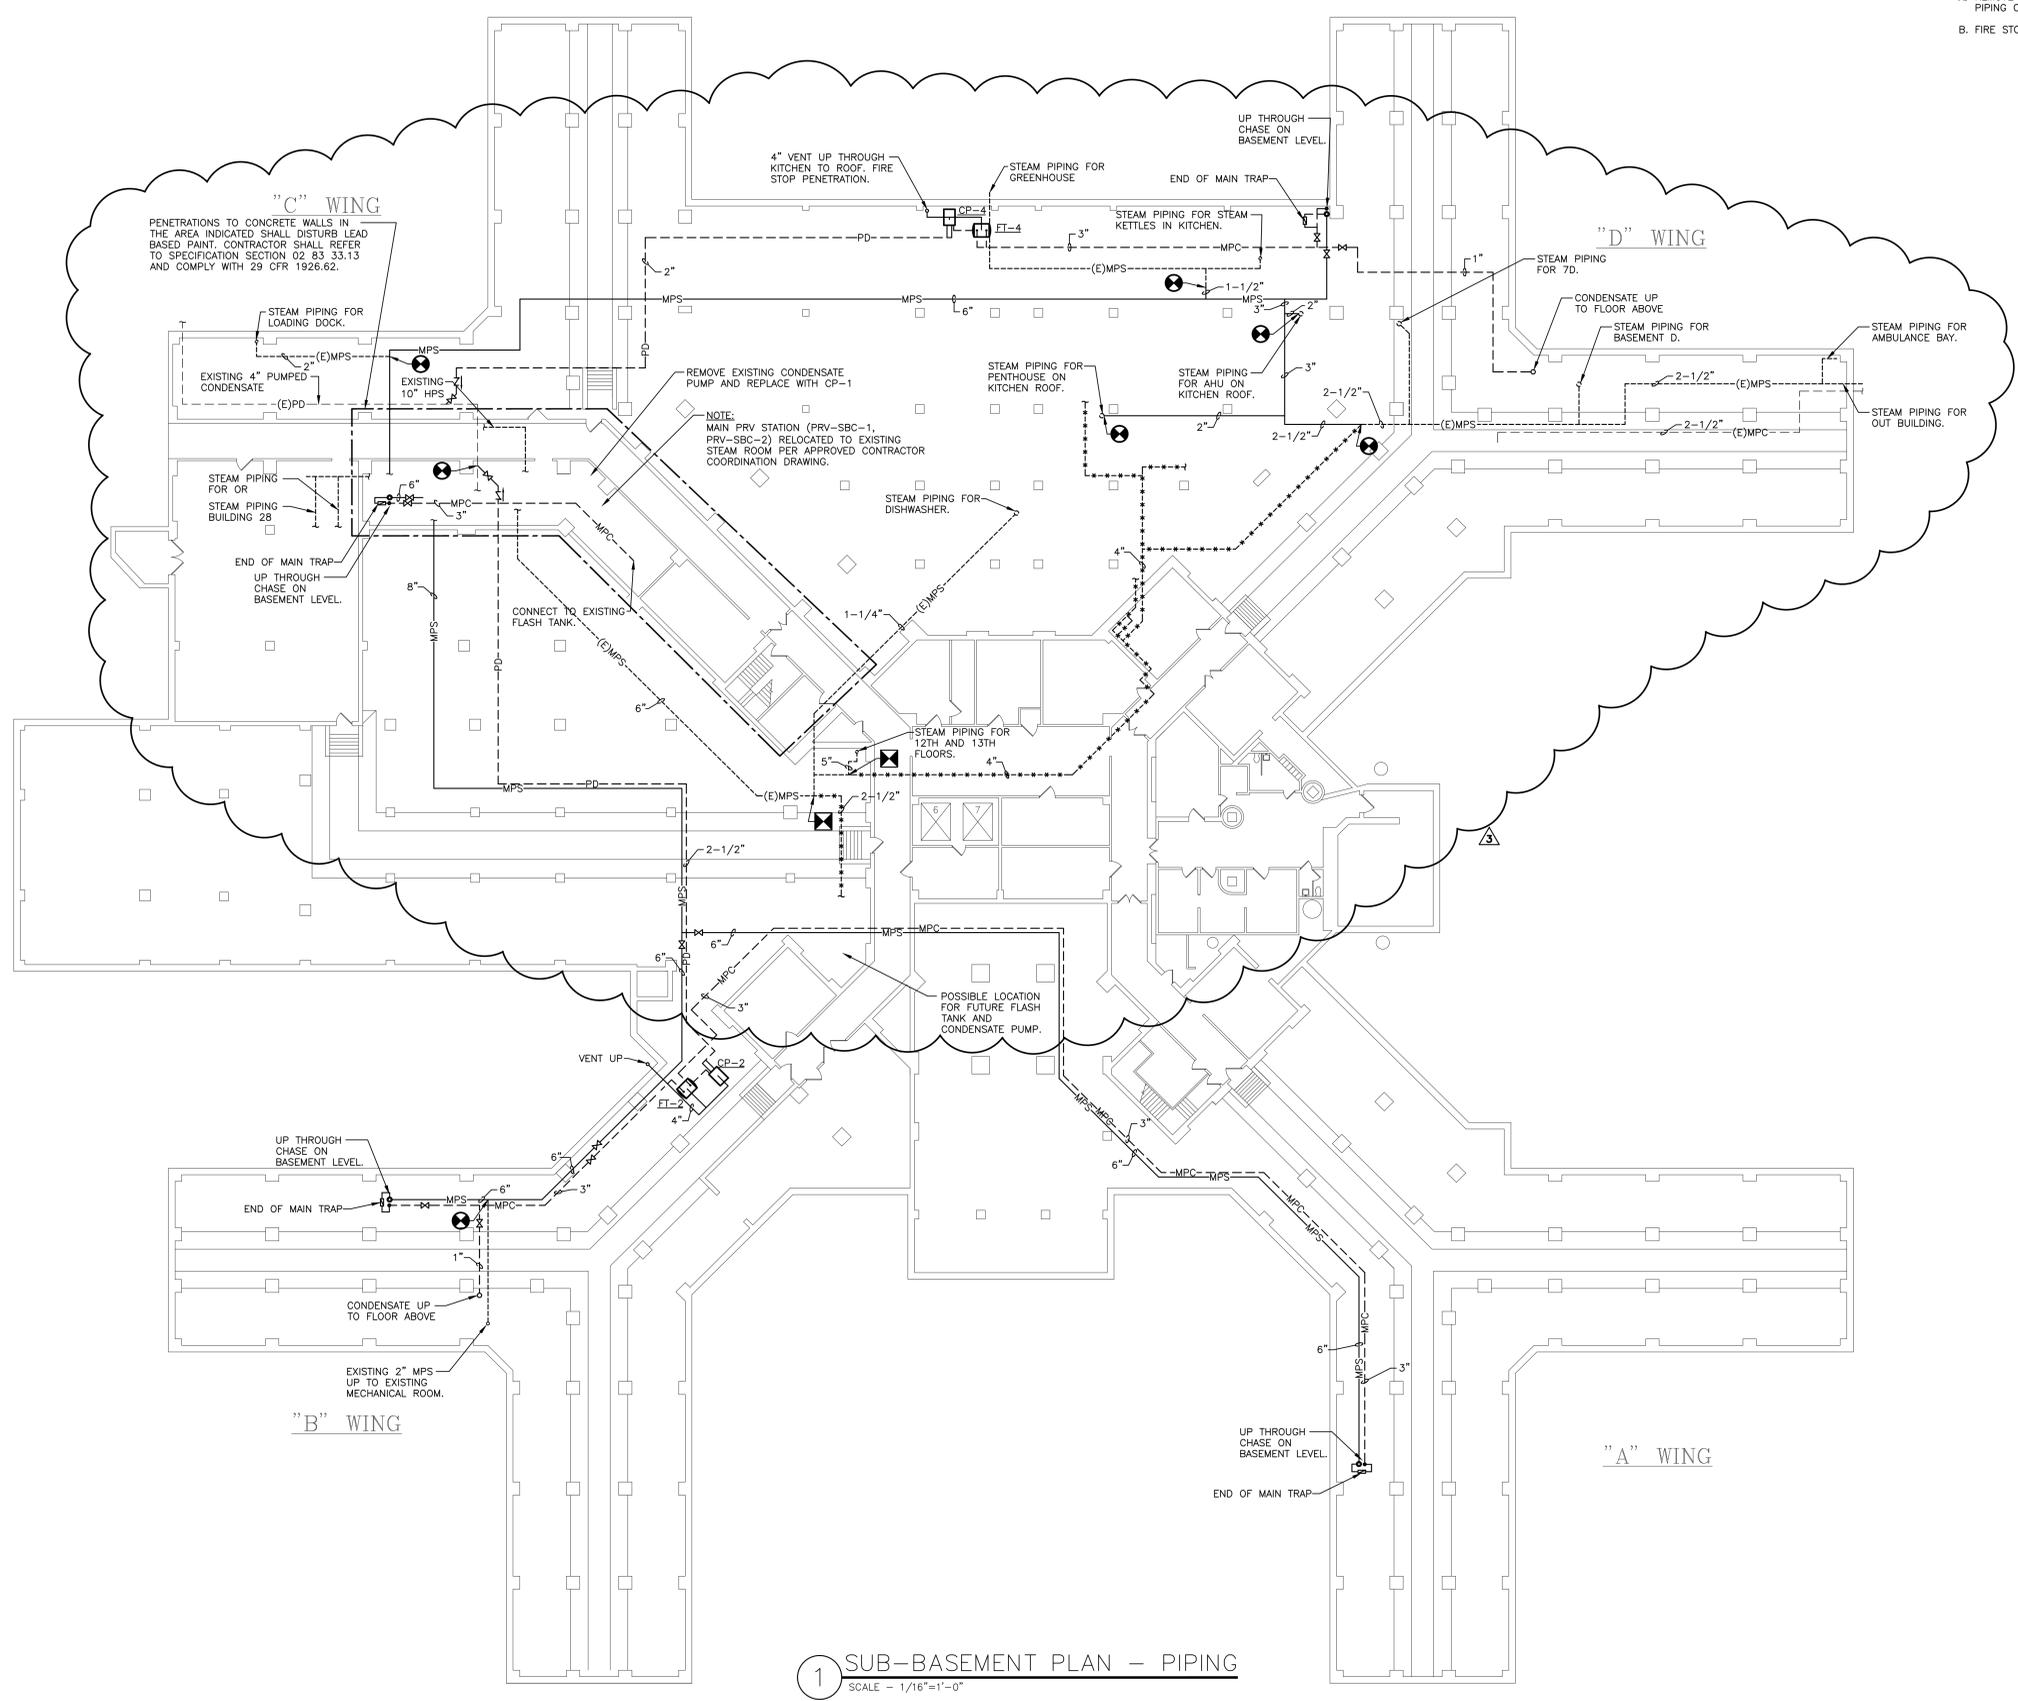

1 SUB-BASEMENT PLAN - PIPING
 SCALE - 1/16"=1'-0"

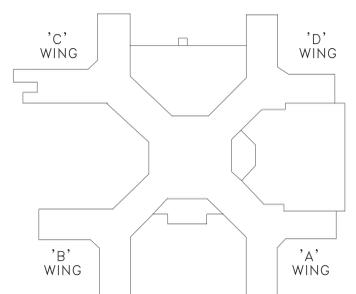

KEY PLAN
 SCALE: NONE

REVISION 3 - EXISTING PIPING REV.	5/5/14
REVISION 2 - COND. PUMP REVISION	2/17/14
REVISION 1	3/14/13
ISSUED FOR BID	2/15/13
Revisions	Date

VA WESTERN NEW YORK HEALTHCARE SYSTEM
 3495 BAILEY AVENUE
 BUFFALO, NEW YORK 14215

RAM-TECH ENGINEERS
 Syracuse, NY • Buffalo, NY • Philadelphia, PA
RAM-TECH Engineers
 of Buffalo, P.C.
 phone: 716-833-7716
 fax: 716-832-6373
 www.ramtechengineers.com

Architect stamp

CARDIOLOGY MANAGER	DATE	ENGINEERING MANAGER	DATE
INFECTION CONTROL	DATE	CARELINE MANAGER	DATE
SAFETY OFFICER	DATE	CHIEF OF STAFF	DATE

Drawing Title		Project Title	
SUB-BASEMENT PLAN - MECHANICAL		REPLACE STEAM RISERS	
MEDICAL CENTER DIRECTOR	DATE	Building Number	Checked
ASSOCIATE MEDICAL CENTER DIRECTOR	DATE	1	MDR
		Drawn	MMW
		Location	
		V.A.M.C. BUFFALO, NEW YORK	

Date	February 15, 2013
Station No.	52B

11-116-M100

