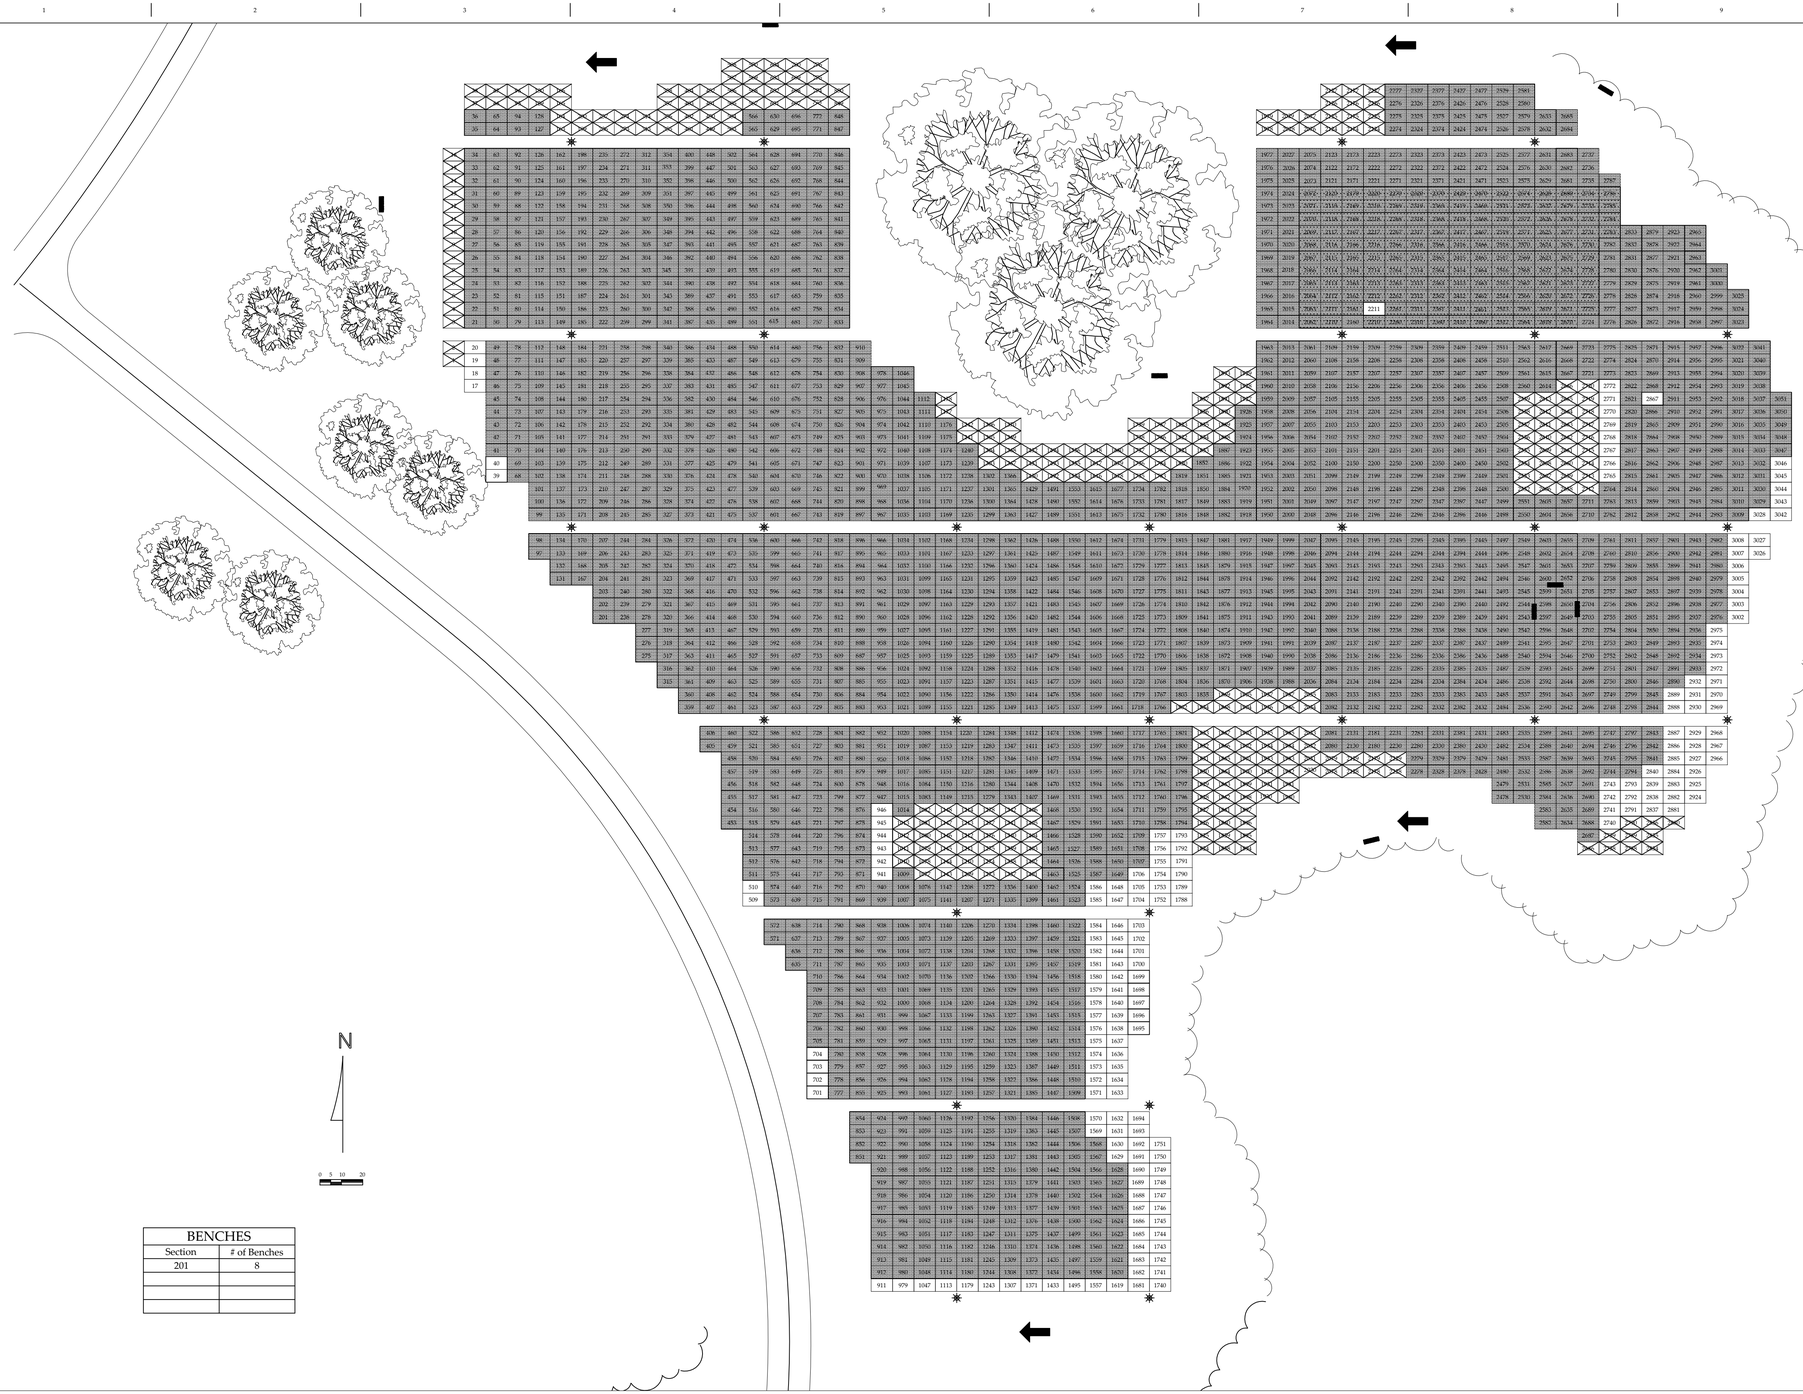

BENCHES	
Section	# of Benches
201	8

Updates and Corrections	8/20/10
Added Benches	12/22/09
Semi-Annual Update	10/19/09
Revisions	Date

CAPACITY IN GRAVESITES						
SECTION	SIZE OF GRAVESITE	TOTAL	RES	AVAIL	OBST.	REMARKS
201	6 x 10	3031				

Scale : NTS

LEGEND
AVAILABLE GRAVESITE
SET ASIDE/RESERVED
OBSTRUCTED GRAVESITE
OCCUPIED GRAVESITE
GRAVES FACE
GRAVESITE CONTROL MONUMENT
TYPICAL BENCH

National Cemetery Administration
Memorial Service Network II
Decatur, Georgia 30033

Drawing Title: Section 201 Layout Drawing

Approved: Area Director

Approved: Cemetery Director

Project: Florida National Cemetery

Location: Bushnell, FL

Building Number | Checked | Drawn: DCJ

Path: \\Cematla101\share\MSN II Drawings\Florida\Updated Layout

Date: 10/15/09

Project No.

Drawing Title: 911LA003 Section 201

Dwg. Of

VA FORM 08-6231, FEB. 1983