


MECHANICAL LEGEND  
AND NOTES

- JOHNSON CONTROLS PNEUMATIC THERMOSTAT MOUNTED AT 48" ABOVE THE FINISHED FLOOR TO PROVIDE COOLING ONLY OPERATION OF THE ASSOCIATED PNEUMATIC VAV BOX, OR APPROVED EQUAL.
- TITUS MODEL PECV, OR APPROVED EQUAL, VARIABLE AIR VOLUME TERMINAL UNIT. PROVIDE A 10" DIAMETER TERMINAL WITH A MULTI-POINT SENSOR. THE UNIT WILL SUPPLY 0 TO 800 CFM.
- CD-1, 2 CEILING SUPPLY TITUS MODEL TMS, OR APPROVED EQUAL.
- CR-1 CEILING RETURN TITUS MODEL 50F, OR APPROVED EQUAL.
- CE-1 CEILING EXHAUST TITUS MODEL 50F, OR APPROVED EQUAL.
- COORDINATE AIR DISTRIBUTION DEVICE LOCATIONS WITH THE ARCHITECTURAL CEILING PLAN, 69-A1.2.
- F/SD FIRE / SMOKE DAMPER WITH ACCESS DOORS. PROVIDE DAMPER TO ACCOMMODATE THE WALL RATING. INTERLOCK WITH THE EXISTING FIRE ALARM SYSTEM AS REQUIRED.
- INDICATE CONNECTION OF NEW EQUIPMENT TO EXISTING SERVICES FIELD. VERIFY CONNECTIONS.
- DUCT CONNECTION: CONNECT THE NEW AIR DISTRIBUTION DEVICES TO THE EXISTING HVAC SYSTEMS. PROVIDE ALL LABOR MATERIALS AND HARDWARE REQUIRED. VERIFY RUNOUT SIZE BEFORE ORDERING AIR DISTRIBUTION DEVICES.
- DUCTWORK SIZES AND LOCATIONS ARE APPROXIMATE. THE CONTRACTOR SHALL FIELD VERIFY ALL DUCT SIZES AND LOCATIONS ADJACENT TO FIRE WALLS BEFORE ORDERING FIRE DAMPERS.
- THE CONTRACTOR SHALL PROVIDE A TEST FOR ALL EXISTING AIR DISTRIBUTION DEVICES PRIOR DEMOLITION FROM AABC CERTIFIED TEST AND BALANCE AGENT, WITH THE ASSOCIATED VAV BOX FULLY OPEN, AND PROVIDE THE TEST INFORMATION TO THE DESIGN ENGINEER. THE TEST INFORMATION WILL INCLUDE: AT THE LEAST DIFFUSER SIZE, NECK SIZE, AND FLOW RATE IN CFM. THE DESIGN ENGINEER WILL EVALUATE THE "AS CONFIGURED" CONDITION AS SHOWN IN THE REPORT AND PROVIDE REVISED DRAWINGS SHOWING REQUIRED AIR QUANTITIES FOR THE NEW LAYOUT.

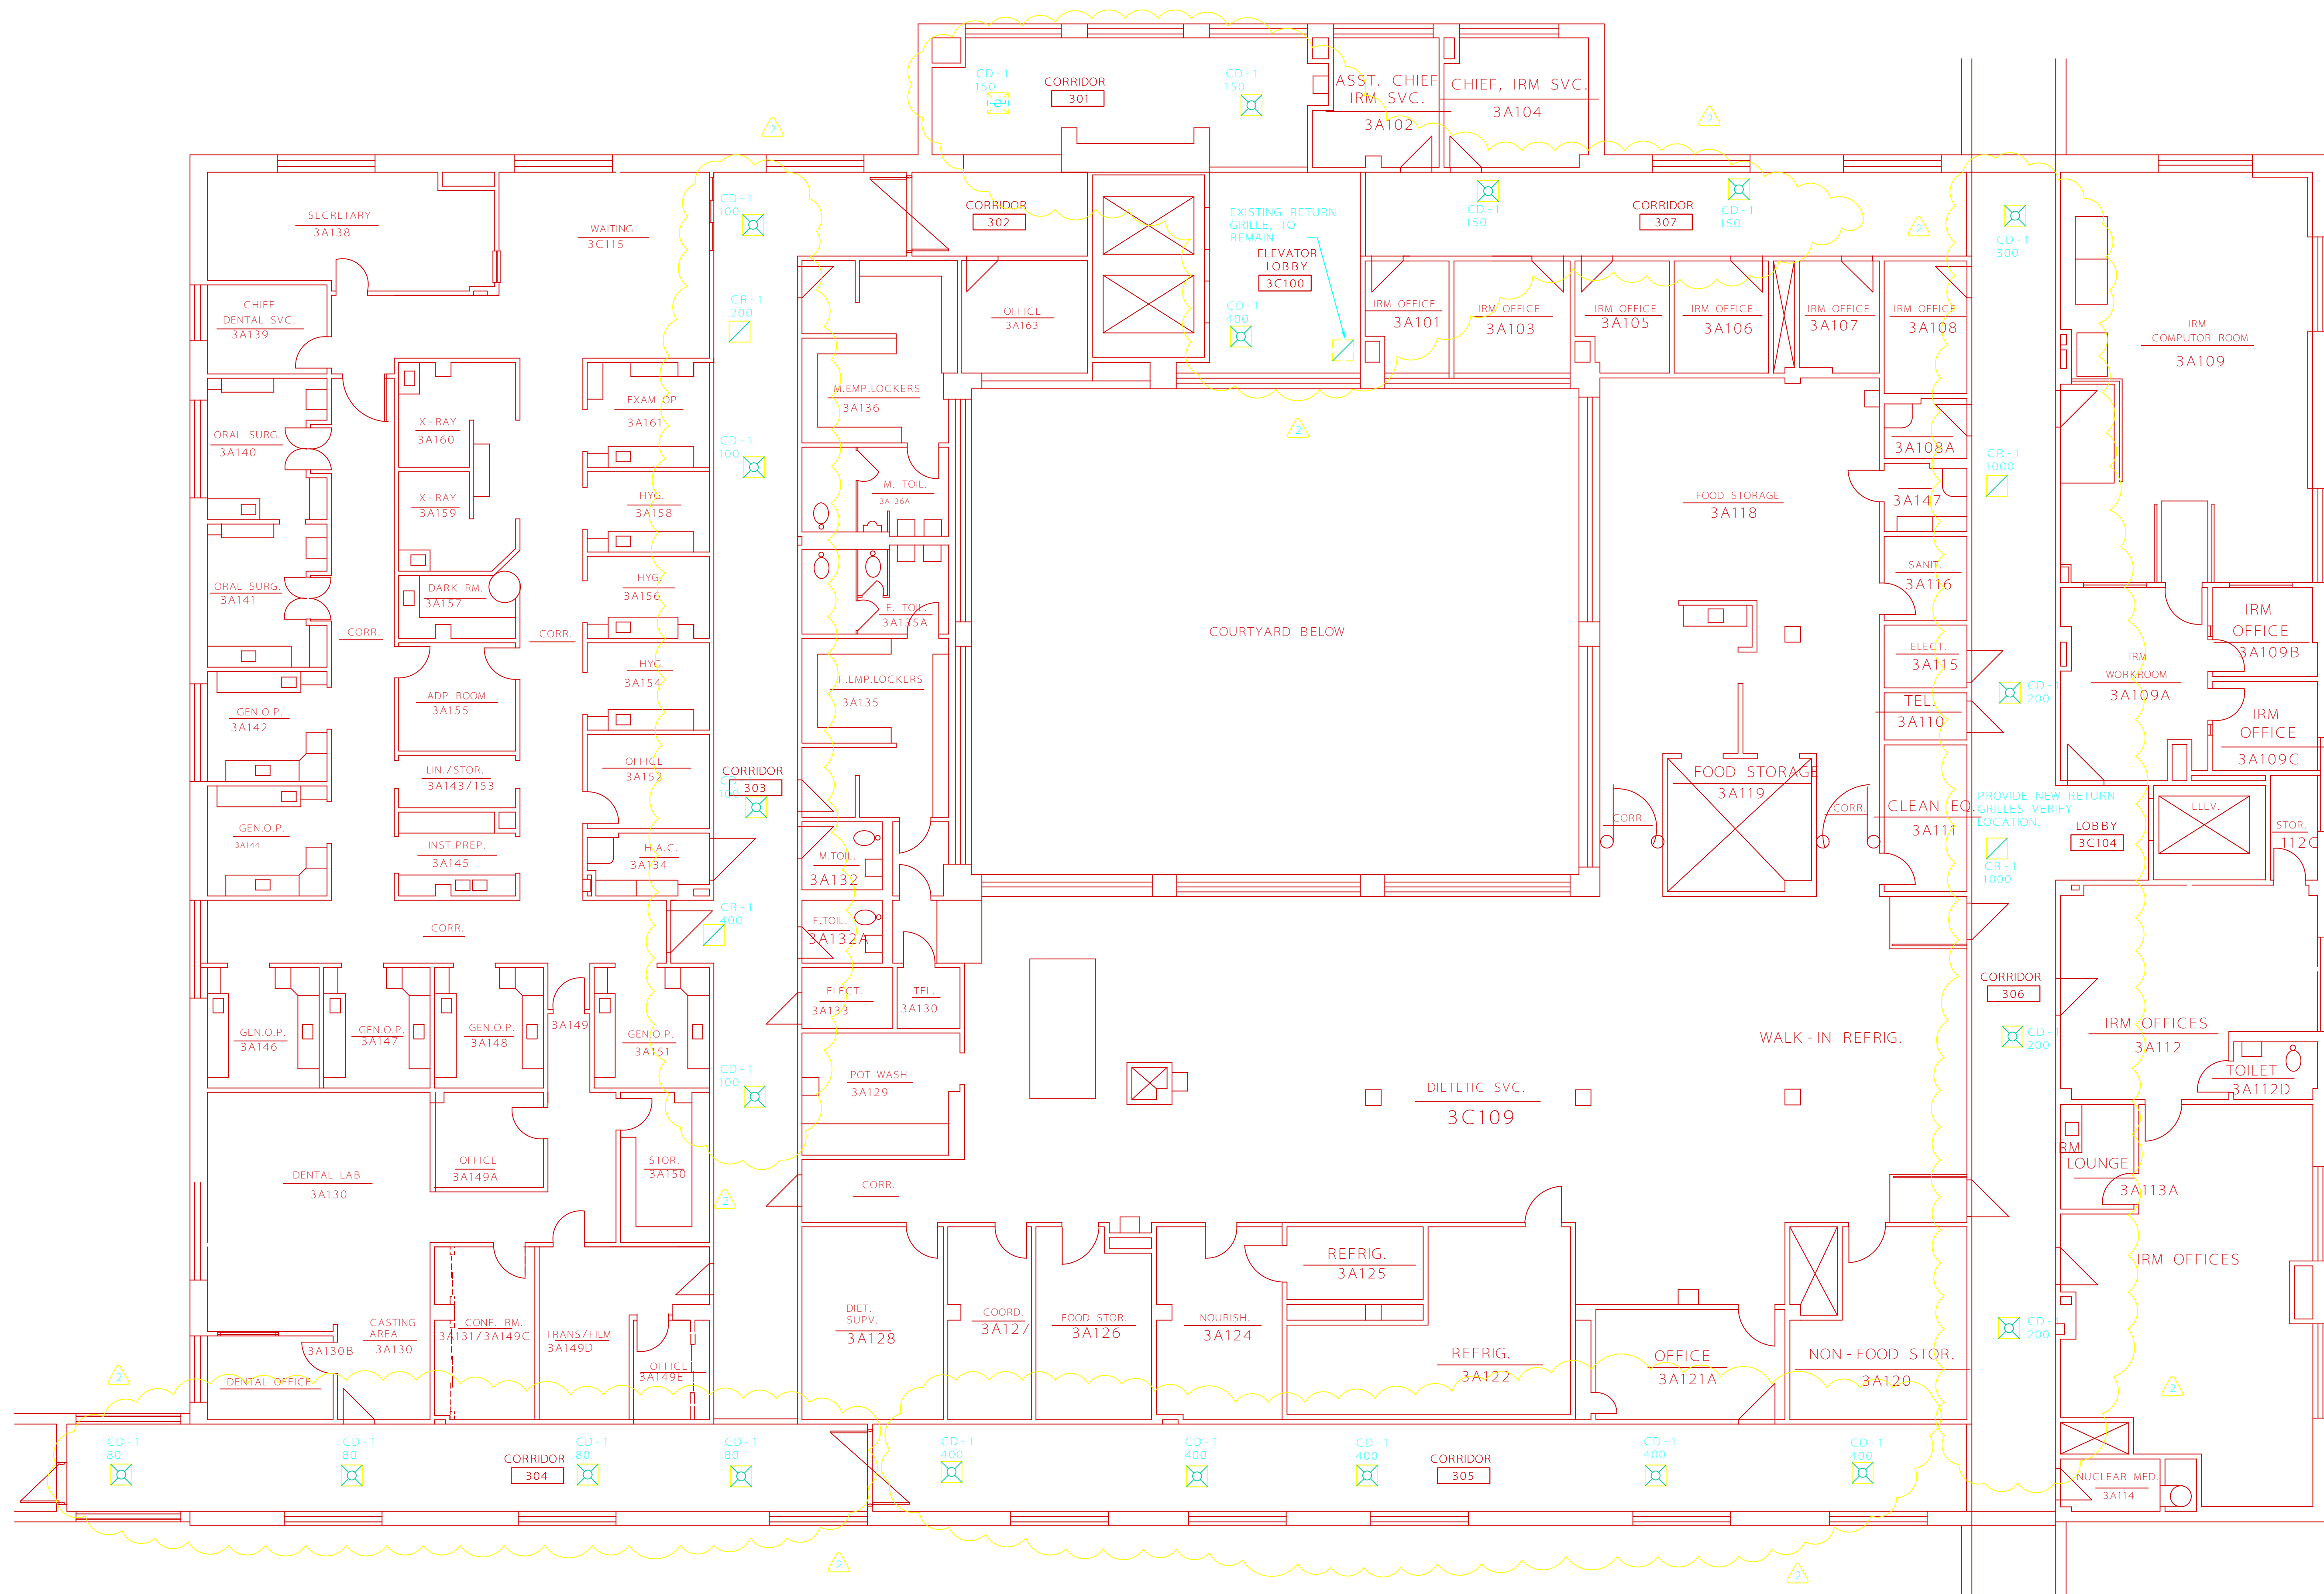

BUILDING 77 THIRD FLOOR HVAC PLAN

SCALE: 1/8" = 1'-0"

1

ADD AIR QUANTITIES TO HVAC DIFFUSERS

5/12/04

Revisions:

**cdp**  
cockrill  
design & planning

503 market street  
knoxville, tn 37902  
v. 865 . 633 . 9058  
f. 865 . 633 . 9059  
www.cockrilldp.com

Drawing Title:  
BUILDING 77 THIRD FLOOR HVAC PLAN

Approved: Chief, Facility Mgt. Svc.  
COTR: Daniel B. Snyder III, P.E.

Approved: Chief, Facility & Plant Mgt. Div.

Project Title:  
James H. Quillen VA Medical Center  
Clinical Renovations - Bldg. 69/77

Building Number:  
77

Location:  
Mountain Home, TN

Checked by:  
GAF

Drawn by:  
JDG

Date: 05/12/04

Project No.:  
621-03-101

Drawing No.:  
77-M1.3

Dwg \_\_\_\_ of \_\_\_\_

GREGORY A. FARMER  
MECHANICAL ENGINEER  
200 W. HORTONDALE ROAD  
KNOXVILLE, TN 37910-1211  
(615) 584-0000 (EXT. 1200)  
(615) 584-5233 (FAX)  
(615) 584-1000 (CELL)

Department of  
Veterans Affairs