


three inches = one foot
one and one half inches = one foot
one inch = one foot
three quarters inch = one foot
one half inch = one foot
one eighth inch = one foot
one quarter inch = one foot
one eighth inch = one foot

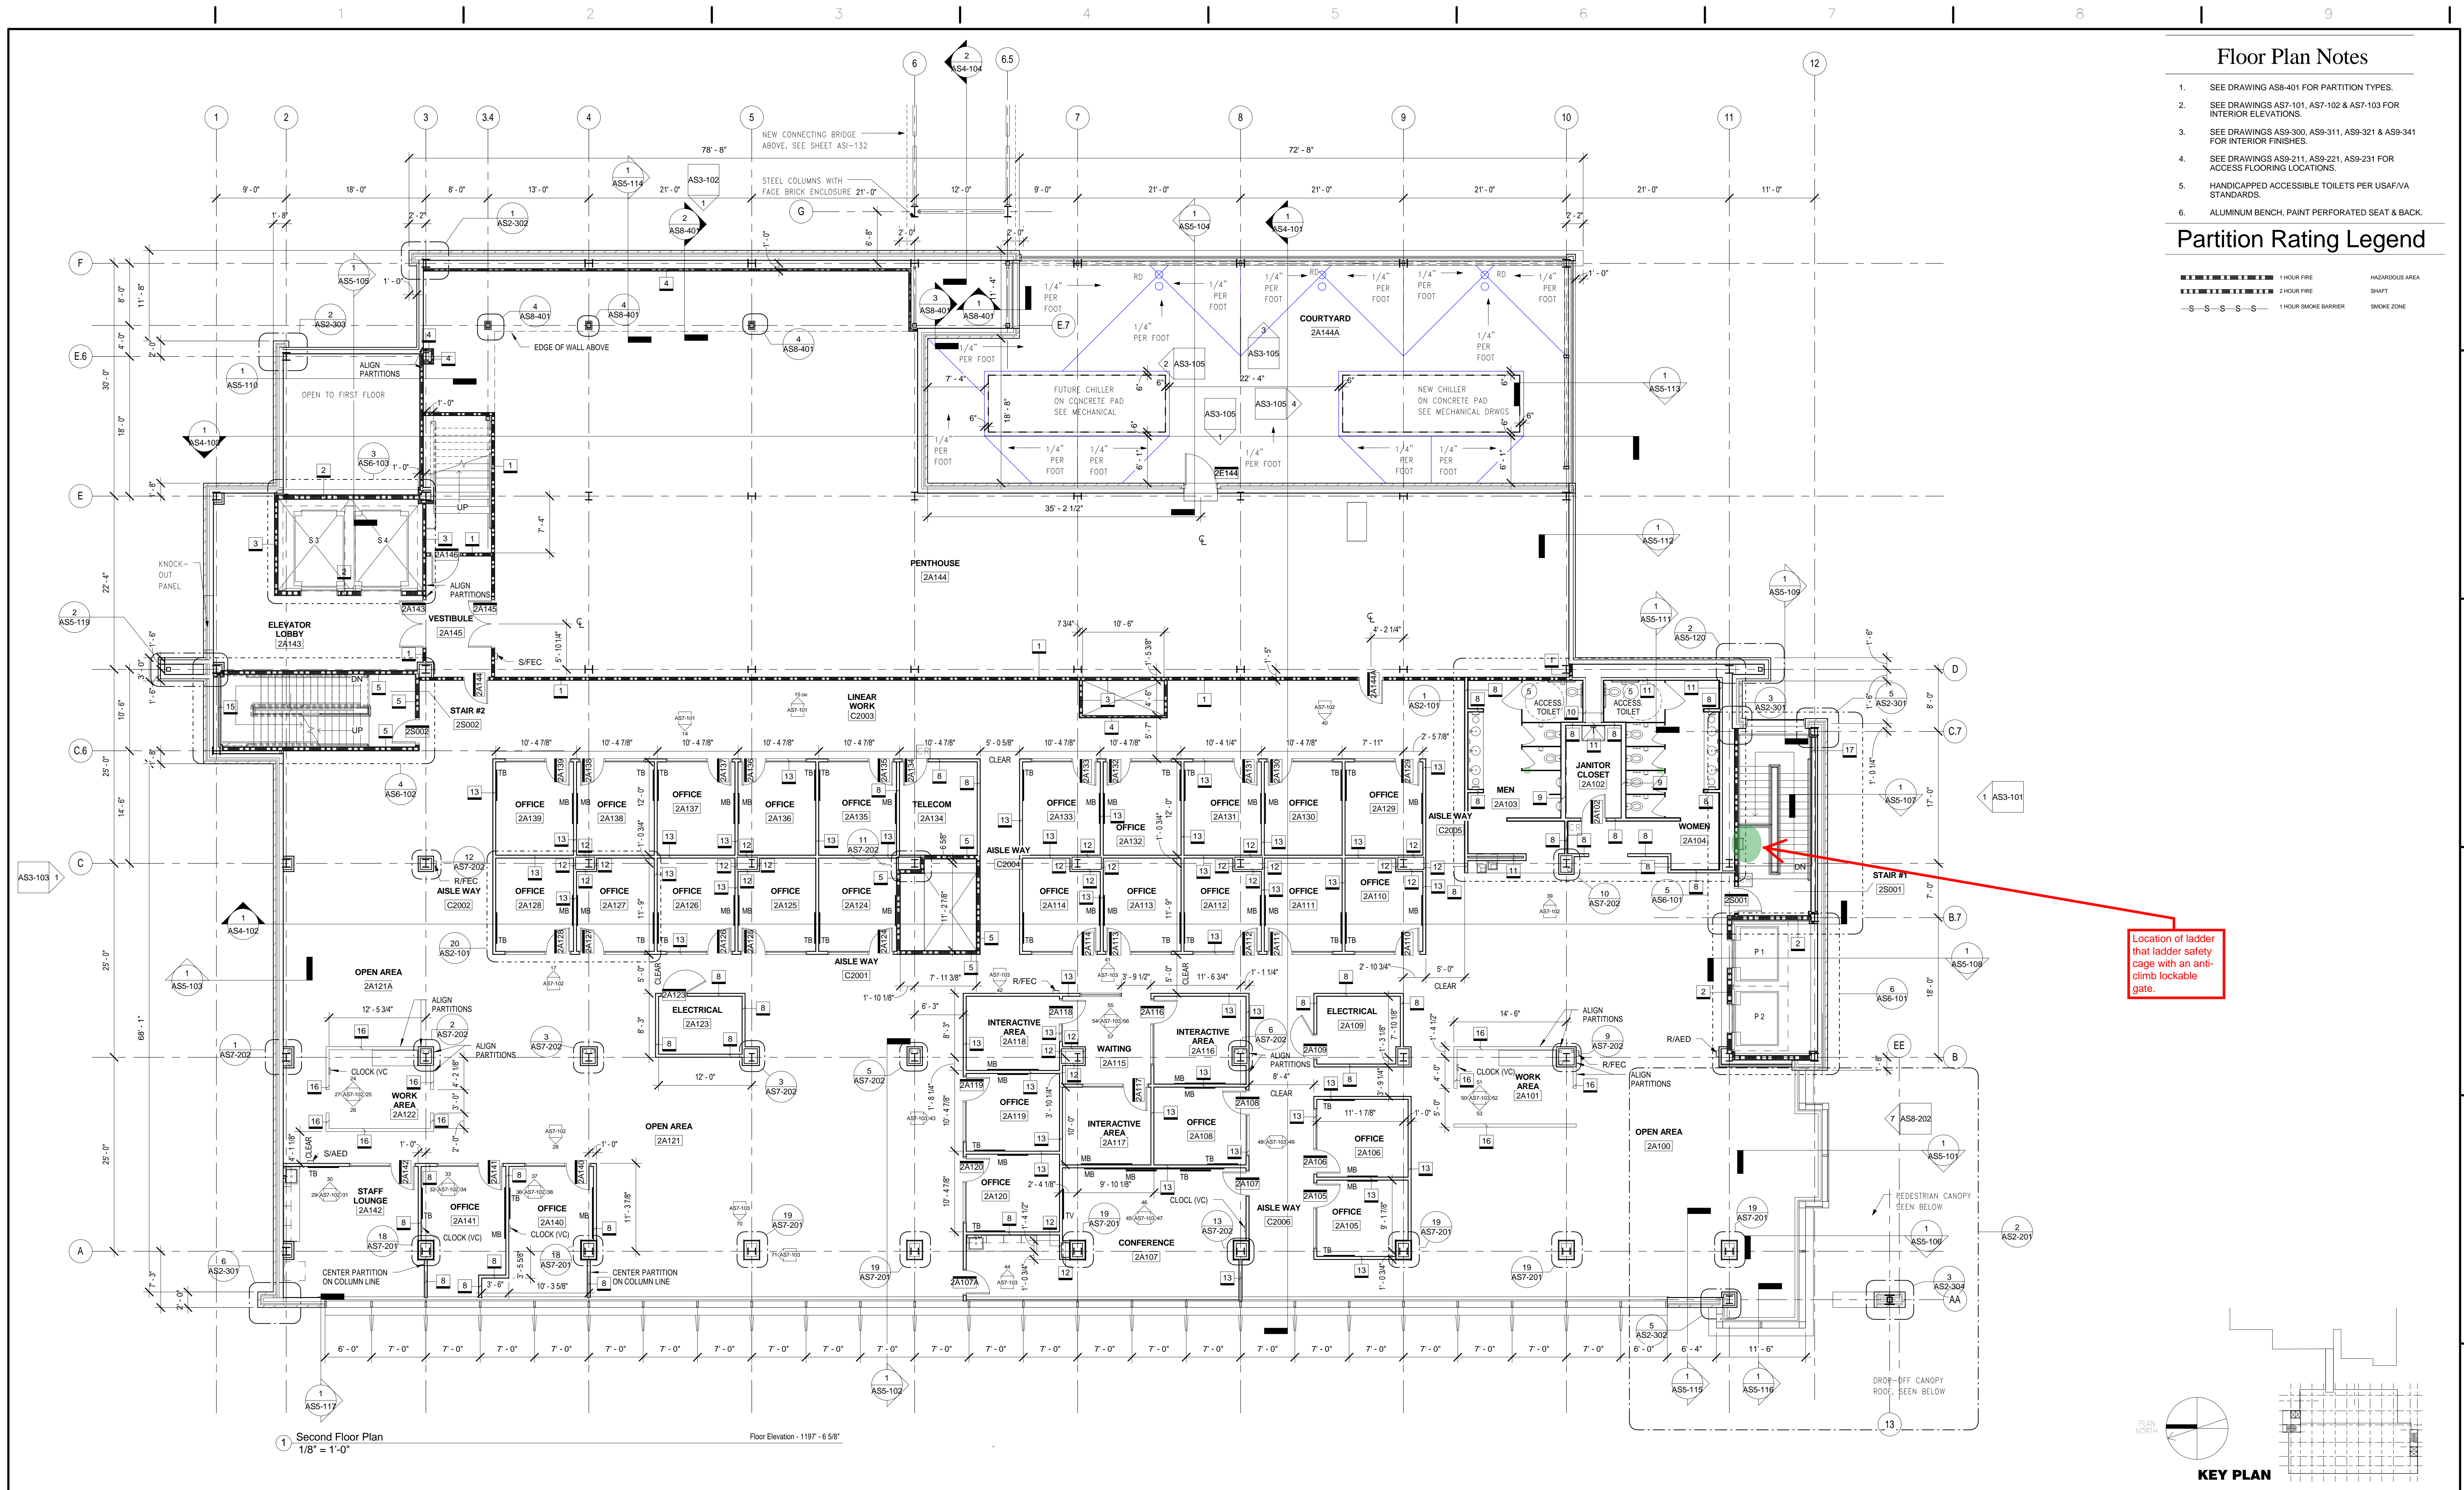

- ### Floor Plan Notes
- SEE DRAWING AS8-401 FOR PARTITION TYPES.
 - SEE DRAWINGS AS7-101, AS7-102 & AS7-103 FOR INTERIOR ELEVATIONS.
 - SEE DRAWINGS AS9-300, AS9-311, AS9-321 & AS9-341 FOR INTERIOR FINISHES.
 - SEE DRAWINGS AS9-211, AS9-221, AS9-231 FOR ACCESS FLOORING LOCATIONS.
 - HANDICAPPED ACCESSIBLE TOILETS PER USAF/VA STANDARDS.
 - ALUMINUM BENCH, PAINT PERFORATED SEAT & BACK.
- ### Partition Rating Legend
- | | |
|----------------------|----------------|
| 1 HOUR FIRE | HAZARDOUS AREA |
| 2 HOUR FIRE | SMOKE ZONE |
| 1 HOUR SMOKE BARRIER | |

Location of ladder that ladder safety cage with an anti-climb lockable gate.

CONSULTANTS: HDR HDR Architecture, Inc. 1101 King Street Suite 400 Alexandria, Virginia 22314-2944 703.518.8500		ARCHITECT/ENGINEERS: ARCHITECTURE ENGINEERING INTERIOR DESIGN DESIGN/BUILD ASTORINO 227 First Pitt Boulevard, Pittsburgh, Pennsylvania 15222 TEL: 412.765.1700 FAX: 412.765.1711 www.astorino.com		SECOND FLOOR PLAN Approved: Project Director		VA CARES CONSOLIDATION VAMC, PITTSBURGH, PA RESEARCH OFFICE BLDG. Location: VAPHS UNIVERSITY DRIVE Date: 08-18-2010 Checked: Author: Dwg. of		Office of Facilities Management Department of Veterans Affairs	
Revisions:		Project Number 646CA2500R		Building Number 30		Drawing Number AS1-131			
Date									