

ADDENDUM #3 – REVISIONS TO THE CONTRACT DOCUMENTS

Grand Junction VA Medical Center PM&RS and Prosthetics Center

Specifications

Item 1: Change to 01 00 00 General Requirements

Delete Subsection 1.2 B. and C., Statement of Bid Item(s), and replace with the following:

1.2 STATEMENT OF BID ITEM(S)

B. CHANGE NO.1: Eliminate Surface Parking Area.

Change No. 1 includes eliminating from the project the construction of all improvements associated with the proposed parking lot within the limits as delineated on sheet 38-CS-101.


Change No. 1 shall include:

- clearing and grubbing;
- tree and misc. demolition;
- subgrade preparation;
- rough and fine grading;
- asphalt paving;
- pavement marking;
- curb & gutter;
- sidewalk; and
- parking lot lighting and associated electrical improvements (per parking lot lighting improvements on Sheet 38-ES-101 AND 38-CU-101, street lighting detail 25 and 26 on sheet 38-CG-202 and light bollard detail 24 on sheet 38-CG-202).

ALL LANDSCAPING AND ASSOCIATED IRRIGATION (PER SPECIFICATION 32 84 00) WITHIN THE CONSTRUCTION LIMITS OF CHANGE NO. 1, ADJACENT TO THE STAFF PATIO, AS SHOWN ON SHEET 38-LP-102, DETAIL 2 – ENLARGED STAFF PATIO PLAN, ARE TO BE INCLUDED IN CLIN 0001 AS A PART OF THE PROJECT.

For clarification, see the following sketch identifying landscaping adjacent to the staff patio that is to remain and be included in CLIN 0001.

ADDENDUM #3 – REVISIONS TO THE CONTRACT DOCUMENTS
Grand Junction VA Medical Center PM&RS and Prosthetics Center

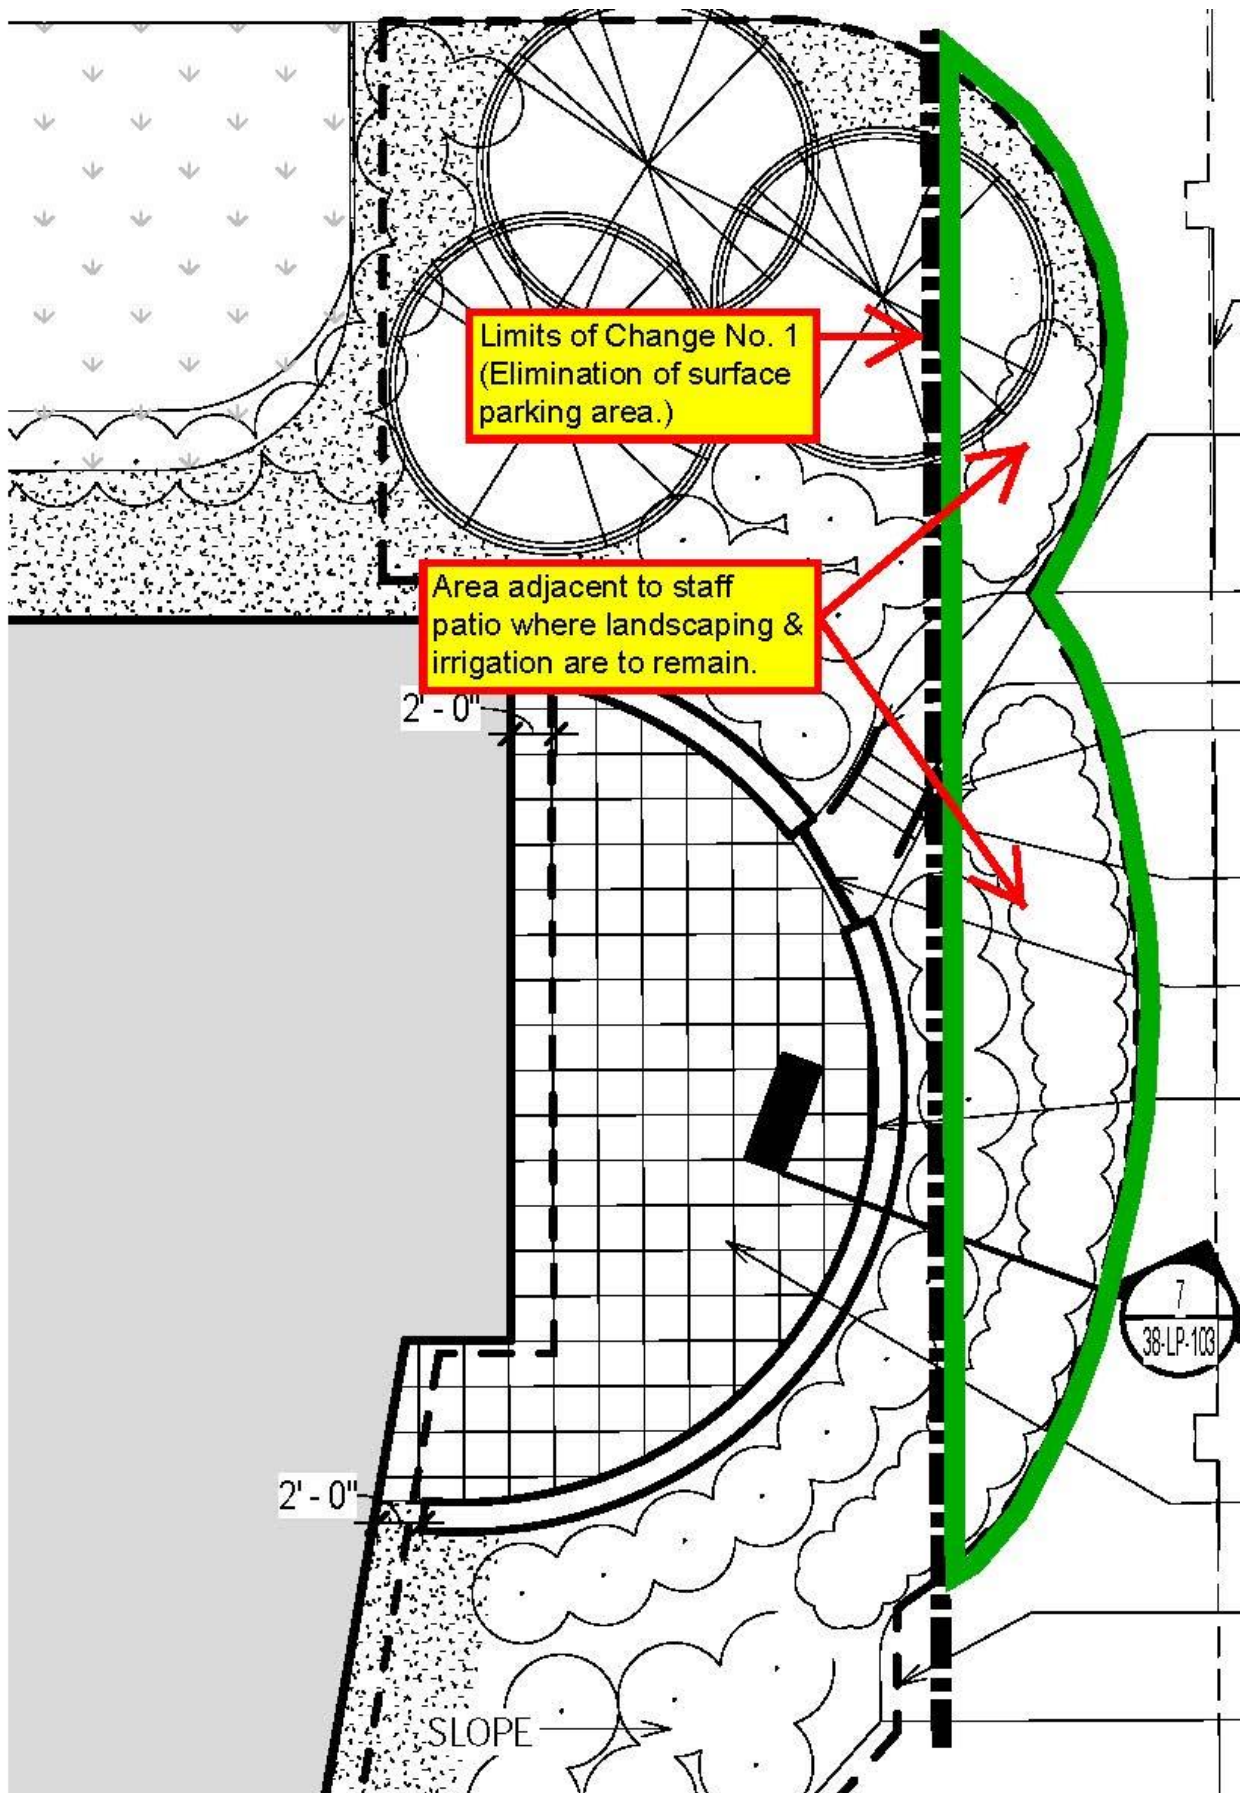

ADDENDUM #3 – REVISIONS TO THE CONTRACT DOCUMENTS

Grand Junction VA Medical Center PM&RS and Prosthetics Center

C. CHANGE NO. 2: Eliminate Detention Pond Area.

Change No. 2 includes eliminating from the project the construction of all improvements associated with the detention pond within the limits as delineated on sheet 38-CS-101. Change No. 2 also includes the elimination of SD Headwall #1 (Sta. 10+00.00, Sheet 38-CU-101), SD Drop Inlet #1 (Sta. 10+51.31 Sheet 38-CU-101), 51.31 LF of 12" HDPE SD pipe between the headwall and inlet, and 167.19 LF of 12" HDPE SD Pipe between SD Inlet #1 and SD Headwall #2 (Sta. 12+18.50, Sheet 38-CU-101). Change No.2 shall include:

- clearing and grubbing;
- demolition;
- grading;
- storm drain headwall #1 (see sheet 38-CU-101);
- storm drain drop inlet #1 (see sheet 38-CU-101);
- 12" HDPE SD pipe (see sheet 38-CU-101);
- storm drain headwall #2 (see sheet 38-CU-101);
- storm drain outlet structure (see sheet 38-CU-101);
- connection to existing SD MH (see sheet 38-CU-101);
- light bollards/conduit (see sheet 38-CU-101);
- sidewalk (see Detail 15, sheet 38-CG-202); and
- 8" PVC waterlines including valves and fittings (see sheet 38-CU-101).