




SPE

- OCCL
- CONS
- GROE
- BUILT
- HEIG
- SPRIN
- PER IBC TABL
- TOTAL ALLOW
- PER IBC SECT
- AUTOMATIC S
- TOTAL ALLOW
- TOTAL ALLOW
- 57000 SF ≥ 14

(E) BUILDING 10

- OCCUPANCY: I-2
- CONSTRUCTION TYPE: TYPE I-B
- SQUARE FOOTAGE: 34800 SF (NO CONNECTING CORRIDORS INCLUDED)
- SPRINKLERED

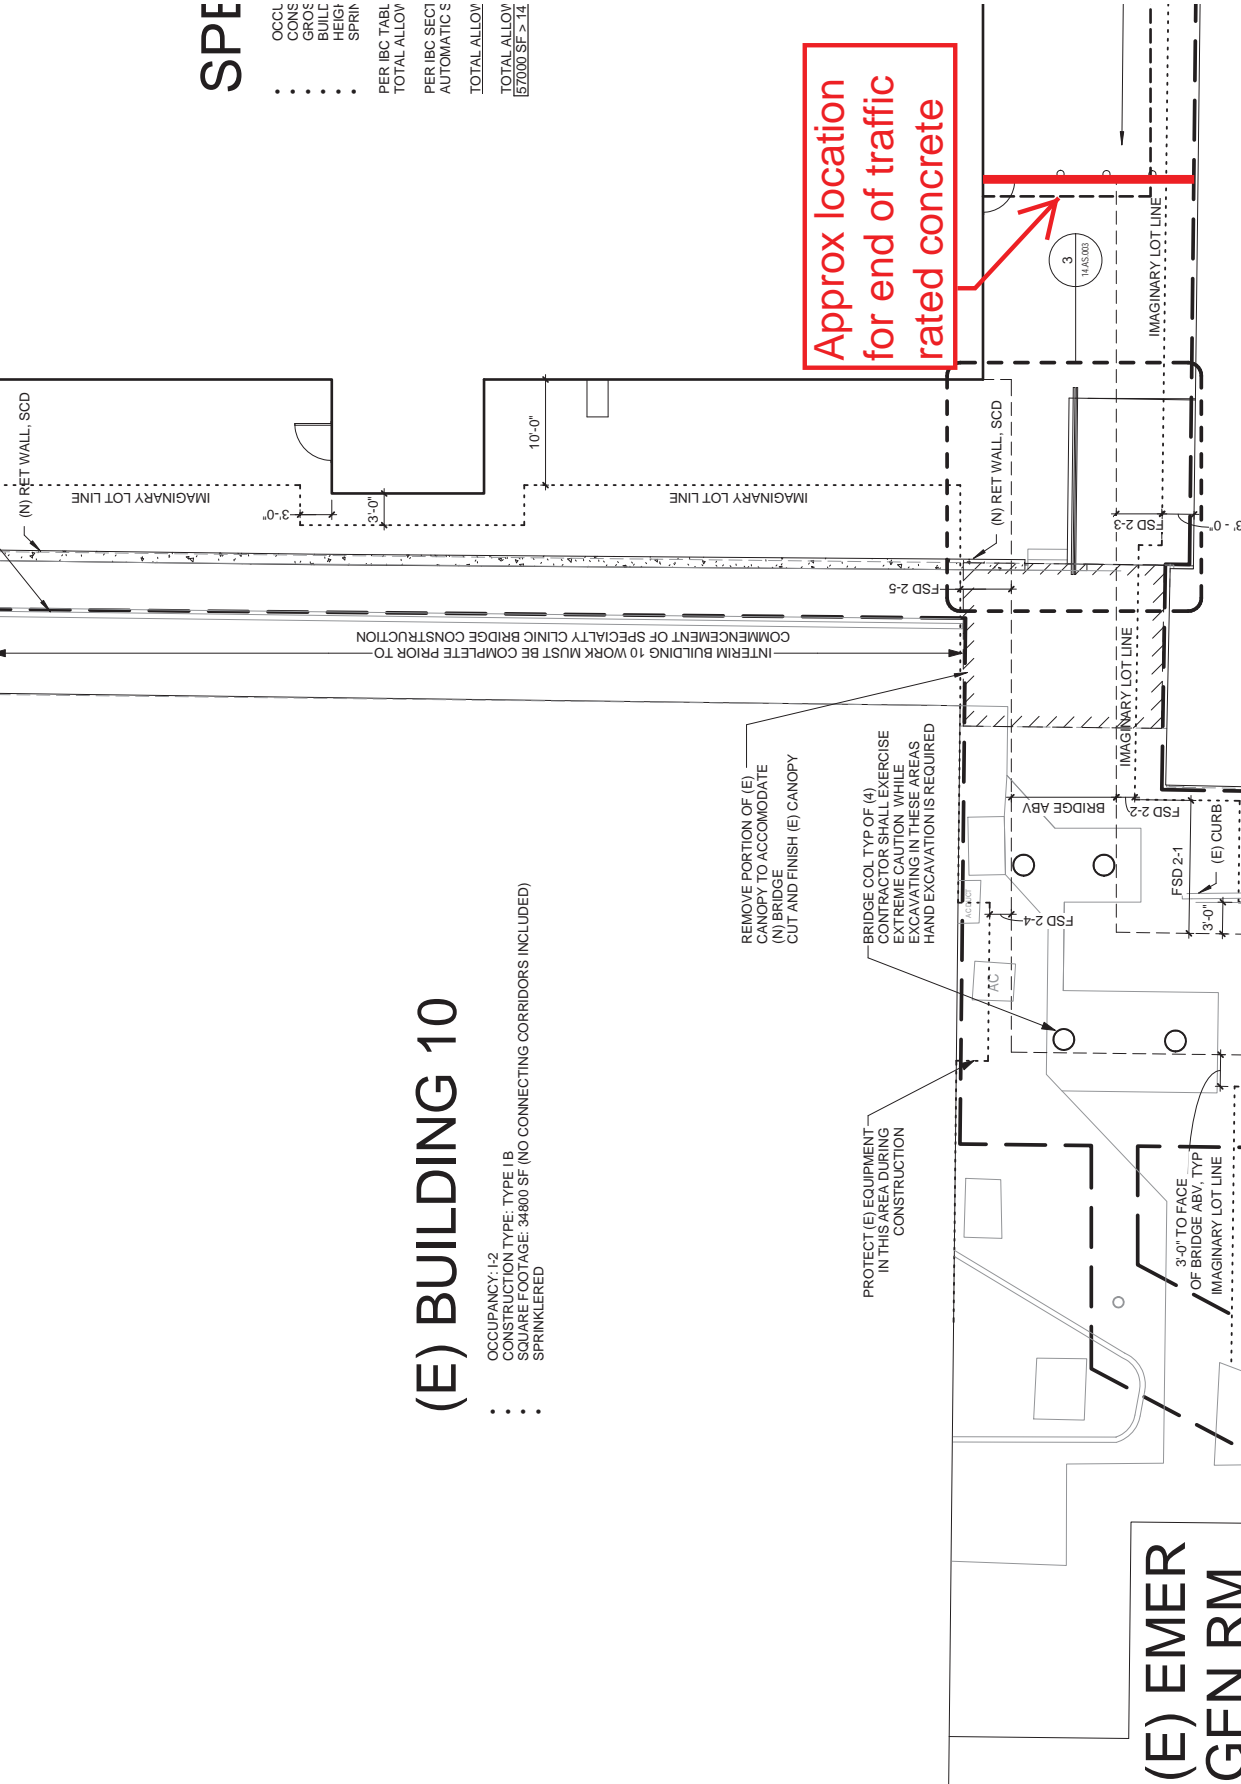

Approx location
for end of traffic
rated concrete

(E) BUILDING 1

- OCCUPANCY: UNCONFIRMED, USE SUGGESTS 'B'
- CONSTRUCTION TYPE: UNCONFIRMED TYPE I
- SQUARE FOOTAGE: UNCONFIRMED
- FLOORS: 6 FLOORS
- HEIGHT: VARIES, SEE ELEVATIONS
- SPRINKLERED

(E) WAREHOUSE EXPANSION

- OCCUPANCY: S-2
- CONSTRUCTION TYPE: I
- SQUARE FOOTAGE AND FLOORS: 3289, 1 FLOOR
- HEIGHT: 15 FEET
- SPRINKLERED

(E) EMER
GEN RM

- OCCUPANCY: UNCONFIRMED
- CONSTRUCTION TYPE: UNCONFIRMED
- SQUARE FOOTAGE: 400
- HEIGHT: SEE BUILDING 10

REF VA DRAWINGS 6/17/81

TRANSFORMERS AND SWITCH, SCD, SED