



1. Refer to Civil Drawings for site demolition and additional construction information.
2. [next Description]

- [illegible]

Site Demolition Notes


The Contractor shall design the grout to create a positive slope away from the building. Landscaped areas will be graded to create a positive slope away from the building.

6. Any new curing of existing concrete walls/grout and all concrete to be retained jointly. The existing masonry or grout is approximate and may not be fully laid out. Contractor shall verify all existing concrete walls/grout and all concrete to be retained jointly. Existing masonry walls with joints repaired with new existing concrete and repair to match existing.
7. Replace all concrete walls to be cut and repair a match existing. Where cuts and gullies are needed to be removed ensure that the new lines match existing.
8. Remove Asphalt Concrete (AC) Paving that is required to match base and thickness of existing.


Site Legend

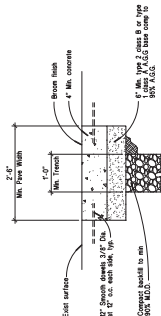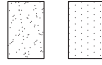

es: All cone removal and replacement shall be to saw-cut lines and shall be done by excavation contractor or subcontractor. All saw-cuts shall be vert and in straight lines parallel or perpendicular to trench, or to satisfaction of the resident engineer.

Depth of base to be 6" min. or match exist base if greater.

1 Typical Trench Patch

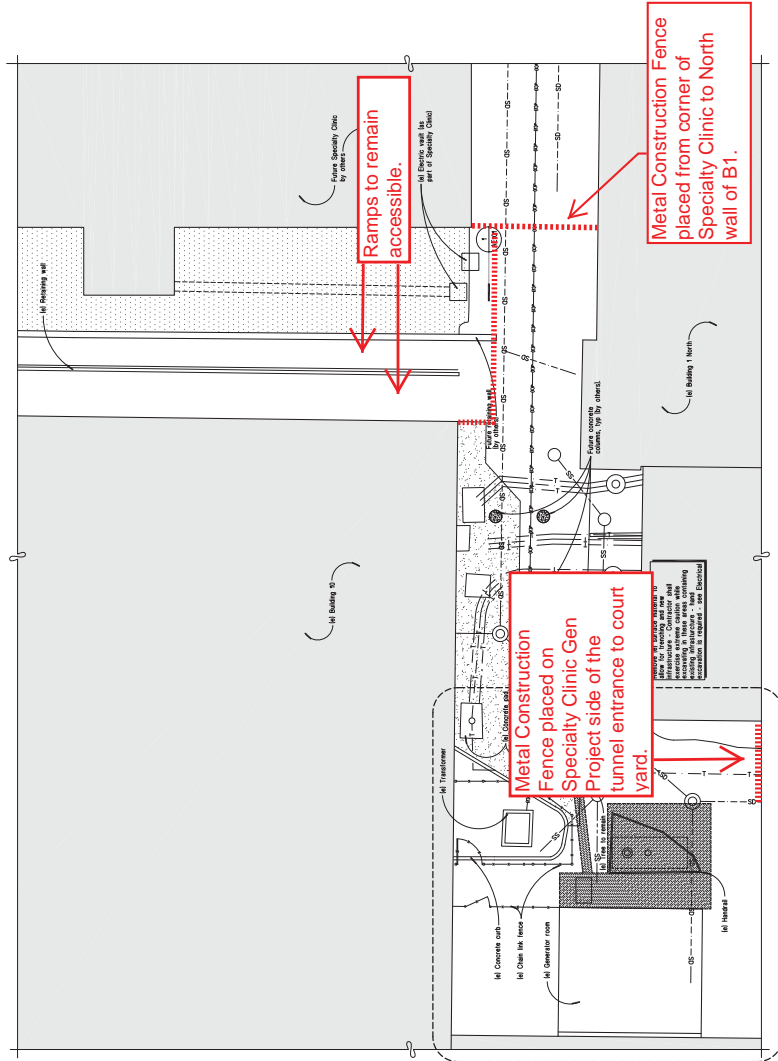

2 Site Plan at Electrical Trench

--	--

CONSULTANTS:



ARCHITECT/ENGINEERS:
H+K ARCHITECTS
5485 Reno Corporate Drive, Suite 100
Reno, Nevada 89511-2262
p 775-332-6680
f 775-332-6642
h+karchitects.com



Drawings Title
OVERALL SITE PLAN

UPGRADE EMERGENCY POWER

Project Number	654-12-904
Building Number	10

Project Number	654-12-904
Building Number	10
Drawing Number	AE101



Department :