


POWER AND COMMUNICATION PLAN – FIRST FLOOR

1/8" = 1'-0"

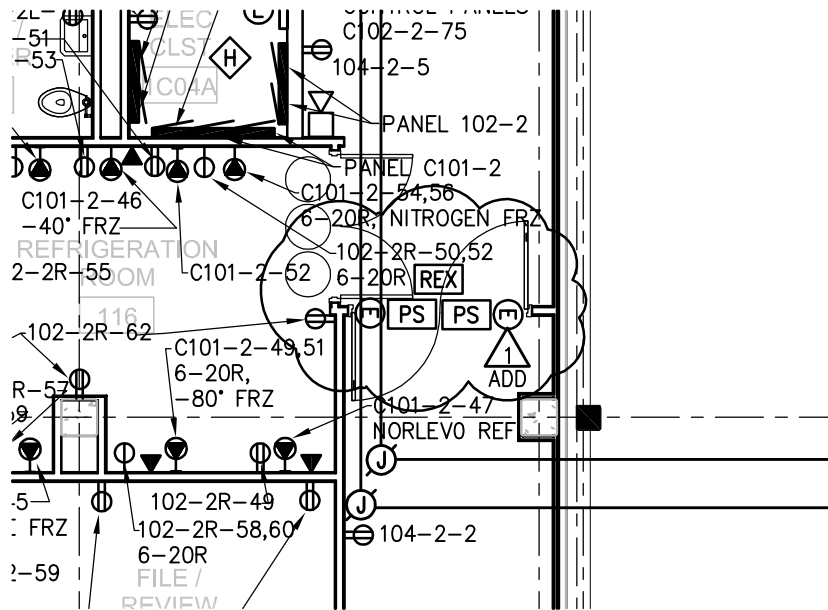

POWER AND COMMUNICATION PLAN – FIRST FLOOR

1/8" = 1'-0"

SHIVEHATTERY
ARCHITECTURE + ENGINEERING

Iowa | Illinois | Indiana | Missouri

<http://www.shive-hattery.com>

ILLINOIS FIRM NUMBER: 184-000214

TITLE1
PROJECT-TITLE
PROJECT-LOCATION

PROJECT NO.

110240-0

DRAWN

DMM

FIELD BOOK

APPROVED

JJH

REVISION

REFERENCE DRAWING

SCALE 1/8"=1'-0"

ISSUED FOR

ADD1

2-E4

SD-1