

2

1A102 - DEMO

1/4" = 1'-0"

REFER TO 2/AD101A

Amendment #1

A|E works
 6587 HAMILTON AVENUE
 PITTSBURGH, PENNSYLVANIA 15206
 PH: 412.287.7333 FAX: 412-287-7334
 www.ae-works.com

PROJECT: Upgrade Public and Staff Restrooms

OWNER: VETERANS AFFAIRS MEDICAL CENTER


10 NORTH GREENE STREET
 BALTIMORE, MD 21201

PROJECT NO.
512-12-118

DRAWN BY:
 SGB
CHECKED BY:
 RW
SCALE:
 1/4" = 1'-0"


ISSUE DATE:
 June 10, 2014

SKETCH NO:
ASK-1

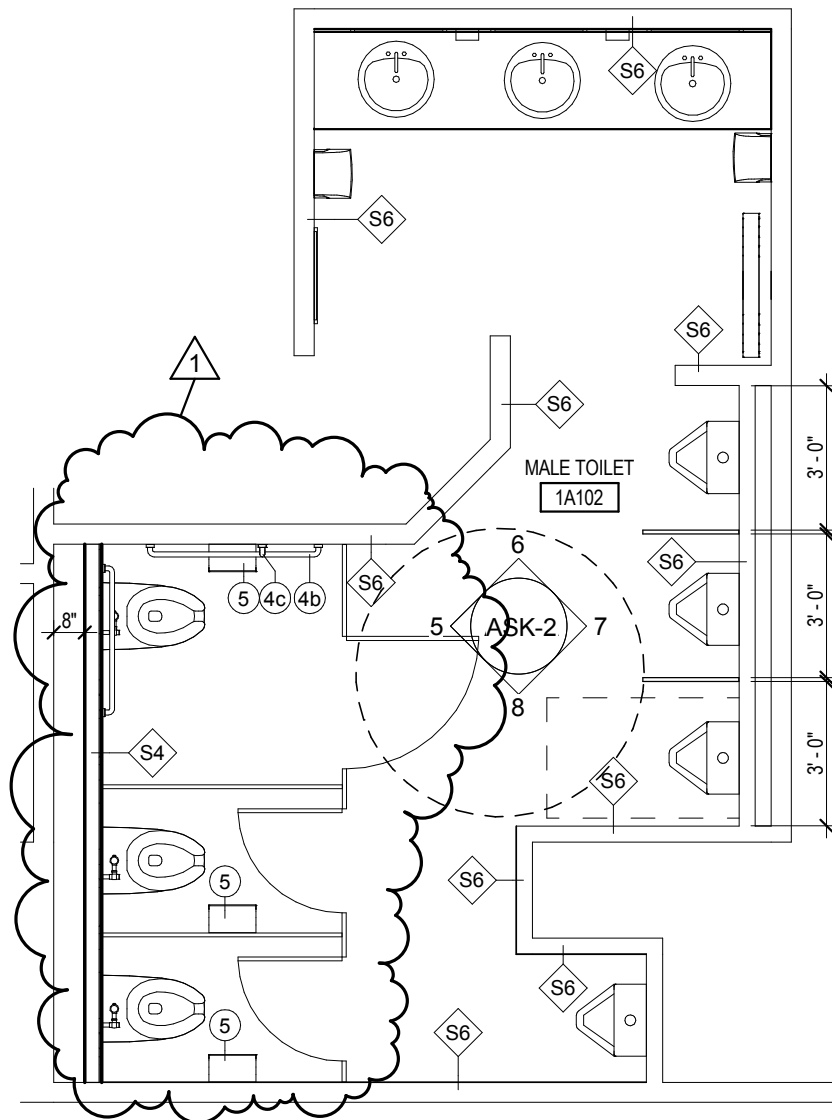

2 A102 - NEW
1/4" = 1'-0"

REFER TO 2/A101A

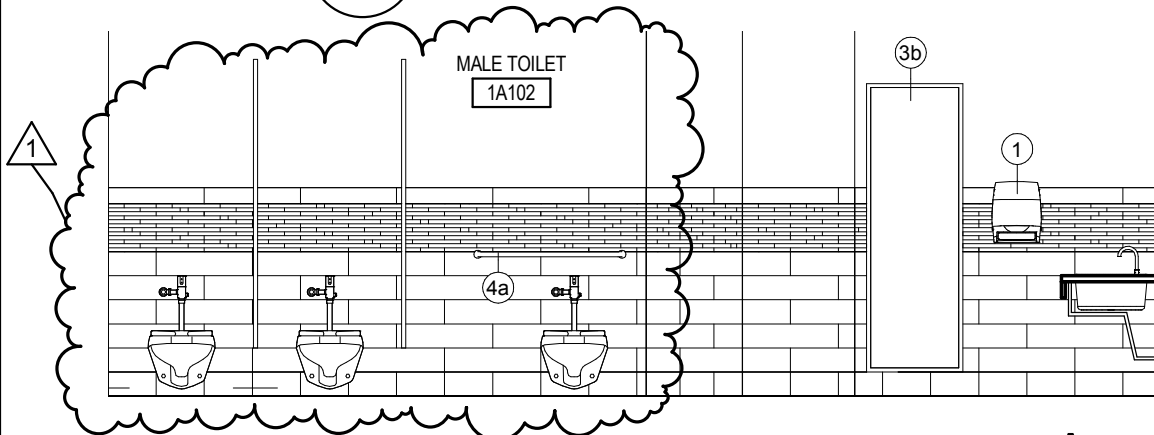

5 1A102 -W
1/4" = 1'-0"

Amendment #1

REFER TO 5/A501A

A | E works

6587 HAMILTON AVENUE
PITTSBURGH, PENNSYLVANIA 15206
PH: 412.287.7333 FAX: 412-287-7334
www.ae-works.com

PROJECT: Upgrade Public and Staff Restrooms

OWNER: VETERANS AFFAIRS MEDICAL CENTER

10 NORTH GREENE STREET
BALTIMORE, MD 21201

PROJECT NO.
512-12-118

DRAWN BY:
SGB


CHECKED BY:
RW

SCALE:
1/4" = 1'-0"

ISSUE DATE:
June 10, 2014

SKETCH NO:

ASK-2

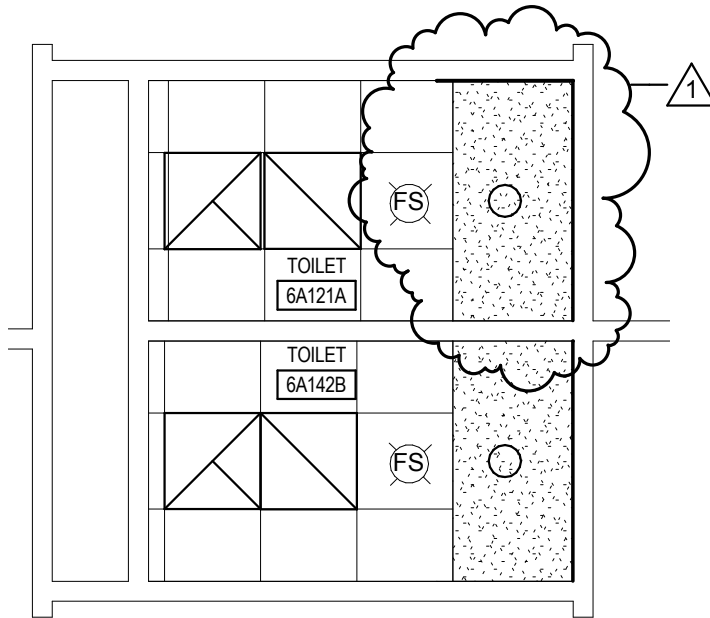

2


6A121A & 6A142B - RCP

1/4" = 1'-0"

REFER TO 2/A116A

Amendment #1

 6587 HAMILTON AVENUE PITTSBURGH, PENNSYLVANIA 15206 PH: 412.287.7333 FAX: 412-287-7334 www.ae-works.com	PROJECT: Upgrade Public and Staff Restrooms OWNER: VETERANS AFFAIRS MEDICAL CENTER 10 NORTH GREENE STREET BALTIMORE, MD 21201	PROJECT NO. 512-12-118	ISSUE DATE: June 10, 2014
		DRAWN BY: SGB	SKETCH NO: ASK-3
		CHECKED BY: RW	
		SCALE: 1/4" = 1'-0"	

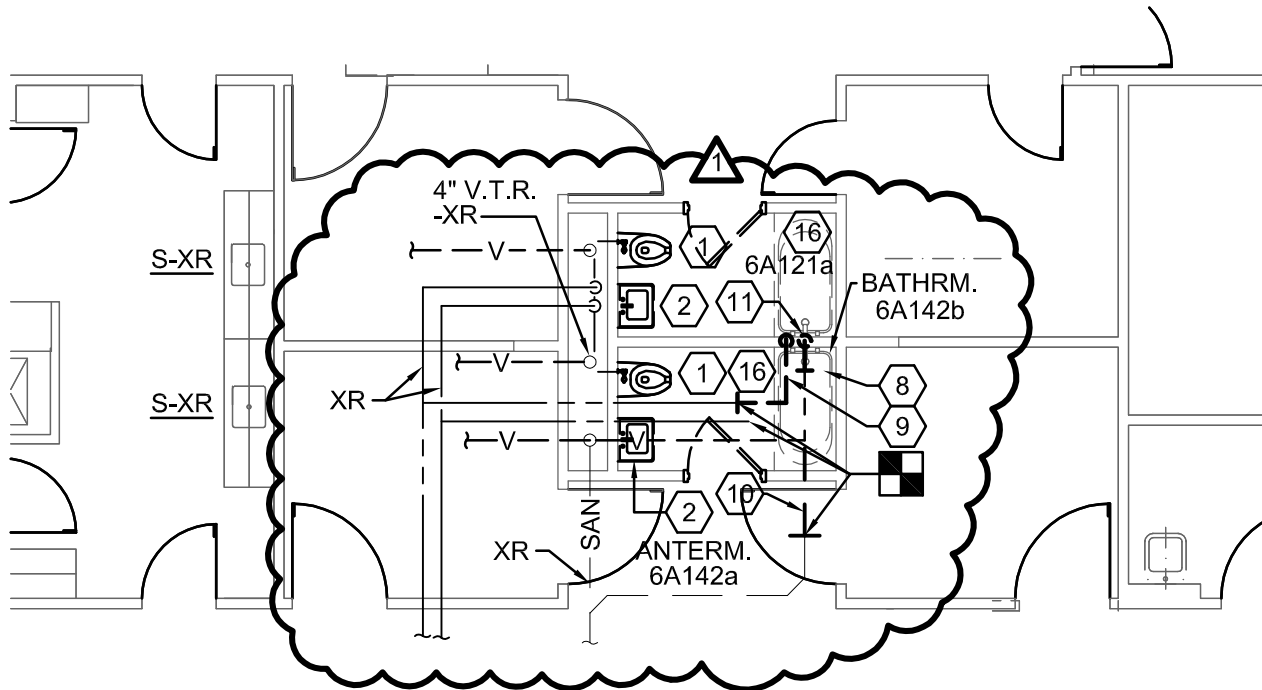

9

6A121A, 6A123, 6A142B - DEMO

SCALE = $\frac{1}{8}$ " = 1'-0"

PLUMBING DEMOLITION KEY NOTES:

16 REMOVE EXISTING BATH TUB.
 REMOVE EXISTING HOT/COLD WATER, SANITARY, AND VENT PIPING
 ASSOCIATED WITH THIS FIXTURE. REMOVE PIPING BACK TO MAINS AND CAP. 1

Amendment #1



6587 HAMILTON AVENUE
 PITTSBURGH, PENNSYLVANIA 15206
 PH: 412.287.7333 FAX: 412-287-7334
 www.ae-works.com

PROJECT: Upgrade Public and Staff Restrooms

OWNER: VETERANS AFFAIRS
 MEDICAL CENTER
 10 NORTH GREENE STREET
 BALTIMORE, MD 21201

PROJECT NO.
 512-12-118

ISSUE DATE:
 June 10, 2014


DRAWN BY:
 MEW

SKETCH NO.:

CHECKED BY:
 MEW

SCALE:
 AS NOTED

PSK-1

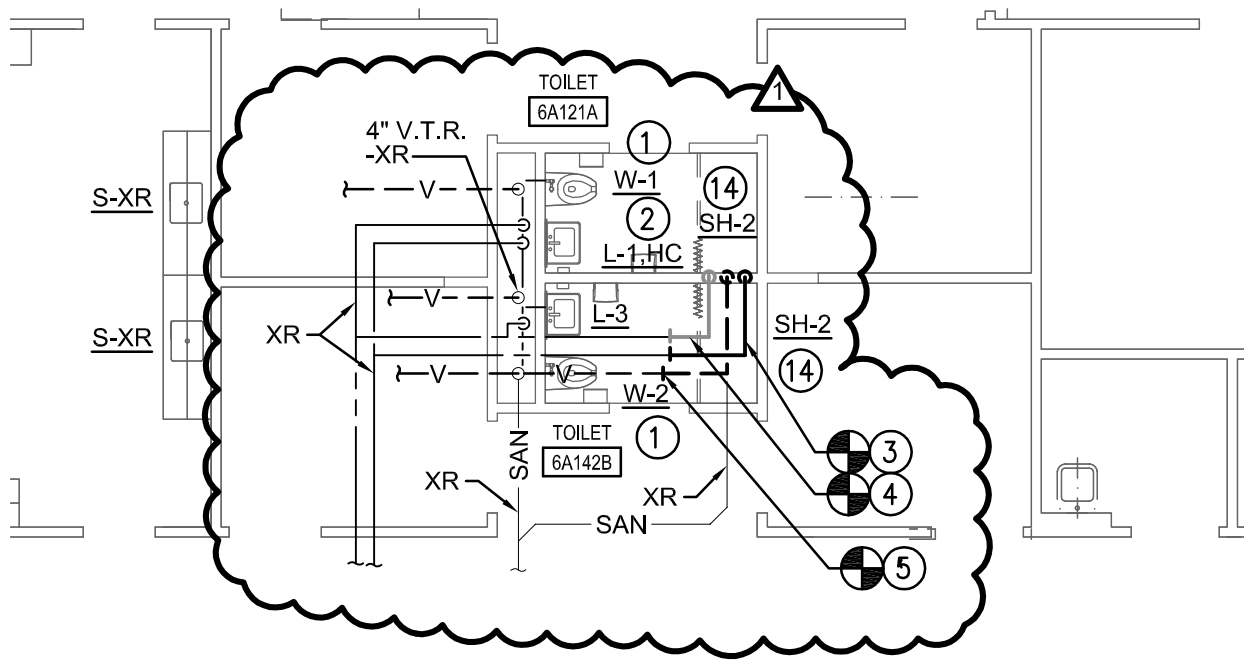


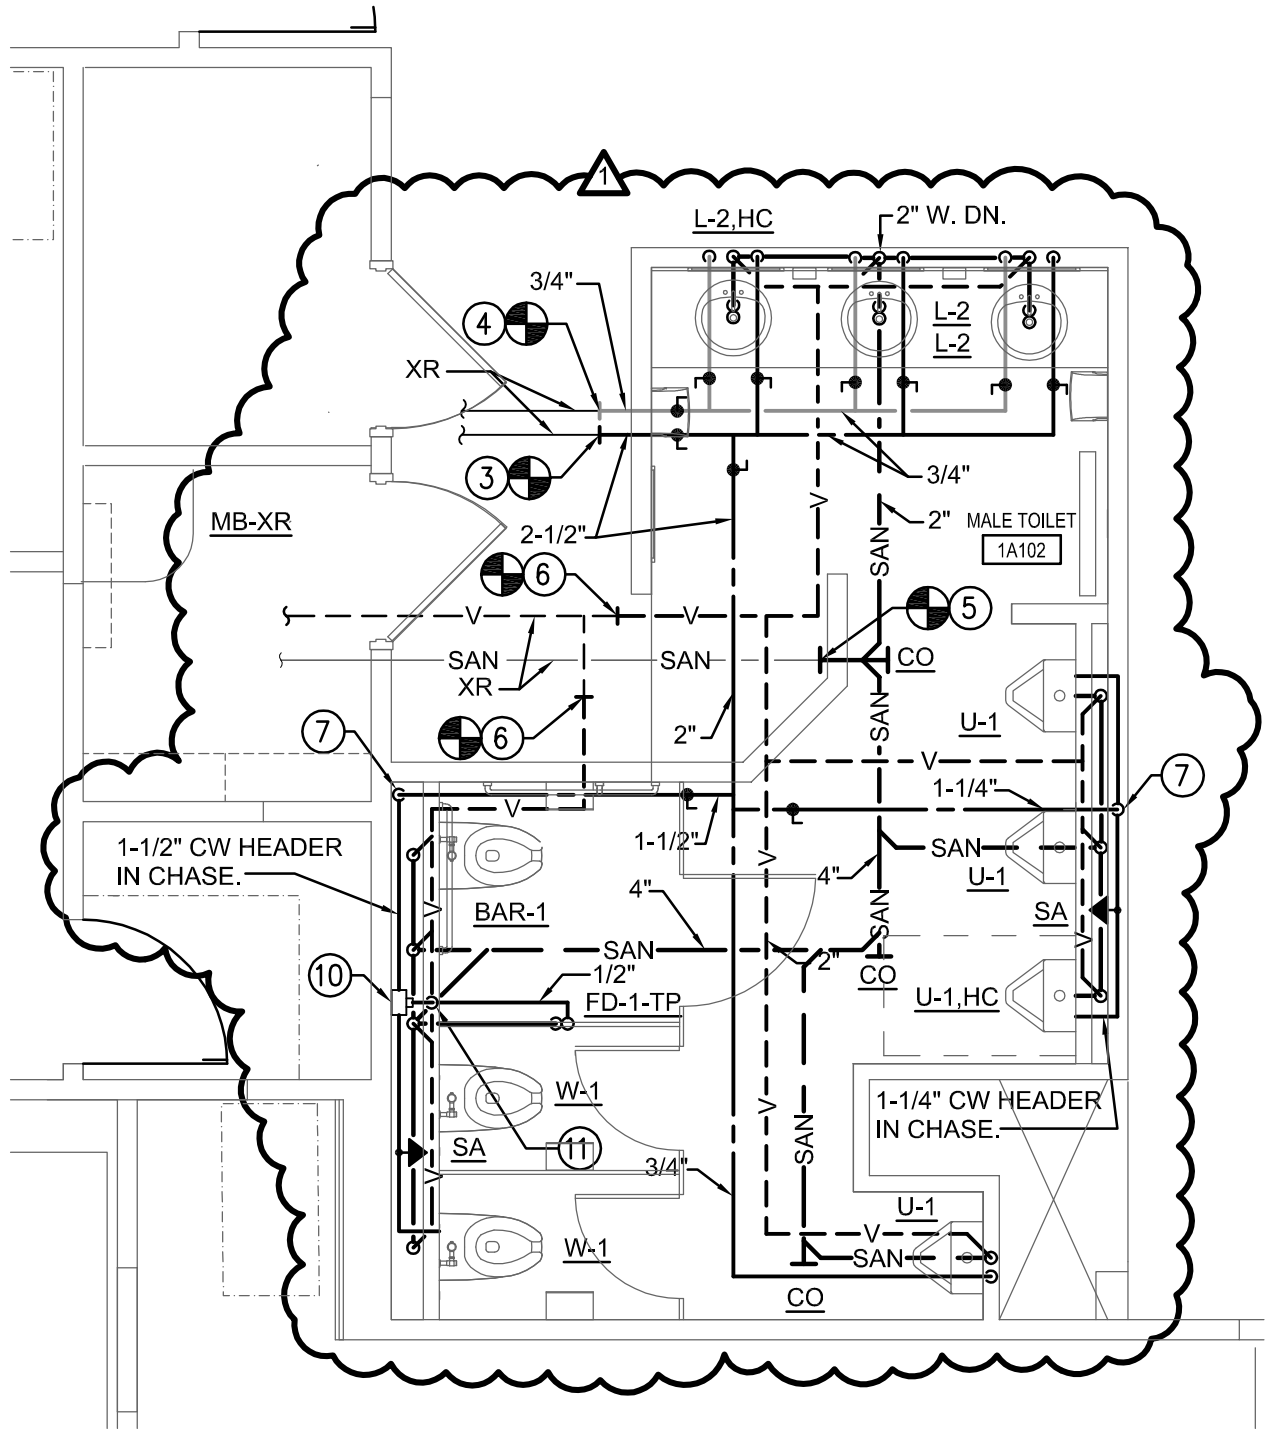
9

6A121A, 6A123, 6A142B - NEW WORK

SCALE = 1/8" = 1'-0"

Amendment #1

 <p>6587 HAMILTON AVENUE PITTSBURGH, PENNSYLVANIA 15206 PH: 412.287.7333 FAX: 412-287-7334 www.ae-works.com</p>	<p>PROJECT: Upgrade Public and Staff Restrooms</p>	<p>PROJECT NO. 512-12-118</p>	<p>ISSUE DATE: June 10, 2014</p>	
	<p>OWNER: VETERANS AFFAIRS MEDICAL CENTER</p>	<p>DRAWN BY: MEW</p>	<p>SKETCH NO: PSK-2</p>	
	<p>10 NORTH GREENE STREET BALTIMORE, MD 21201</p>	<p>CHECKED BY: MEW</p>		
		<p>SCALE: AS NOTED</p>		



7

1B155 & 1B156 - NEW WORK

SCALE = 1/4" = 1'-0"

Amendment #1

A | E works
 6587 HAMILTON AVENUE
 PITTSBURGH, PENNSYLVANIA 15206
 PH: 412.287.7333 FAX: 412-287-7334
 www.ae-works.com

PROJECT: Upgrade Public and Staff Restrooms
OWNER: VETERANS AFFAIRS MEDICAL CENTER
 10 NORTH GREENE STREET
 BALTIMORE, MD 21201

PROJECT NO.
512-12-118
DRAWN BY:
MEW
CHECKED BY:
MEW
SCALE:
AS NOTED

ISSUE DATE:
June 10, 2014
SKETCH NO:
PSK-3