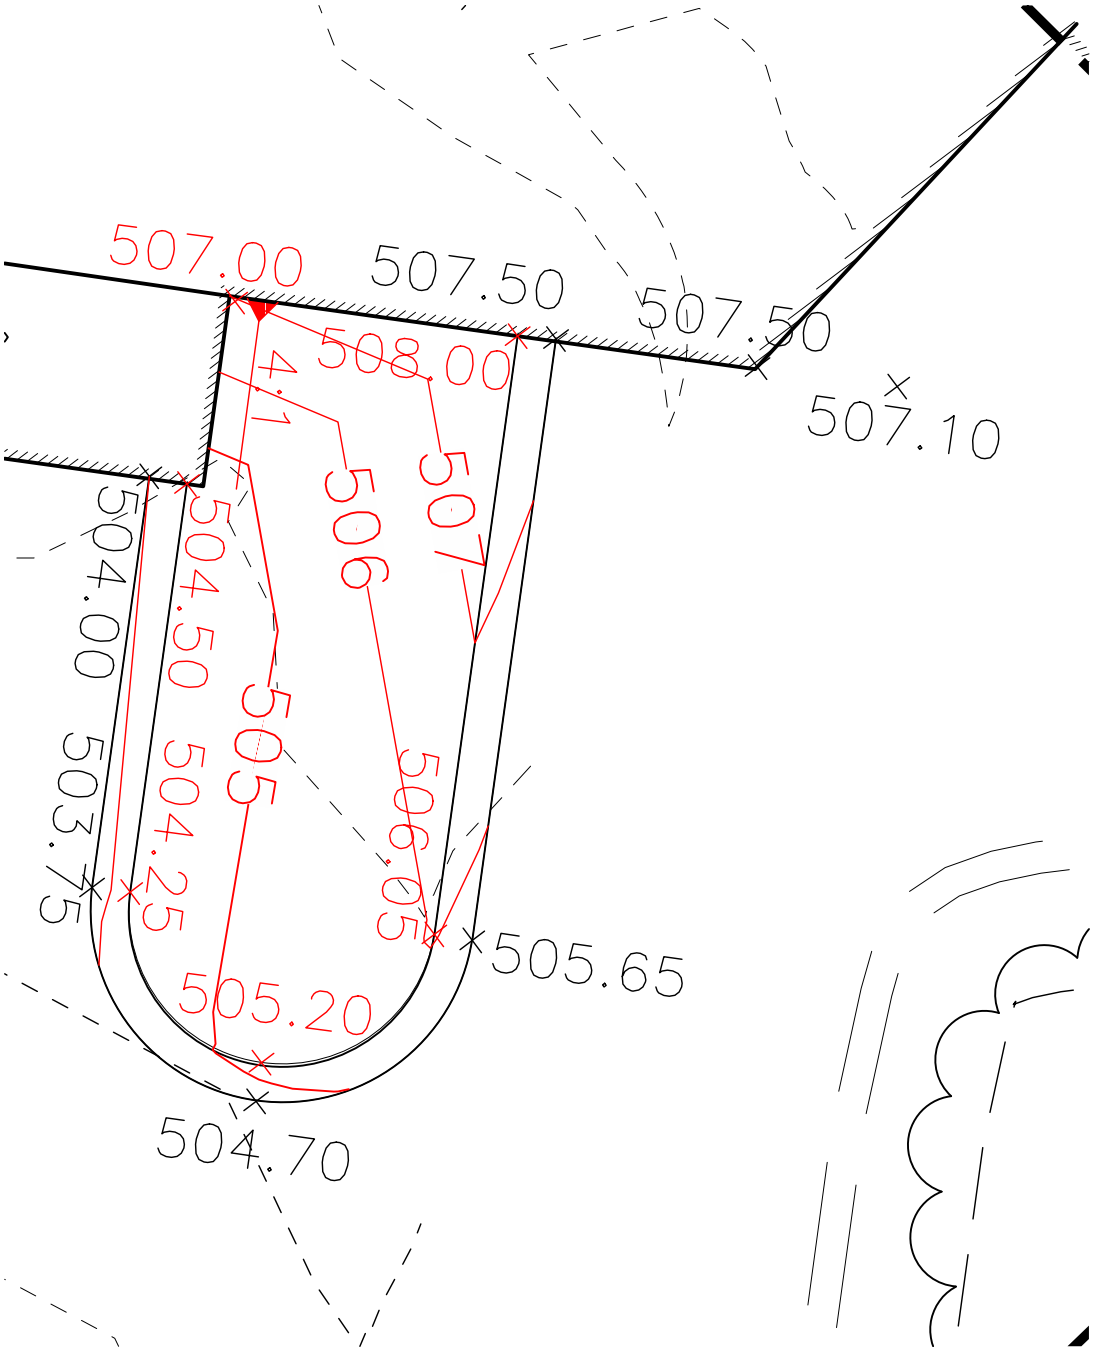
507.00
507.50
507.50
507.10
508.00
4:1
507
506
504.50
505
504.25
506.05
505.65
505.20
504.70
504.00
503.75