

DATE: JUNE, 9 2014

FROM: PFB ARCHITECTS

SUBJECT: PRE-BID REVISION No. I - SUMMARY OF ADDENDUM DOCUMENTS

PROJECT: **RELOCATE JOLIET CBOC PHASE II - BID PACKAGE C**

TO: **OWNER, CONTRACTORS**

ALL OF THE BID DRAWINGS ARE DATED 5.5.2014
PRE-BID REVISION I DATED 6.9.2014

DRAWINGS INCLUDED:



Technology:

TSK-01

Description:

Sheet T-11A – REVISED panic buttons at Reception 1017 to be new. **See TSK-01.**

– **END OF Pre-Bid Revision** –

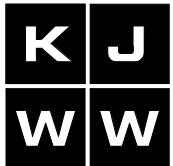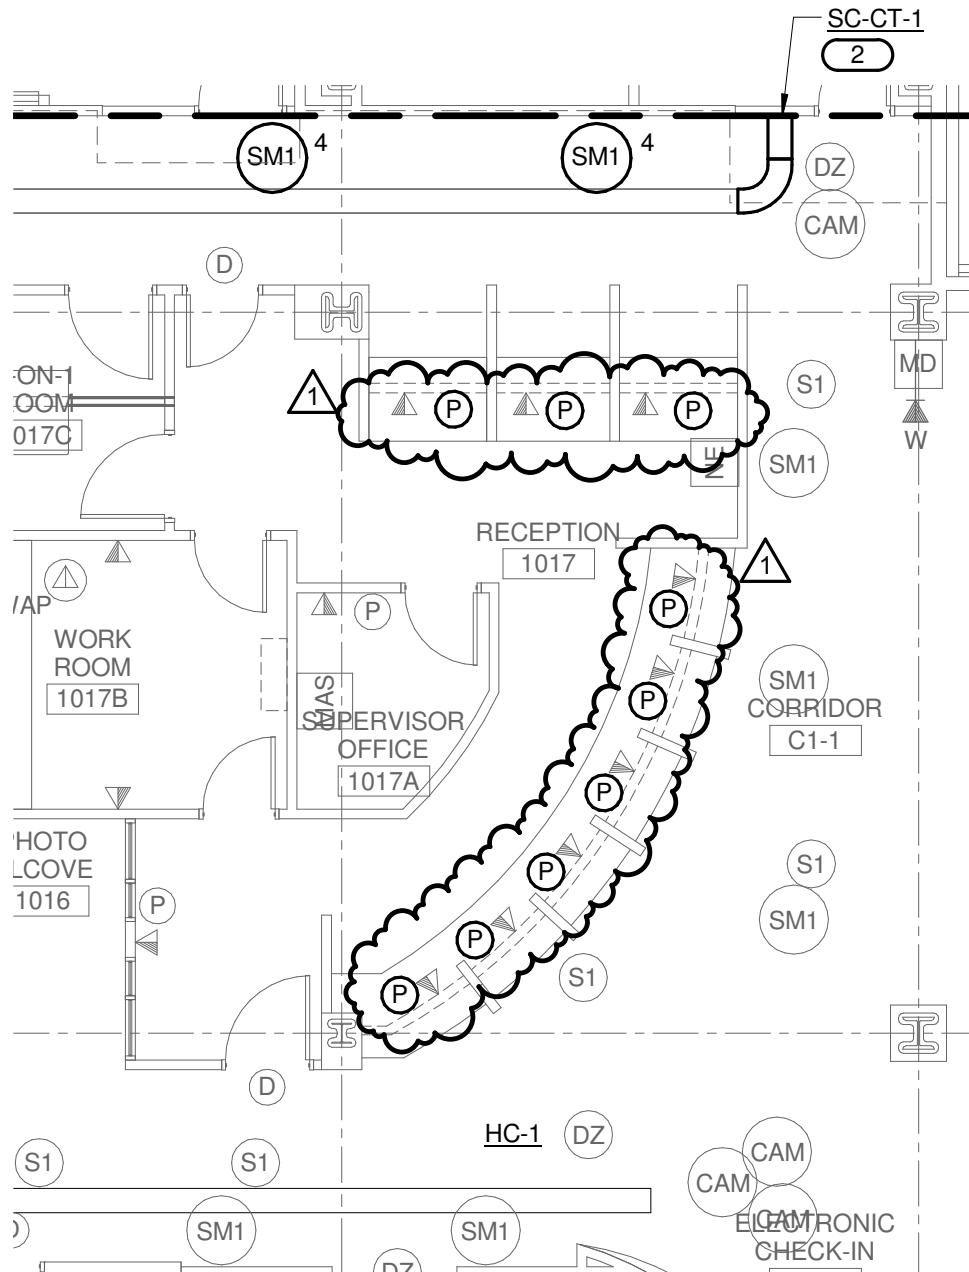

**ENGINEERING
CONSULTANTS**
Experience you can build on™

JOLIET CBOC RELOCATION

KJWW No. 12.0155.00

Date: 06/09/14

Ref. Sheet: T111A

Issue: Pre-Bid Revision 1

Ref. Description: FIRST FLOOR - AREA A - TECHNOLOGY

Supplemental Drawing
Number

TSK-01