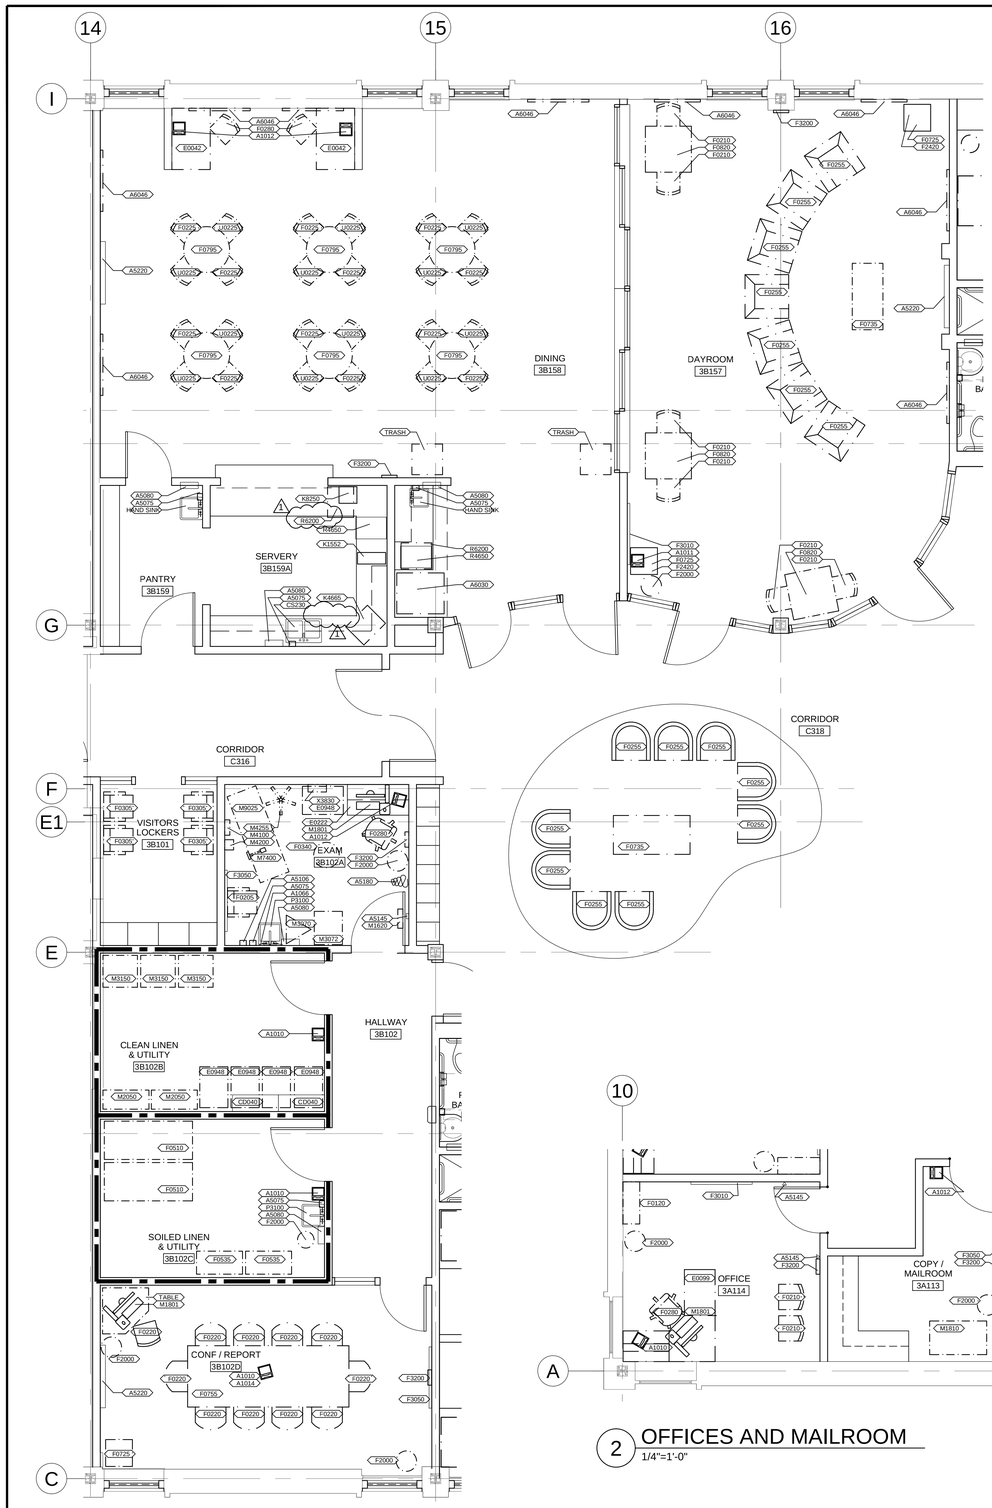

3 DINING, DAY, EXAM, CONFERENCE, UTILITY ROOMS
1/4"=1'-0"

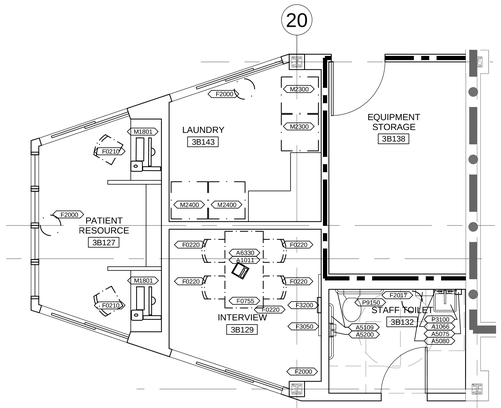

5 PATIENT RESOURCE, LAUNDRY AND INTERVIEW
1/4"=1'-0"

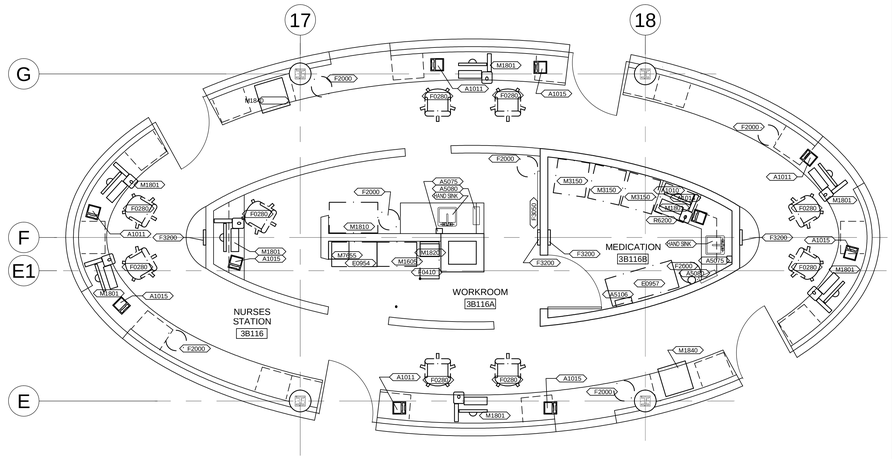

4 NURSES' STATION AND MED ROOM
1/4"=1'-0"

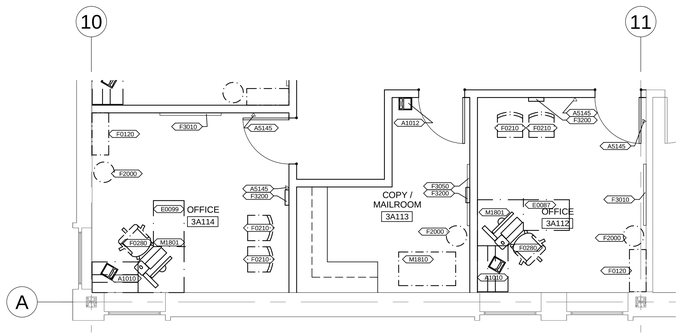

2 OFFICES AND MAILROOM
1/4"=1'-0"

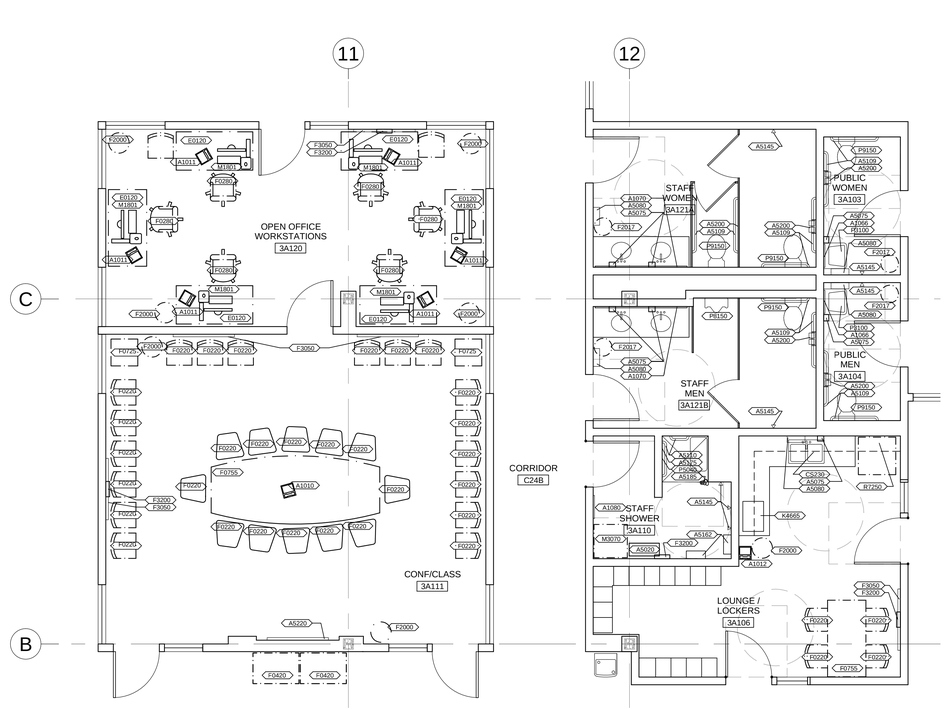

1 CONF. RM, OPEN OFFICE, TOILETS, LOCKERS AND LOUNGE
1/4"=1'-0"

PLAN NORTH

KEY PLAN

ONE QUARTER INCH = ONE FOOT

12" 0 4' 96"

NOTE: REFER TO EQUIPMENT SCHEDULE ON QH102

CONSTRUCTION DOCUMENT SUBMISSION
FULLY SPRINKLERED

ADDENDUM NO. 1	06-04-14
Revisions:	Date

CONSULTANTS:

ARCHITECT/ENGINEERS:

BES DESIGN/BUILD

BES DESIGN/BUILD, LLC
766 Middle St, Fairhope, AL 36532
Phone: 251.990.5778
Fax: 251.990.3716

Drawing Title: **ENLARGED EQUIPMENT PLANS**

Approved: Project Director

Project Title: **INPATIENT PSYCHIATRY AND SUBSTANCE ABUSE**

Location: **W.J. BRYAN DORN VAMC; COLUMBIA, SC**

Date: **05-15-2014** | Checked: **DCVT** | Drawn: **ROW**

Project Number: **544-13-101**

Building Number: **100**

Drawing Number: **QH103**

Dwg. 21 of 51

OFFICE OF CONSTRUCTION AND FACILITIES MANAGEMENT

Department of Veterans Affairs

VA FORM 08-6231