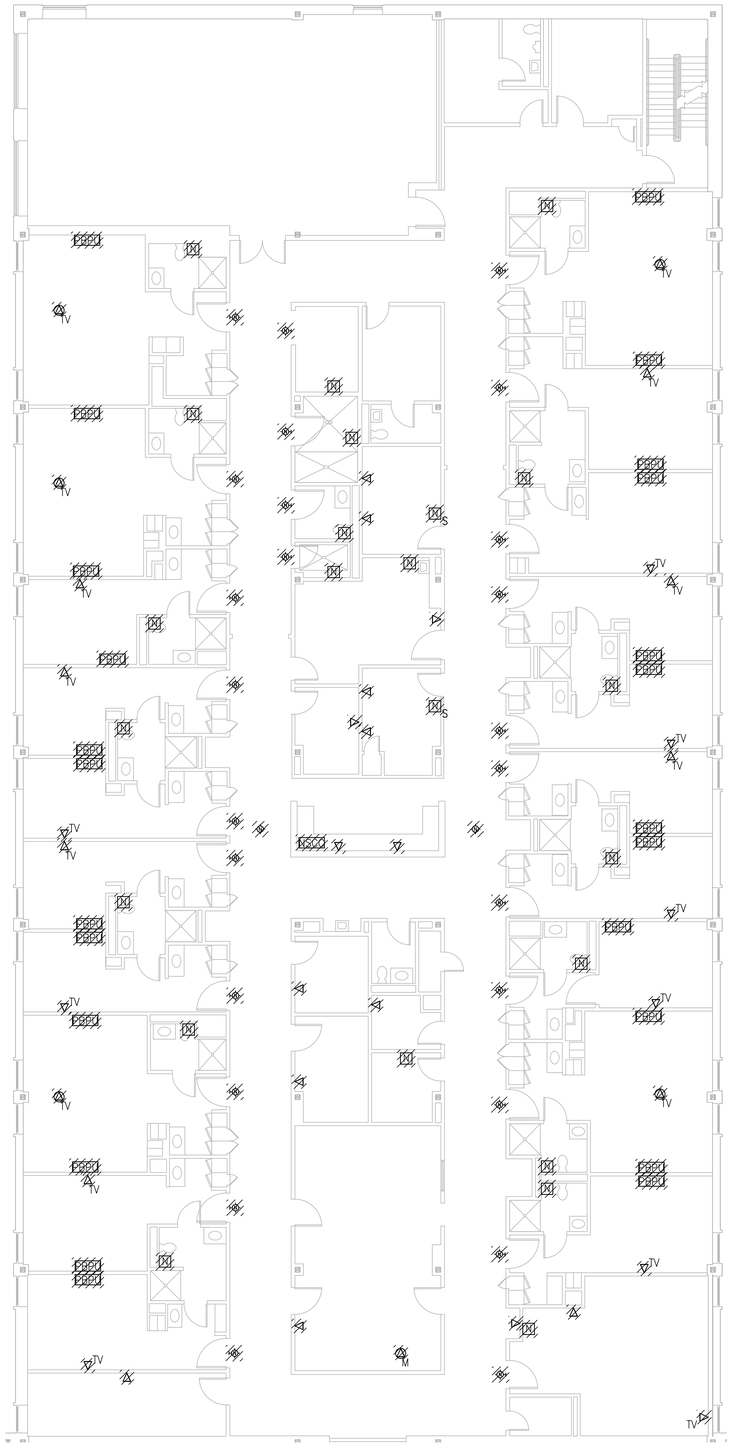

SECONDARY ELECTRICAL SYSTEMS - DEMOLITION

SCALE 1/8" = 1'-0"

GENERAL DEMOLITION NOTES

1. ALL ITEMS SHOWN WITH HATCHED LINES INDICATE ITEMS TO BE DEMOLISHED. SEE ARCHITECTURAL DRAWINGS AND CODED DEMOLITION NOTES FOR ADDITIONAL INFORMATION. COORDINATE DEMOLITION WITH ALL TRADES.
2. LOCATION OF EXISTING EQUIPMENT, CONDUITS, OUTLETS, DEVICES, CONTROLS AND ALL CONCEALED WORKS, ETC. ARE APPROXIMATE.
3. NOT ALL CIRCUITS AND DEVICES ARE INDICATED. FOR EACH DEVICE INDICATED FOR DEMOLITION THERE IS A CIRCUIT OR FEEDER BACK TO THE POINT OF ORIGIN. ALL CIRCUITS AND DEVICES SHALL BE DEMOLISHED UNLESS NOTED OTHERWISE.
4. EXISTING PIPING AND/OR CONDUIT RUN CONCEALED IN FLOOR SLAB OR UNDERGROUND AND NOT INDICATED OR SPECIFIED FOR REUSE IN NEW WORK SHALL BE ABANDONED UNLESS NOTED OTHERWISE. CUT PIPING AND/OR CONDUIT AT FLOOR. ALL REPAIRS SHALL BE BY TRADES SKILLED IN FINISH WORK. MODIFY EXISTING OPENINGS TO BE REUSED IN NEW WORK BY SAW CUTTING OR CORING.
5. FLUORESCENT LAMPS AND BALLASTS SHALL BE CONSIDERED HAZARDOUS WASTE.
6. ALL OPENINGS AND SURFACES MADE BARE BY DEMOLITION AND/OR REMOVAL OF OUTLETS, EQUIPMENT, CONTROLS, ETC. SHALL BE REPAIRED AND/OR PATCHED TO MATCH ADJACENT FINISH. PREPARE SURFACES TO RECEIVE NEW FINISH. SEE ARCHITECTURAL DRAWINGS FOR ADDITIONAL INFORMATION. ALL REPAIRS AND NEW FINISH SHALL BE BY TRADES SKILLED IN FINISH WORK.
7. DURING THE LIFE OF THE CONTRACT (CONSTRUCTION AND DEMOLITION TO POINT OF BENEFICIAL OCCUPANCY BY OWNER), THE CONTRACTOR SHALL PROTECT ALL SYSTEMS OR PORTIONS OF SYSTEMS TO REMAIN FOR REUSE FROM DAMAGE. ALL SYSTEMS SHALL BE TESTED IN SERVICE AFTER COMPLETION OF THE CONTRACT AND MADE COMPLETE AND OPERABLE AT NO ADDITIONAL COST TO THE GOVERNMENT.
8. SEE ARCHITECTURAL DRAWINGS AND SPECIFICATIONS FOR ADDITIONAL INFORMATION. COORDINATE ALL DEMOLITION WITH ALL TRADES INVOLVED.
9. ALL ELECTRICAL WORK SHALL BE IN ACCORDANCE WITH THE LATEST EDITIONS OF THE NATIONAL ELECTRIC SAFETY CODE (ANSI/IEEE C-2) AND THE NATIONAL ELECTRIC CODE (NFPA 70).
10. EXISTING NURSE CALL SYSTEM MUST BE DEMOLISHED BY RAULAND BORG/RONCO REPRESENTATIVE.

1

KEY PLAN

PLAN NORTH

CONSTRUCTION DOCUMENTS SUBMISSION
FULLY SPRINKLERED

1. ADD NOTE #10	05/30/14
Revisions:	Date

CONSULTANTS:

SOUTH CAROLINA PROFESSIONAL ENGINEER 30466 2014.06.16 BARRY L. VERNEY, SR.

ARCHITECT/ENGINEERS:

BES DESIGN/BUILD

BES DESIGN/BUILD, LLC
766 Middle St, Fairhope, AL 36532
Phone: 251.990.5778
Fax: 251.990.3716

Drawing Title: SECONDARY ELECTRICAL SYSTEMS DEMOLITION

Approved: Project Director

Project Title: **RENOVATE MEDICAL SURGICAL UNIT**

Location: **W.J. BRYAN DORN VAMC; COLUMBIA, SC**

Date: **05/16/2014** | Checked: **RLB** | Drawn: **DLA**

Project Number: **544-13-102**

Building Number: **100**

Drawing Number: **ED105**

Dwg. 63 of 78

OFFICE OF CONSTRUCTION AND FACILITIES MANAGEMENT

Department of Veterans Affairs

VA FORM 08-6231