



- SHEET KEYNOTES**
1. INSTALL NEW WALL-HUNG TOILET ON FLOOR MOUNTED CARRIER. ROUTE NEW PLUMBING AND TIE-IN TO EXISTING SAN & V LINES.
 2. INSTALL NEW WALL-HUNG LAVATORY ON FLOOR MOUNTED CARRIER. ROUTE NEW PLUMBING AND TIE-IN TO EXISTING SAN & V LINES.
 3. INSTALL NEW SHOWER FLOOR DRAIN. ROUTE NEW PLUMBING AND TIE-IN TO EXISTING SAN & V LINES.
 4. INSTALL NEW SINGLE COMPARTMENT COUNTERTOP SINK. ROUTE NEW PLUMBING AND TIE-IN TO EXISTING SAN & V LINES.
 5. INSTALL NEW DOUBLE COMPARTMENT COUNTERTOP SINK. ROUTE NEW PLUMBING AND TIE-IN TO EXISTING SAN & V LINES.
 6. INSTALL CLINIC SERVICE SINK WITH BED PAN WASHER. ROUTE NEW PLUMBING AND TIE-IN TO EXISTING SAN & V LINES.
 7. INSTALL NEW DRINKING FOUNTAIN. ROUTE NEW PLUMBING AND TIE-IN TO EXISTING CW, SAN & V LINES.
 8. INSTALL NEW SERVICE SINK. ROUTE NEW PLUMBING AND TIE-IN TO EXISTING CW, HW, SAN & V LINES.
 9. OFFSET EXISTING SAN, WASTE AND VENT LINES APPROXIMATELY AS SHOWN TO CORRECTLY ALIGN EXISTING VERTICAL DROPS WITH NEW WALLS ON 3RD FLOOR.
 10. 4" SAN UP AND DN IN WALL.
 11. 4" V UP AND DN IN WALL.
 12. (E)4" SAN UP AND DN IN WALL.
 13. (E)4" V UP AND DN IN WALL.
 14. (E)4" SAN UP.
 15. (E)4" V UP.
 16. (E)4" SAN DN.
 17. (E)4" V DN.
 18. (E)2" AV DN.
 19. (E)2" AV UP.

GENERAL NOTES


SEE SHEET PL001 FOR GENERAL NOTES.

PLUMBING SYMBOLS


SEE SHEET PL001 FOR PLUMBING SYMBOLS.

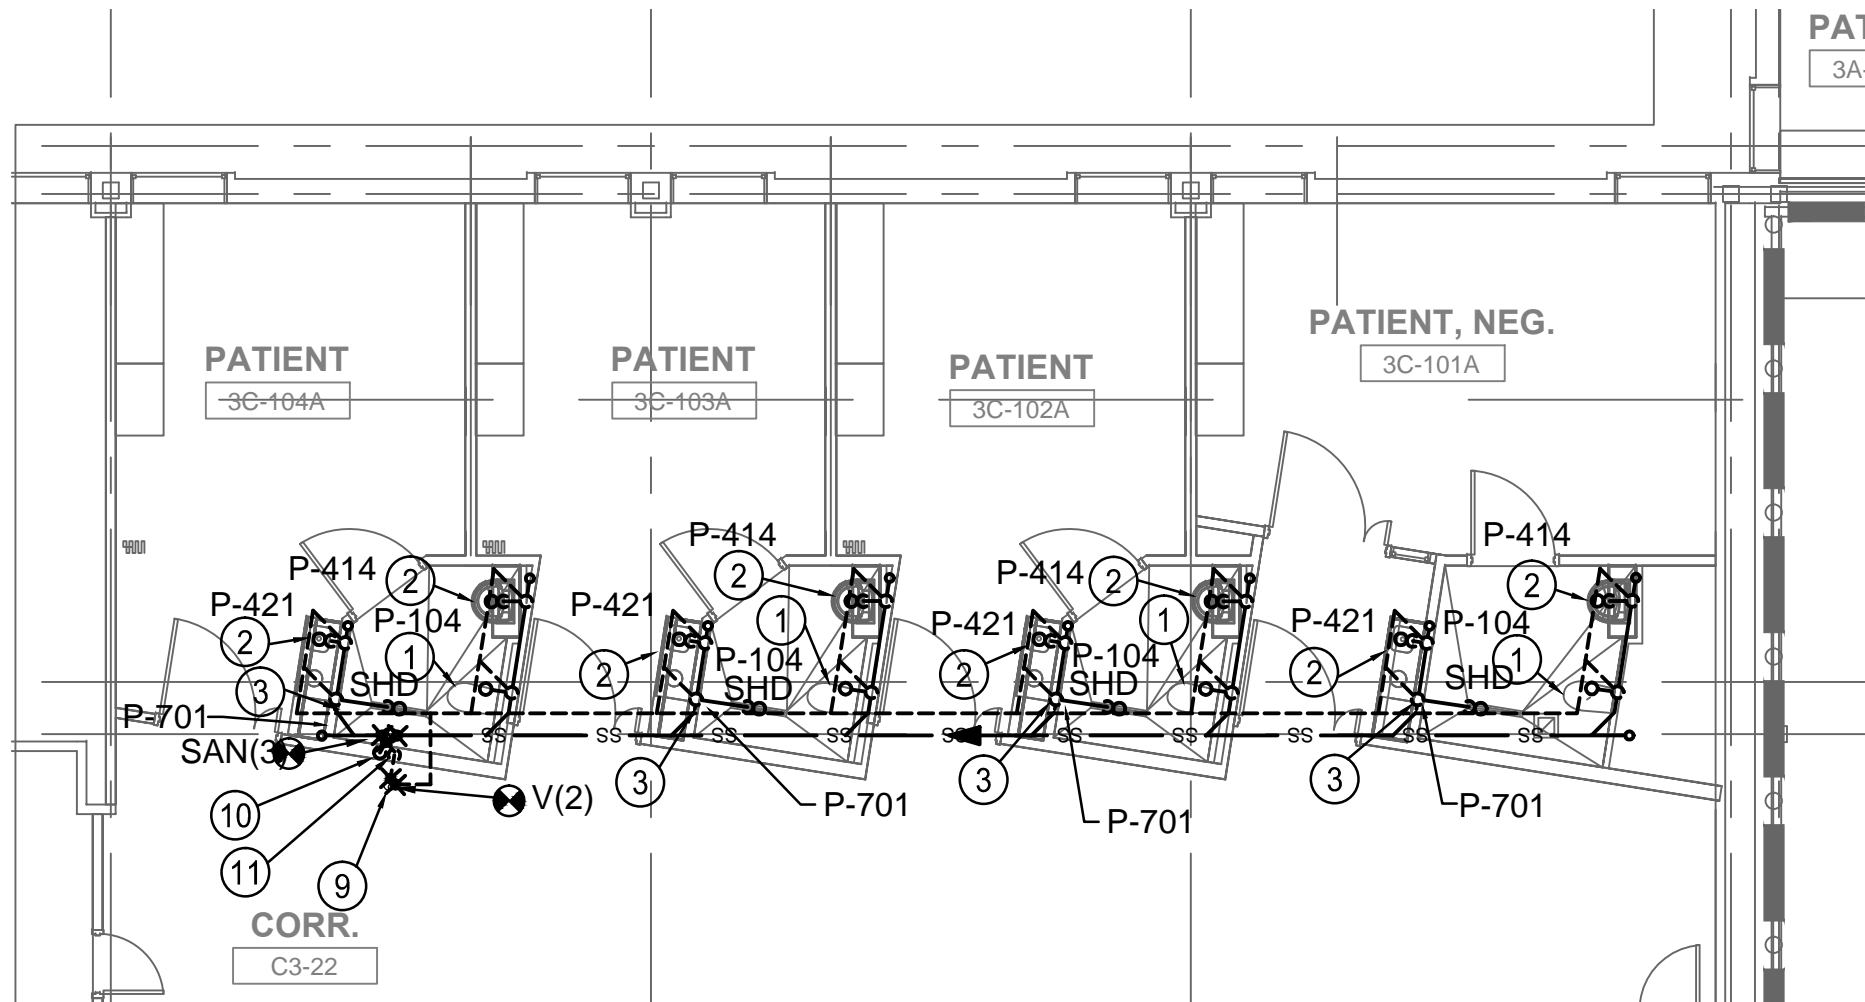


2 PLUMBING FLOOR PLAN - SAN, W&V - EAST WING
1/8" = 1'-0"

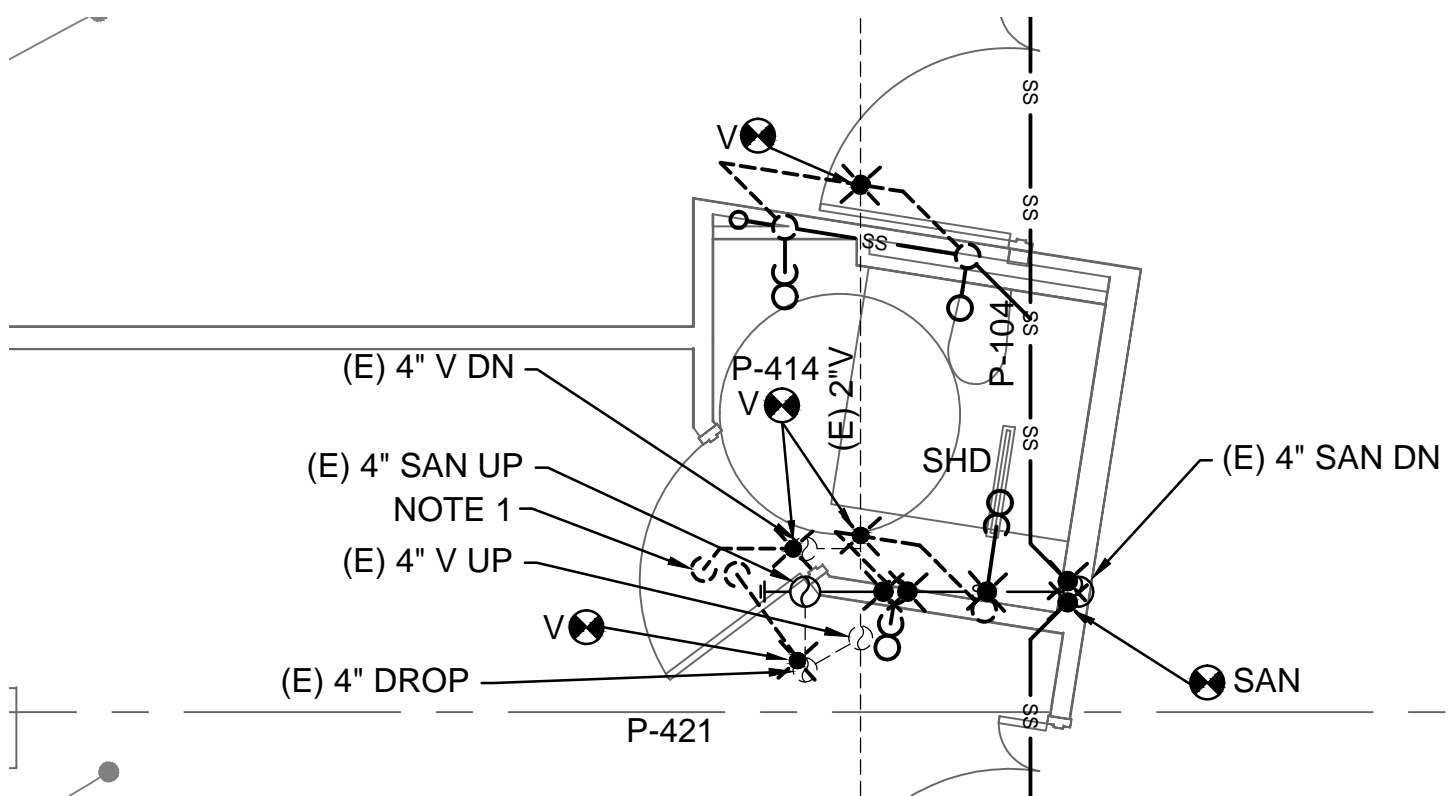

3 ENLARGED VIEW - TOILET 3A-172A
1/4" = 1'-0"

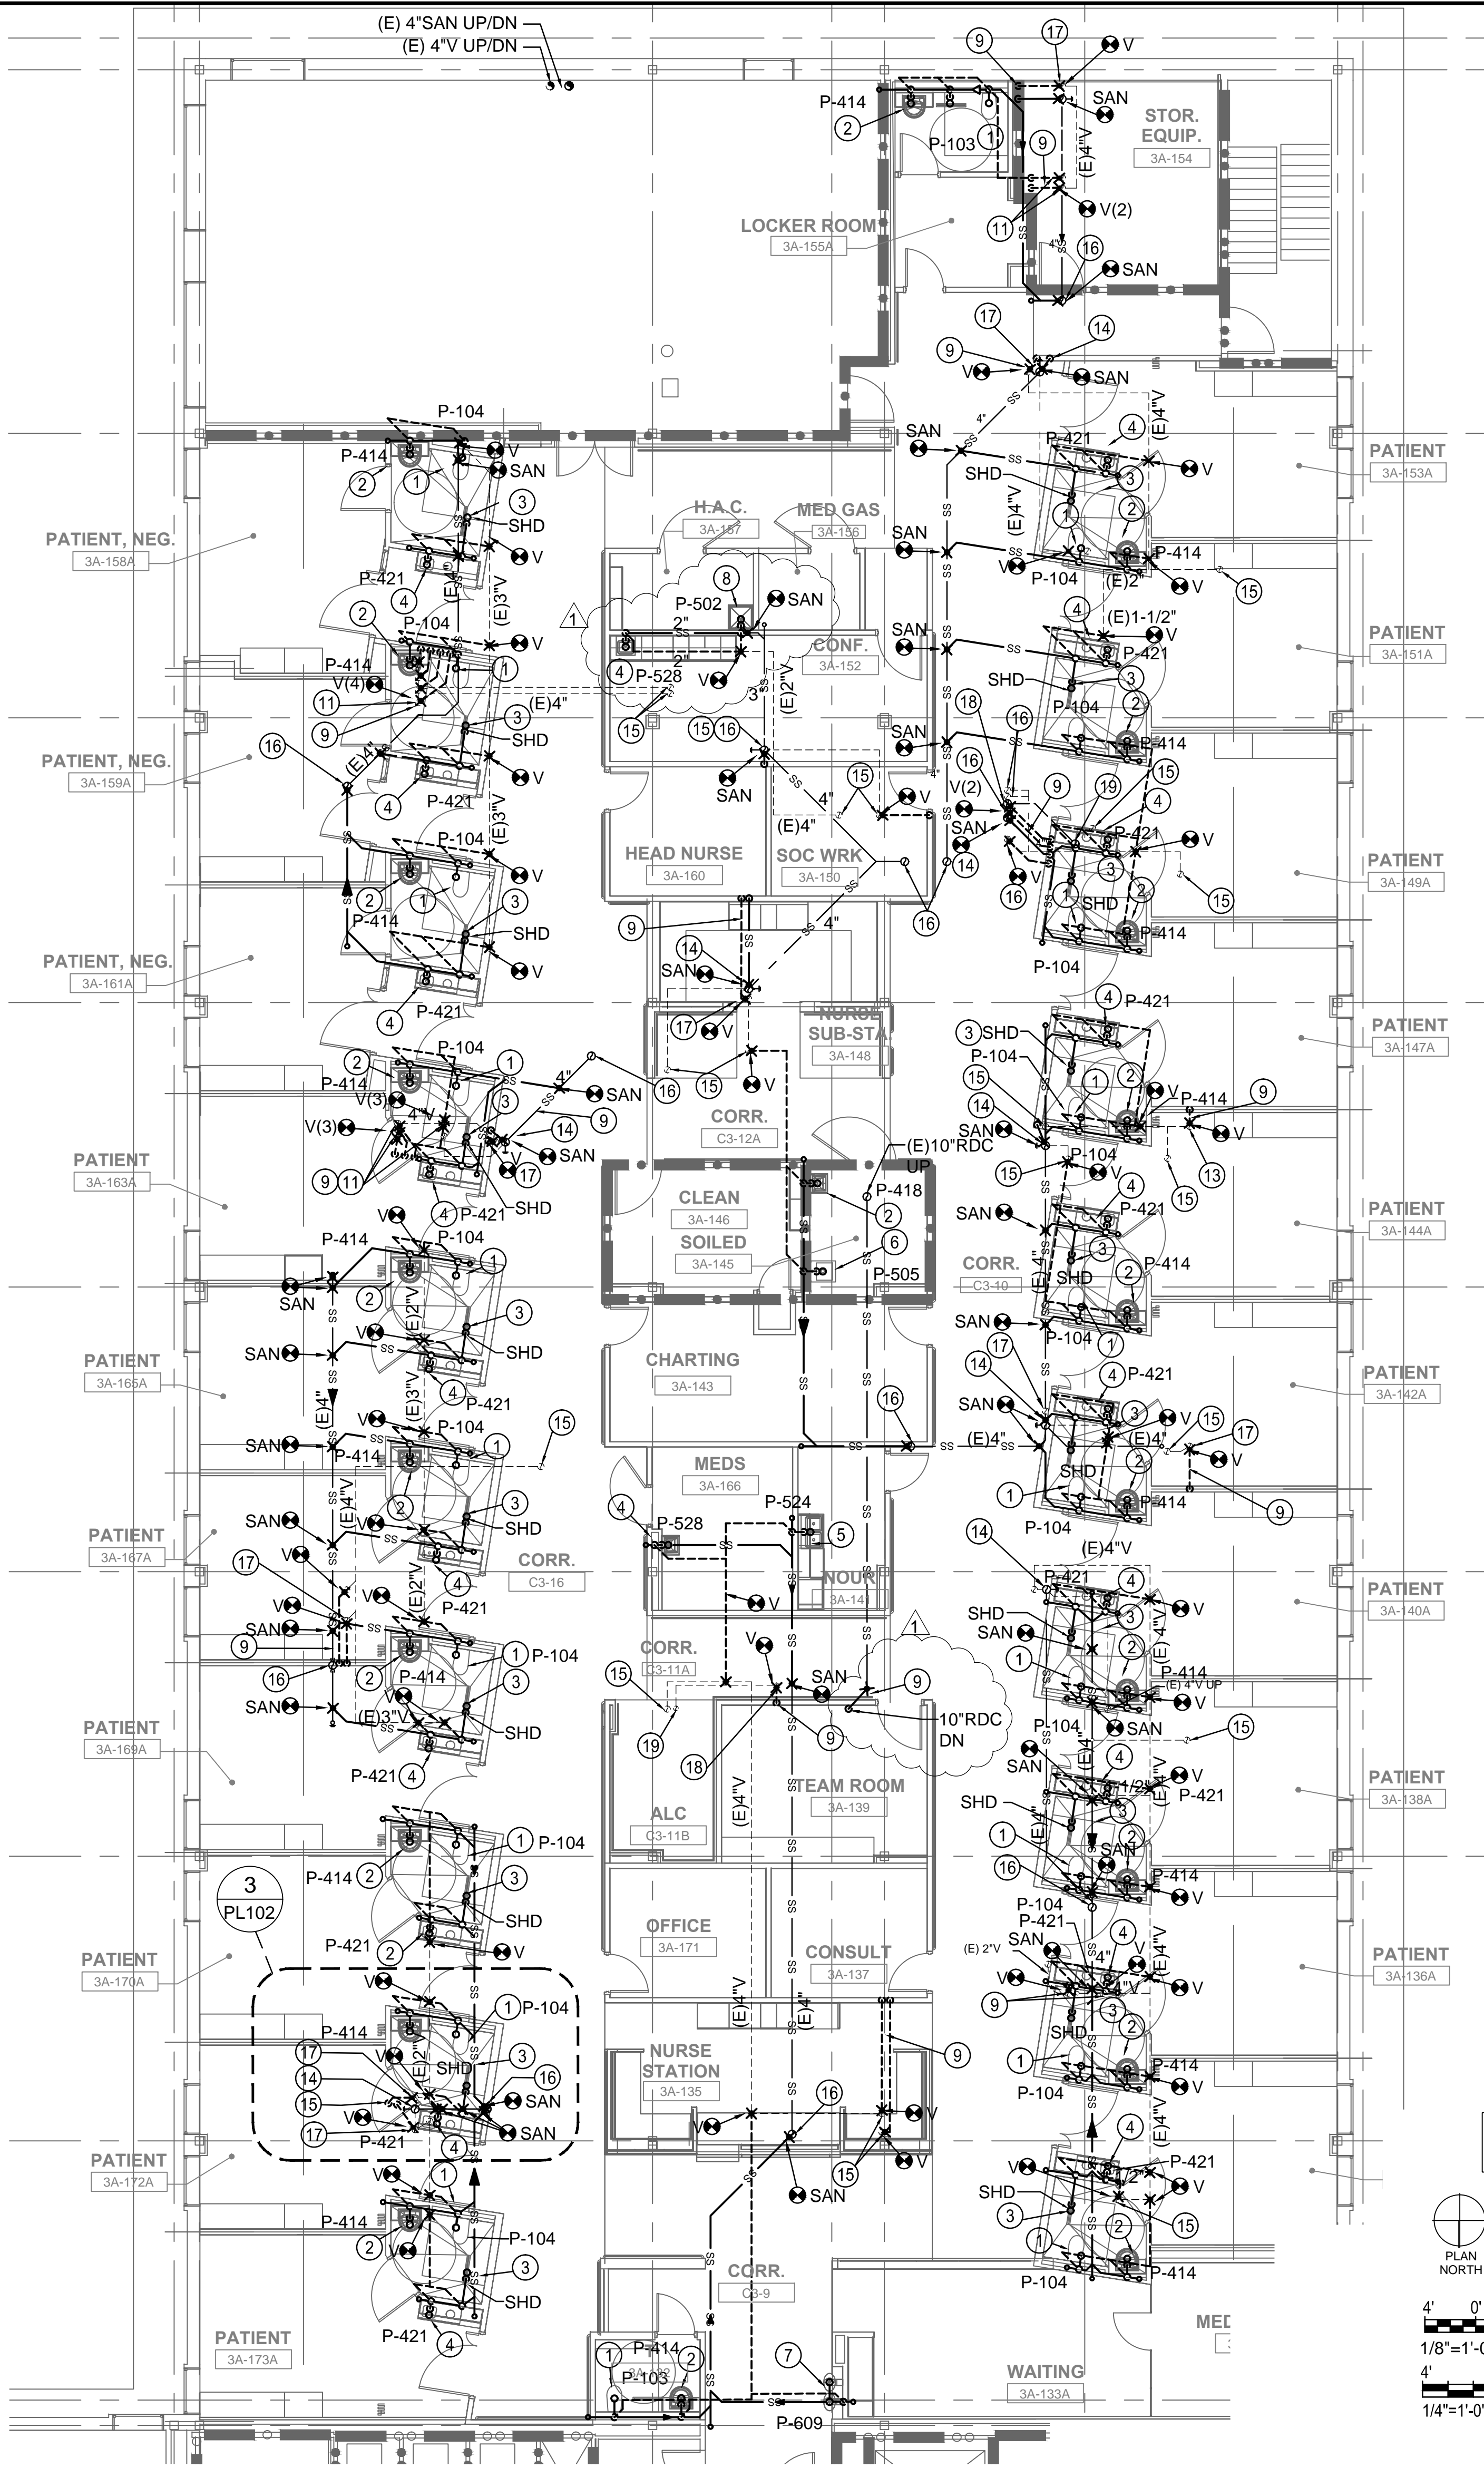


1 PLUMBING FLOOR PLAN - SAN, W&V - SOUTH WING
1/8" = 1'-0"

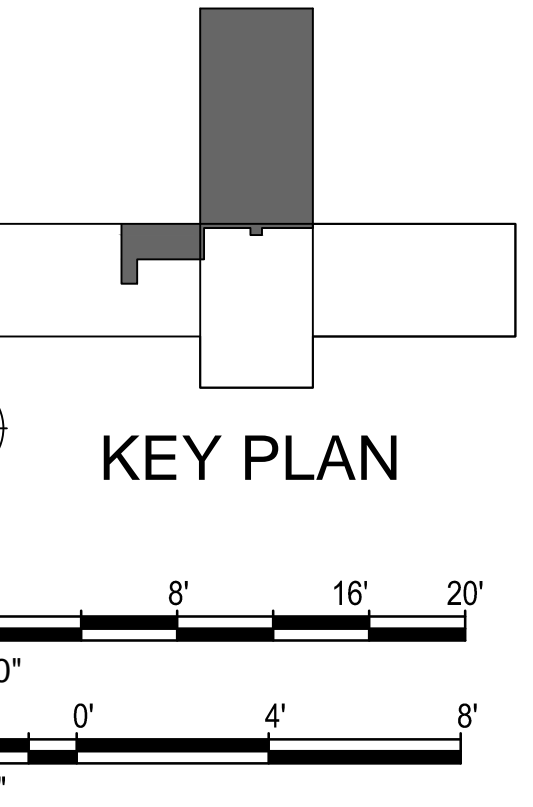

KEY PLAN

1	ADDENDUM #1	6/4/2014
Revisions:		Date

CONSULTANTS:

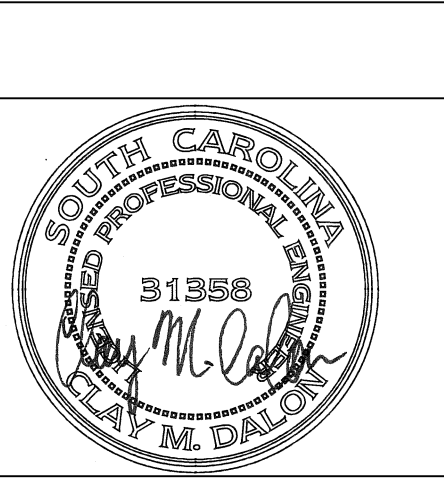

ARCHITECT/ENGINEERS:

BES
DESIGN/BUILD

BES DESIGN/BUILD, LLC
766 Middle St, Fairhope, AL 36532
Phone: 251.990.5778 Fax: 251.990.3716

Drawing Title
**PLUMBING FLOOR PLAN - SANITARY,
WASTE AND VENT - EAST AND SOUTH WING**

Approved: Project Director

Project Title
**RENOVATE MEDICAL SURGICAL
UNIT**

Location
W.J. BRYAN DORN VAMC; COLUMBIA, SC

Date
05-16-2014

Checked
CD

Drawn
JL

Project Number
544-13-102

Building Number
100

Drawing Number
PL102

Dwg. 39 of 78

**OFFICE OF
CONSTRUCTION
AND
FACILITIES
MANAGEMENT**

Department of
Veterans Affairs