


3/12/2013 11:03:33 AM


one eighth inch = one foot
one quarter inch = one foot
three eighths inch = one foot
one half inch = one foot
three quarters inch = one foot
one inch = one foot
one and one half inches = one foot
two inches = one foot
three inches = one foot
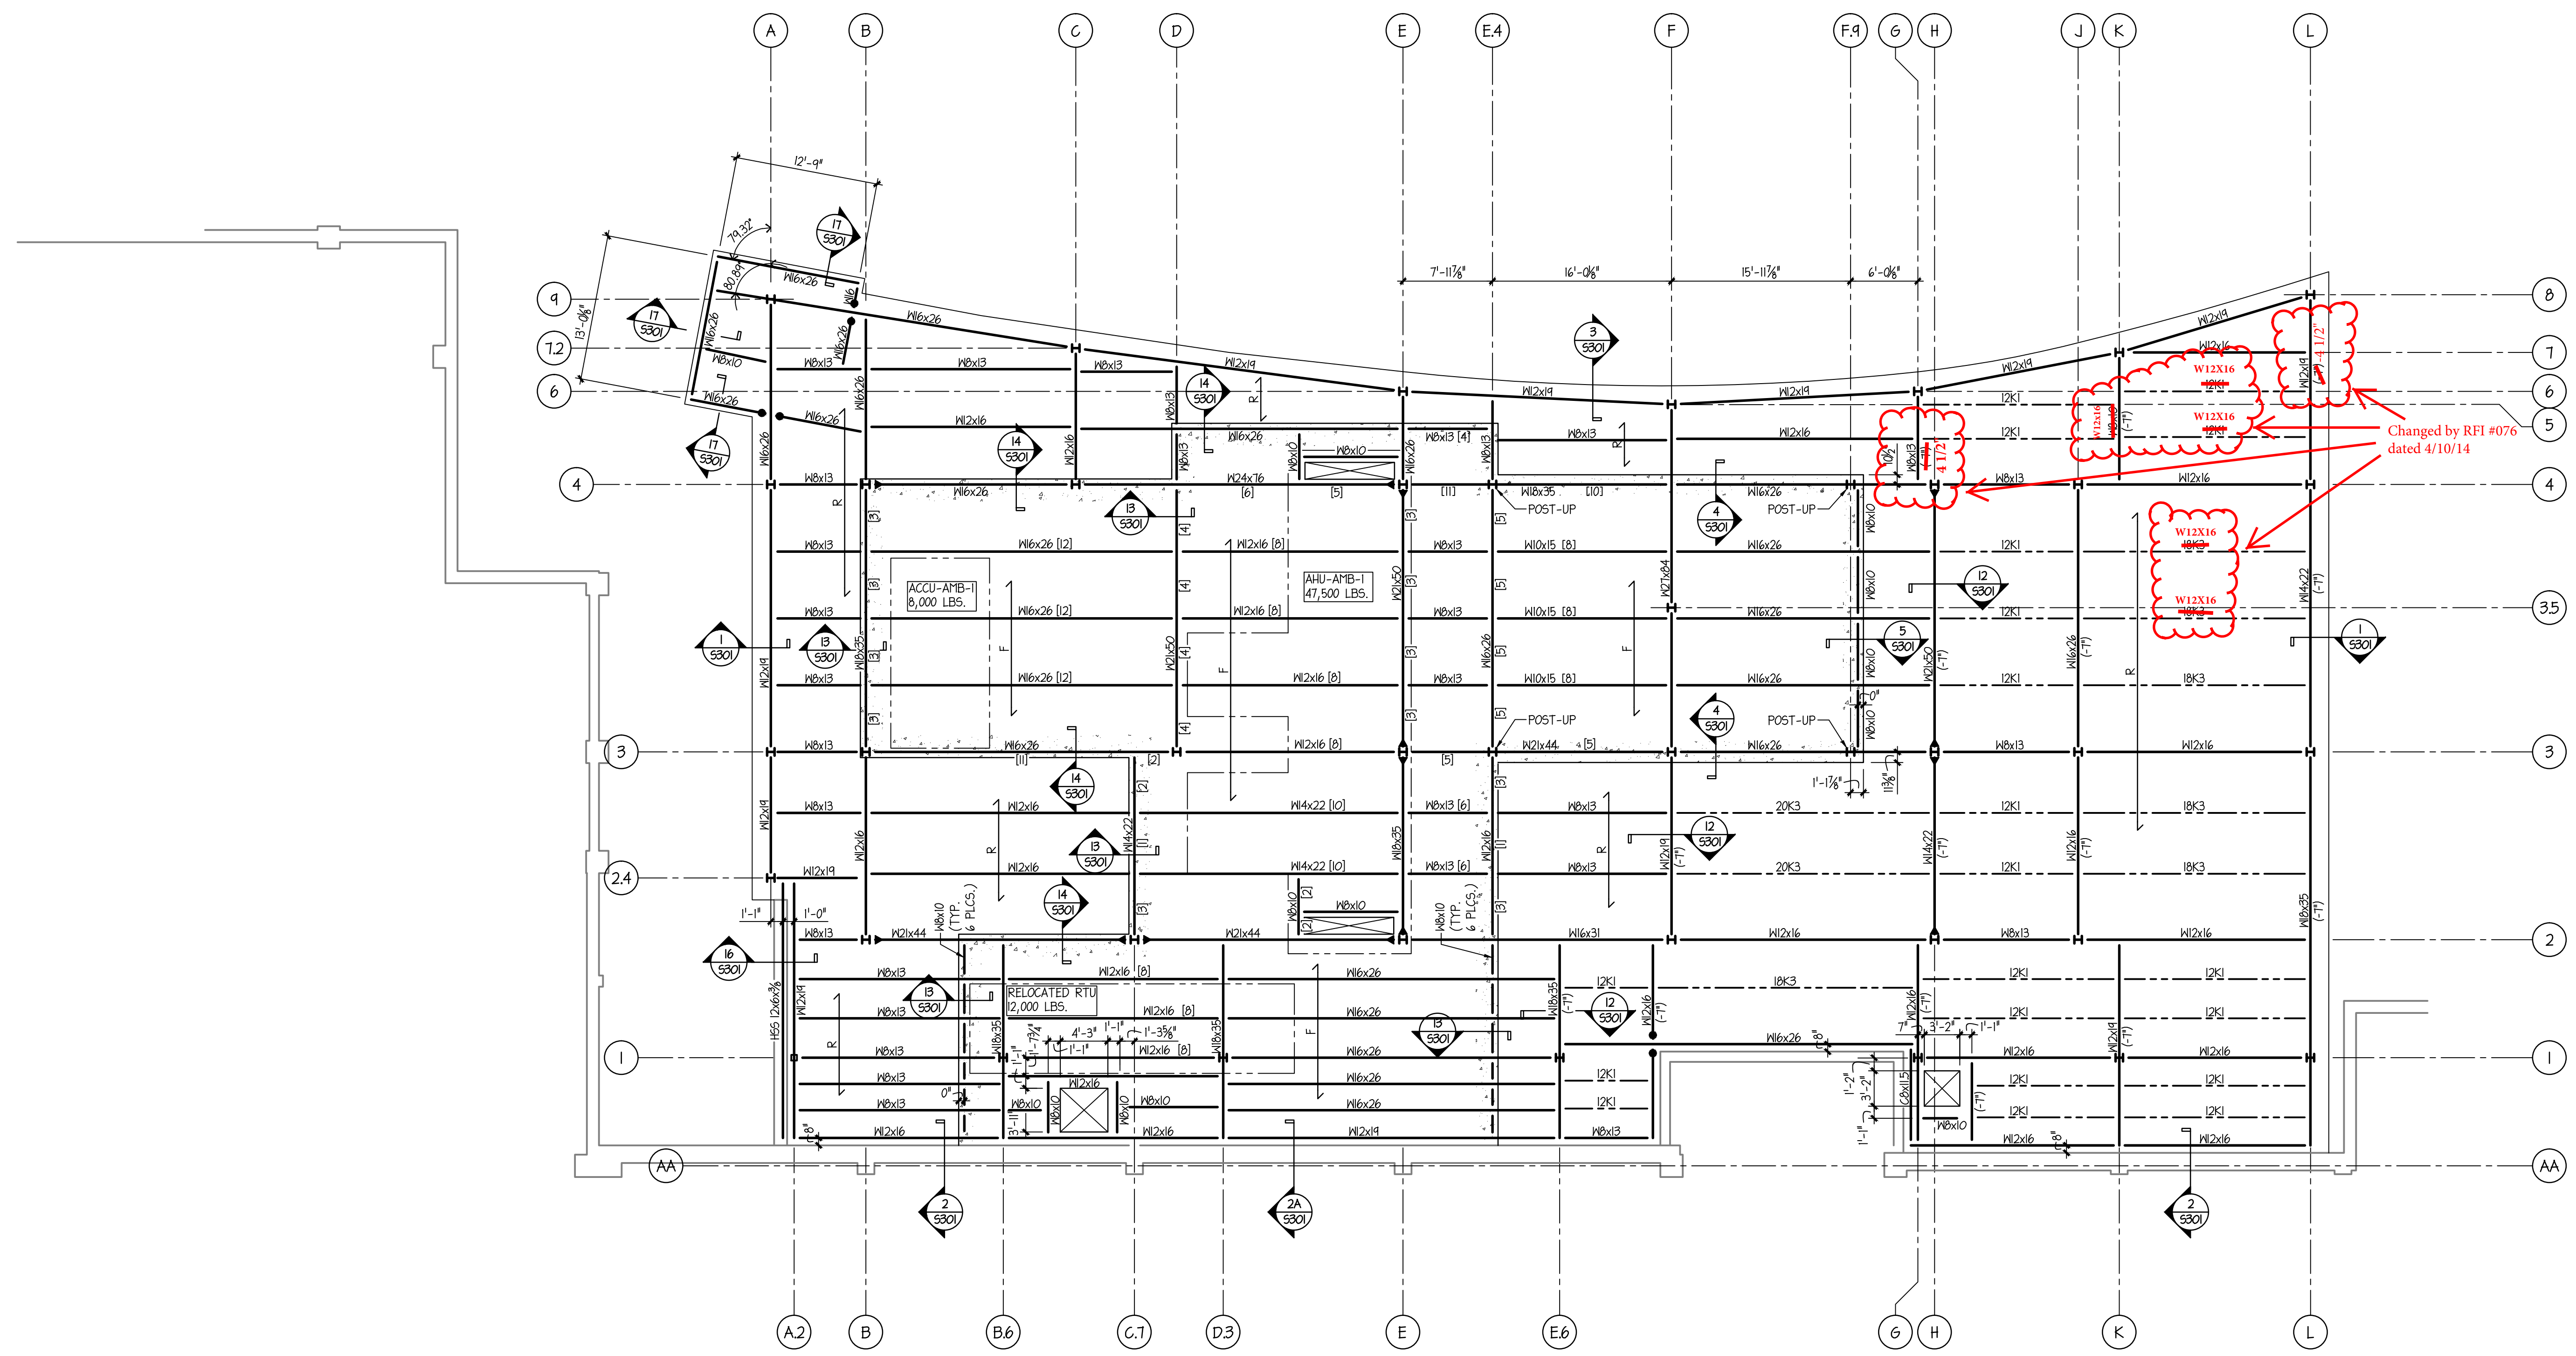

ROOF FRAMING PLAN
SCALE 1/8" = 1'-0"

NOTES:


1. TOP OF LEVEL 3 CONCRETE SLAB ELEVATION = (811'-1 3/8"). ELEVATIONS THIS PLAN NOTED (I OR J) ARE REFERENCED FROM THIS ELEVATION.
2. TOP OF STEEL BEAM ELEVATION = (4'-0") UNLESS NOTED (I OR J) FROM THE TOP OF SLAB ELEVATION.
3. "R" DESIGNATES SPAN DIRECTION OF 1/2" - 20 GA. GALVANIZED WIDE-RIB (TYPE B) METAL DECK.
4. "F" DESIGNATES SPAN OF 2" - 20 GA. GALVANIZED COMPOSITE METAL DECK + 3/8" L.W.G. (1 HR.) (LIGHT WEIGHT CONCRETE) SLAB REINFORCED BY 6# W4X14 M.F. (4 1/2" TOTAL THICKNESS).
5. COORDINATE ROOF PENETRATIONS NOT SHOWN WITH THE MEP DRAWINGS, RESPECTIVE CONTRACTORS AND TYPICAL FRAMING DETAIL.
6. PROVIDE ANGLE FRAMING AT ROOF PENETRATIONS AND UNDER MECHANICAL UNITS. SEE ARCHITECTURAL AND MECHANICAL DRAWINGS FOR LOCATIONS. COORDINATE EXACT LOCATIONS AND DIMENSIONS WITH THE MECHANICAL CONTRACTOR.
7. SEE MISCELLANEOUS LOOSE UNITS SCHEDULE FOR UNITS NOT SHOWN.
8. SEE ARCHITECTURAL DRAWINGS FOR LOCATIONS OF HUNG EQUIPMENT IN OPERATING ROOMS. SEE DETAILS A-E/5301 FOR SUPPORT FRAMING.

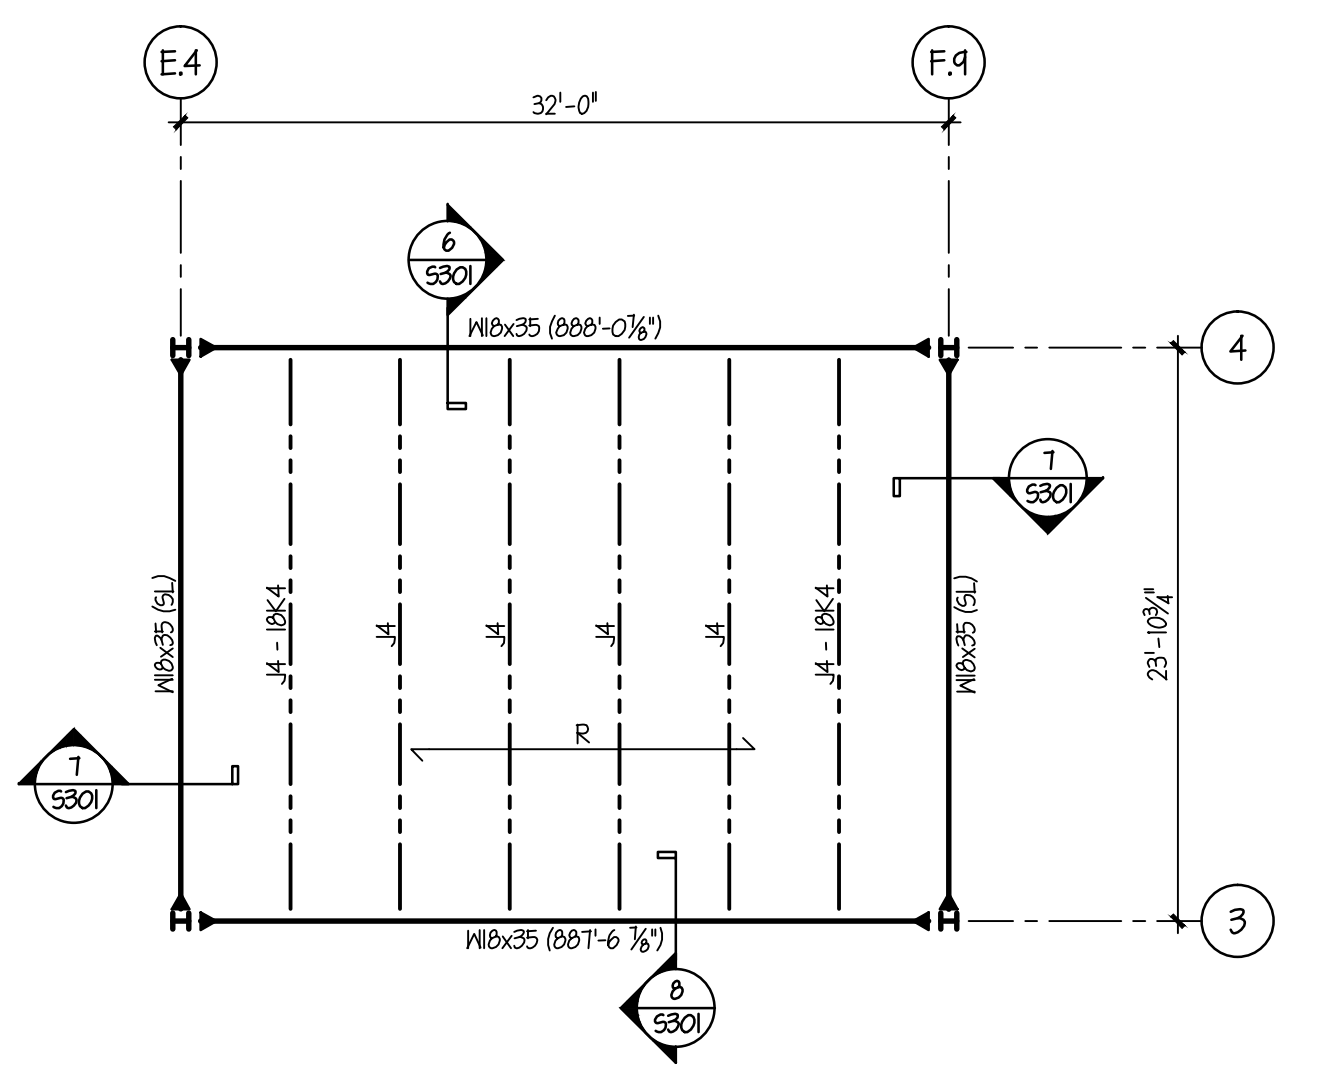

MECHANICAL ROOM ROOF FRAMING PLAN
SCALE 1/8" = 1'-0"

NOTES:

1. TOP OF STEEL BEAM JOIST BEARING ELEVATION ARE AS NOTED. ELEVATIONS THIS PLAN NOTED (I OR J) ARE REFERENCED FROM THIS ELEVATION.
2. BEAMS PARALLEL TO JOIST SHALL HAVE THE TOP ELEVATION TO MATCH THE TOP OF THE ADJACENT STEEL JOIST LEVEL OR SLOPED UNO.
3. "R" DESIGNATES SPAN DIRECTION OF 1/2" - 20 GA. GALVANIZED WIDE-RIB (TYPE B) METAL DECK.
4. COORDINATE ROOF PENETRATIONS NOT SHOWN WITH THE MEP DRAWINGS, RESPECTIVE CONTRACTORS AND TYPICAL FRAMING DETAIL.
5. PROVIDE ANGLE FRAMING AT ROOF PENETRATIONS AND UNDER MECHANICAL UNITS. SEE ARCHITECTURAL AND MECHANICAL DRAWINGS FOR LOCATIONS. COORDINATE EXACT LOCATIONS AND DIMENSIONS WITH THE MECHANICAL CONTRACTOR.

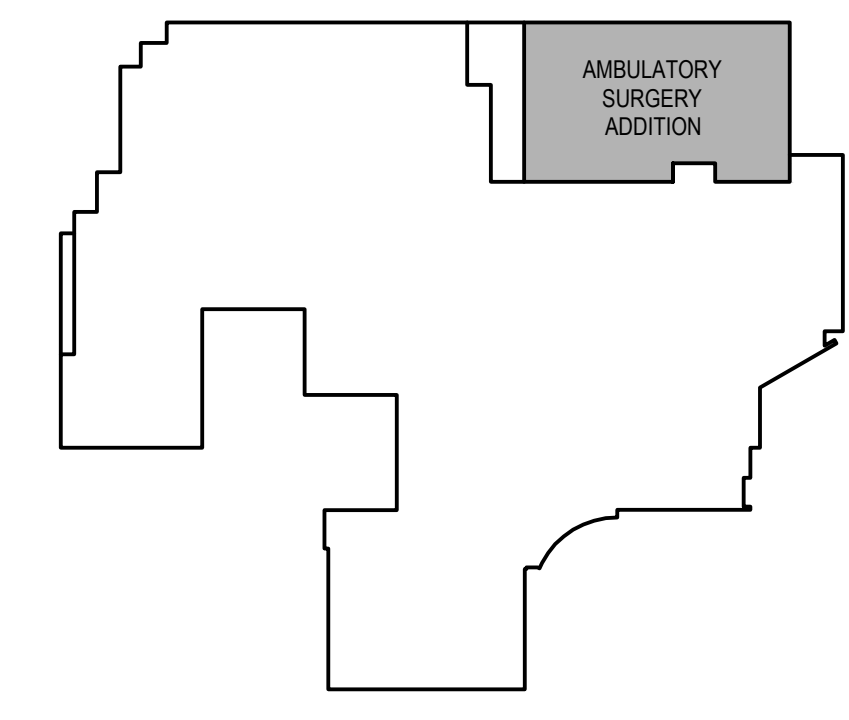

Key Plan
TRUE NORTH
BUILDING NORTH

--	--	

1st WORKING DRAWING SUBMISSION (90%)
RESUBMISSION - FULLY SPRINKLERED