




5 SECTION AT NEW BRACING
1/2" = 1'-0"

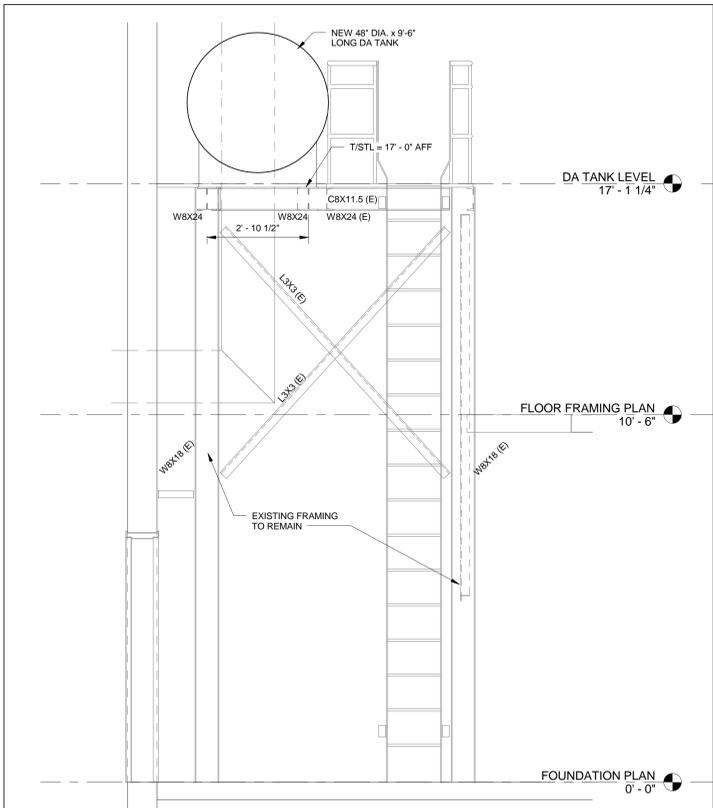


4 SIDE SECTION
1/2" = 1'-0"

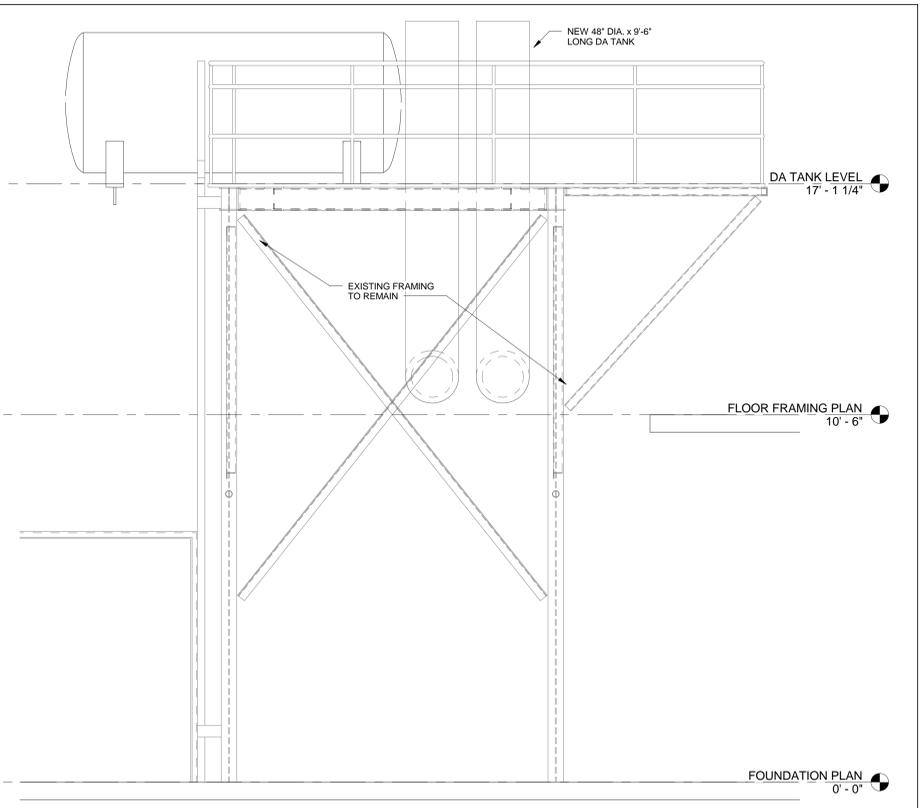

3 EXISTING FRAMING ELEVATION/DETAIL
1/2" = 1'-0"


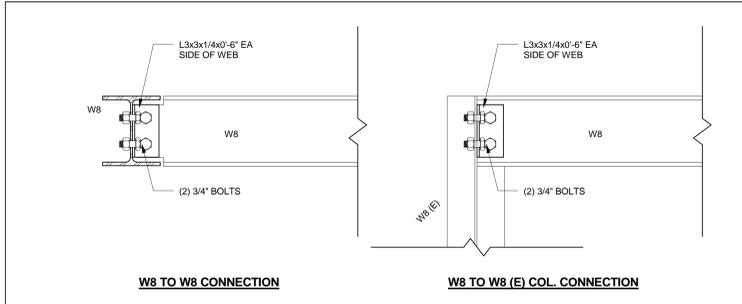


2 W8 CONNECTION DETAILS
1 1/2" = 1'-0"

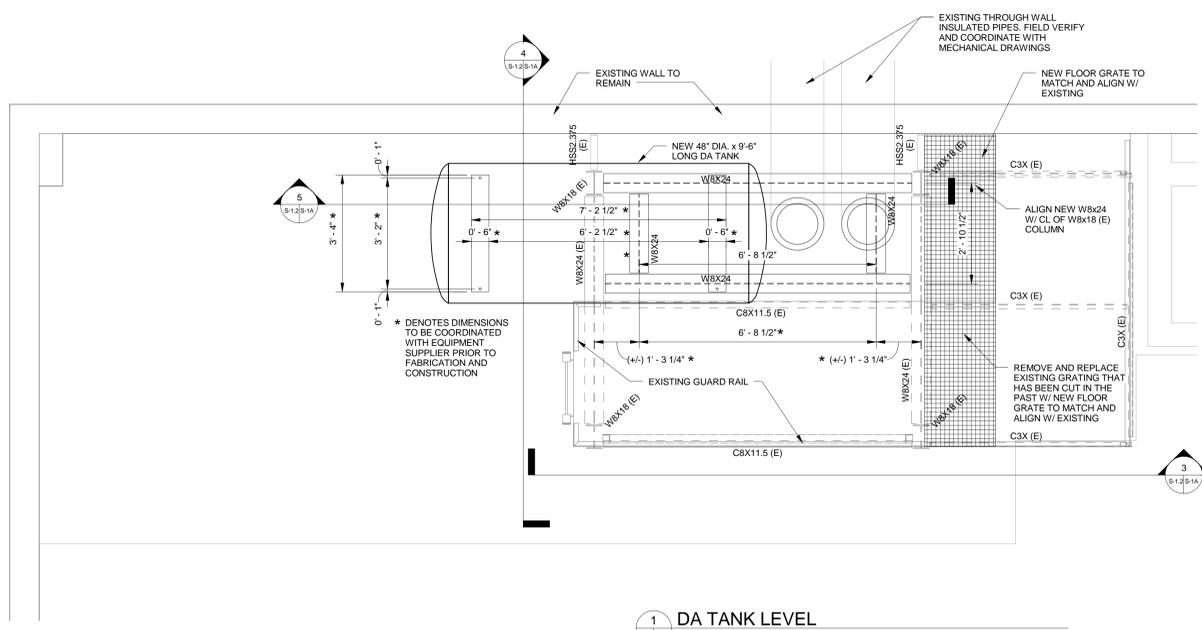


1 DA TANK LEVEL
1/2" = 1'-0"

Modify and complete existing design for structural drawing S-1A to allow for relocation of Deaerator Tank by approximately 4'-6" from original position as shown on drawing. Field verify chill water piping to confirm exact dimension tank needs to move. Also modify and complete S-1A to accommodate 14" chill water supply and return piping that will pass through the structural steel platform as shown, including grating and any support steel for tank and grating. Provide S.C. PE stamped drawing for approval. Once approved, proceed with work on S-1A

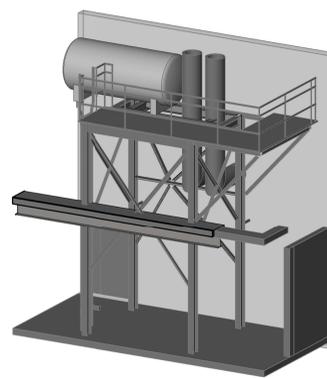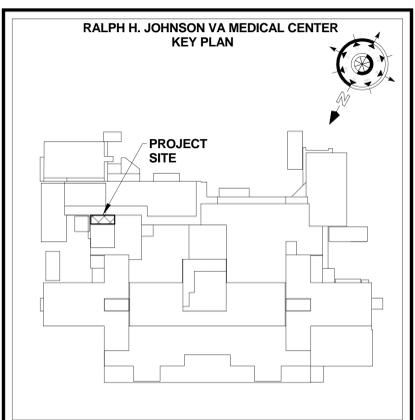

6 ISOMETRIC - A

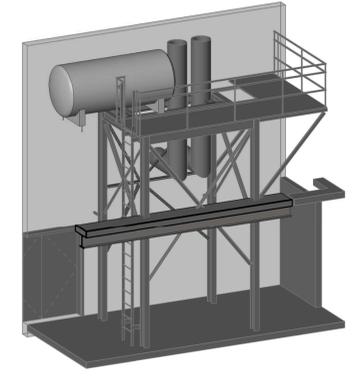

7 ISOMETRIC - B

Revisions	Date	Project Team: William C. Neel, P.E. Principal CAN Engineering Eugene M. Ogozalek, AIA, NCARB Architect Willow Design Architecture Richard Kapp, P.E. (2014-042) Structural Engineer Professional Engineering Associates	Consultants:	Architect/Engineer Seal pe PROFESSIONAL ENGINEERING ASSOCIATES 170 BOKER DRIVE GREENVILLE SOUTH CAROLINA 29615	Architect/Engineer Seal 6/16/2014 SOUTH CAROLINA PROFESSIONAL ENGINEERING ASSOCIATES No. 278 Richard Kapp	Architect/Engineer Seal SOUTH CAROLINA PROFESSIONAL ENGINEERING ASSOCIATES No. 000103 Professional Engineering Associates Certificate of Authority	Architect/Engineer Address CAN Engineering, Inc. 4109 East North Street, Suite 200 Greenville, South Carolina 29615 Ph: (864) 271-9215 Fax: (864) 268-7510 Email: CANENGINE@aol.com CAN Project 100417A	willow design ARCHITECTURE 409 LACKAWANNA AVE., SUITE 7C SCRANTON, PA 18503 v: (570) 330-9032 f: (570) 330-9017 www.willowdesign.biz SERVICE DISABLED VETERAN (ARMED SMALL BUSINESS)	Drawing Title DA TANK SUPPORT	Project Title INSTALL DEAERATOR TANK	Date APRIL 2014	Project No. 534-14-929	DRAWING NO. S-1A Uwg. 7 of 8	Department of Veterans Affairs
Approved: Division Chief		Building Number		Checked RHK		Drawn MBJ		Approved: Service Director		Location CHARLESTON, SC				

FULLY SPRINKLERED