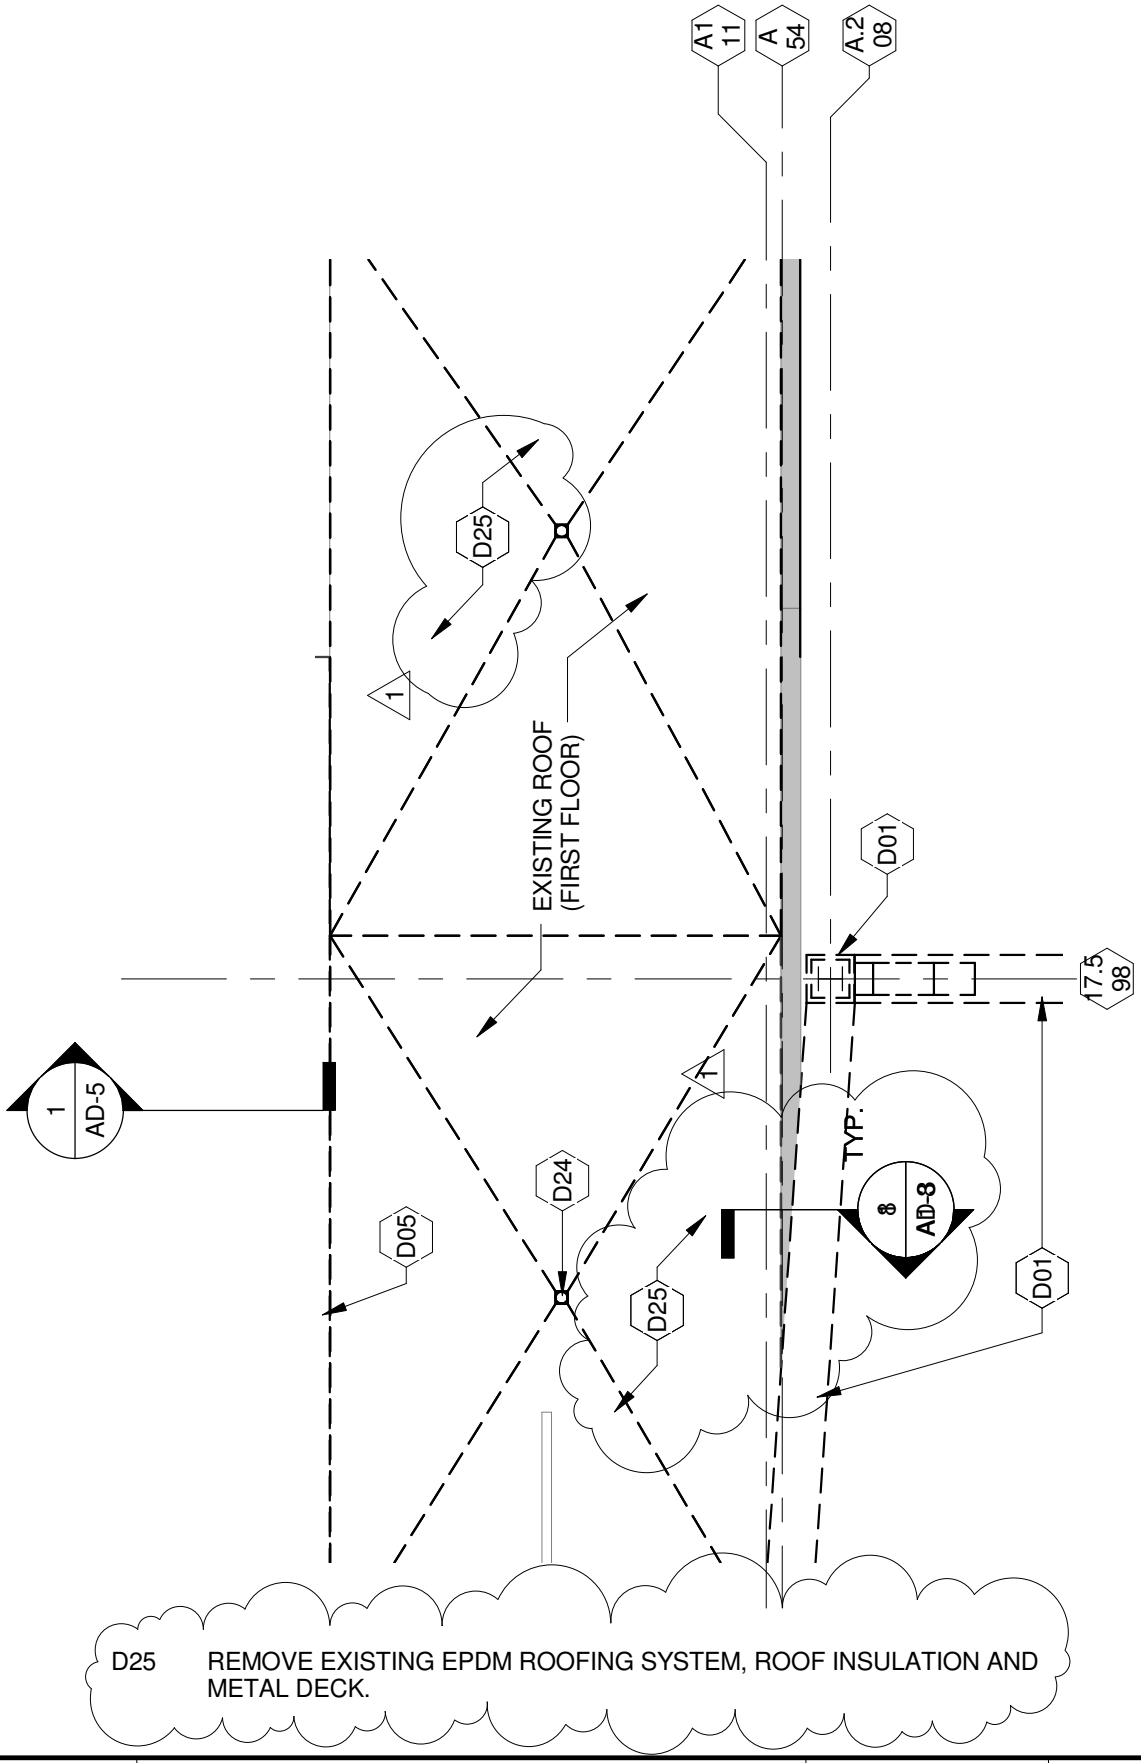

D25 REMOVE EXISTING EPDM ROOFING SYSTEM, ROOF INSULATION AND METAL DECK.

CBLH DESIGN	PROJECT: **VA Pittsburgh Healthcare System** UD, EXPAND MEDICAL AND SURGICAL CLINICS	PROJECT NO.: 18500	ISSUED FOR: **ADDENDUM NO. 1**
		SCALE: 1/8"=1'-0"	ITEM NO.: 4
	DRAWING TITLE: PARTIAL SECOND FLOOR DEMOLITION PLAN - PHASE 1A	DATE: 06/26/14	DRAWING NO.: AD-2
		REF. DWG.: A1-2	

7850 FREEWAY CIRCLE CLEVELAND, OHIO 44130-6317 FAX: 440-243-3305 PHONE: 440-243-2000