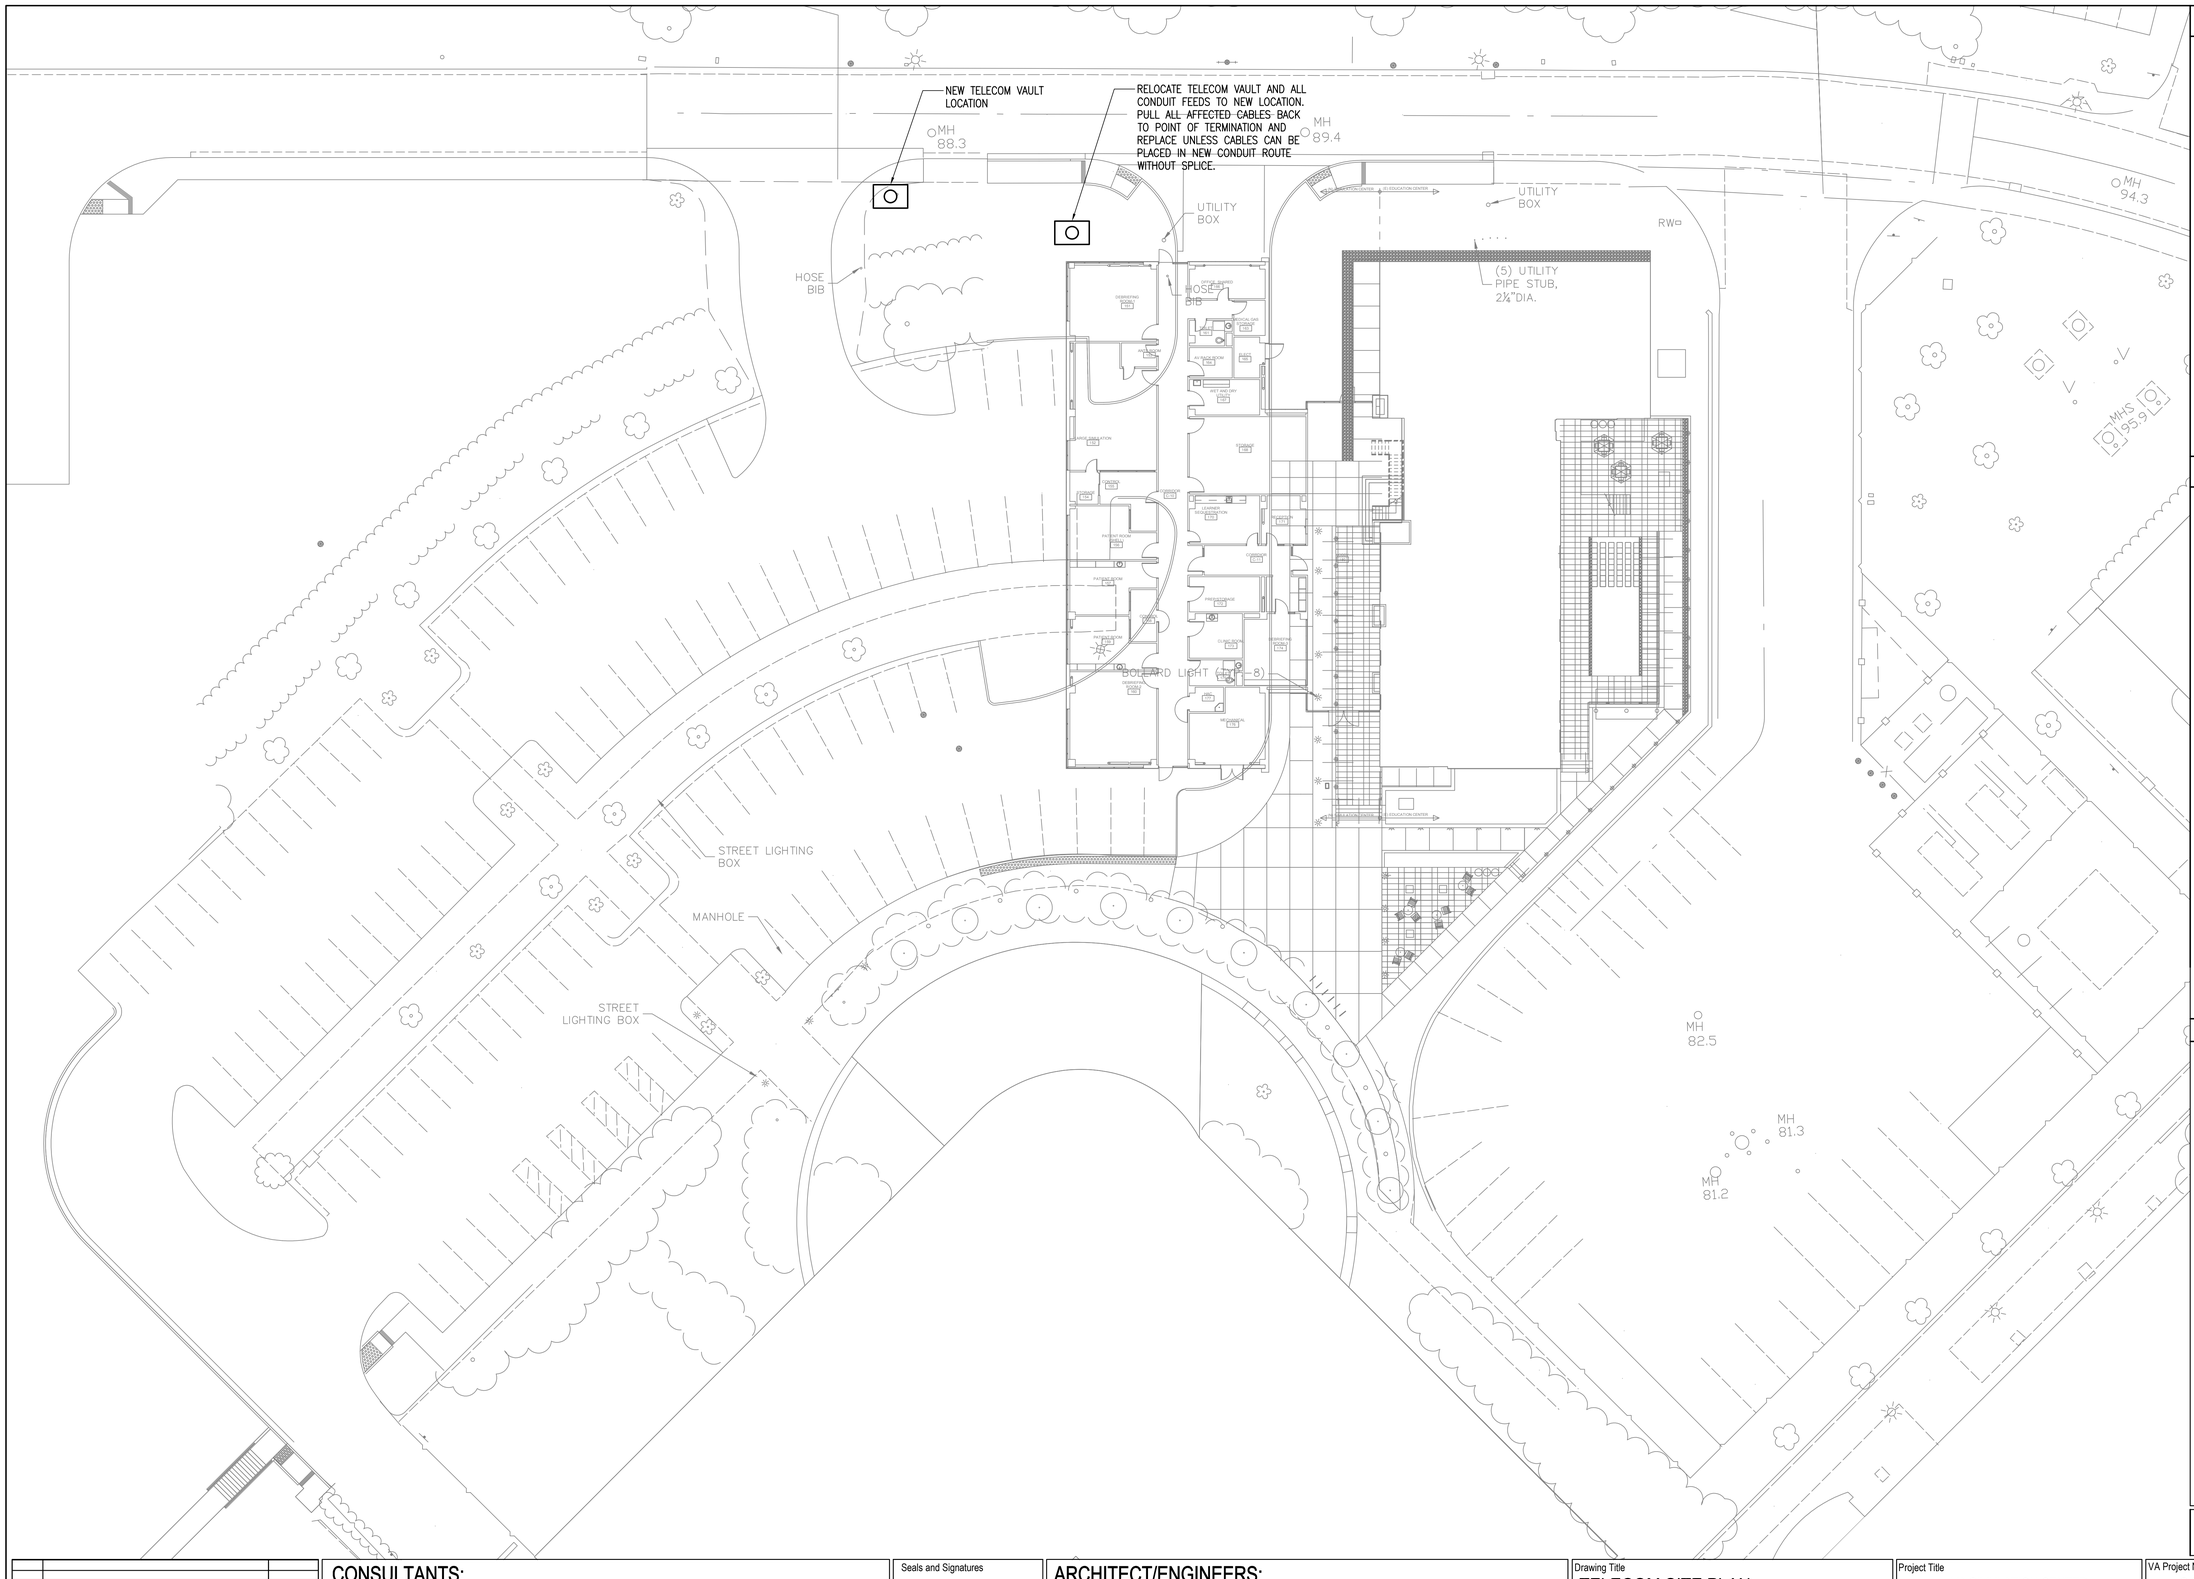

GENERAL NOTES

KEY NOTES

LEGEND

ISSUE FOR BID

Revisions		Date
1	ADDENDUM 3	06/26/2014

CONSULTANTS:

SM&W
SHEN MILSOM WILKE
33 New Montgomery Street
San Francisco, CA 94105
Tel: 415-391-7610
Fax: 415-391-0171

Seals and Signatures

ARCHITECT/ENGINEERS:

CANNONDESIGN
201 Mission Street, Suite 2400, San Francisco, California 94105 415.243.4170
Baltimore ■ Boston ■ Buffalo ■ Calgary ■ Chicago
Houston ■ Los Angeles ■ Mumbai ■ New York ■ Phoenix
St. Louis ■ San Francisco ■ Shanghai ■ Toronto
Vancouver ■ Victoria ■ Washington DC

Drawing Title: TELECOM SITE PLAN

Project Title: VA SIMULATION CENTER

VA Project Number: 640-385

Building Number: 105

Approved: Project Director
Approver

Location: Veterans Affairs Palo Alto Heath Care System
3801 Miranda Ave,Palo Alto, CA 94304

Date: JUNE 26, 2014 | Checked: SS | Drawn: RM

Drawing No. TC0100 1

VA PAHCS Veterans Affairs Palo Alto Health Care System

Department of Veterans Affairs