


REVISION:
GRAPHICALLY DEPICTED STEPPED FOOTING

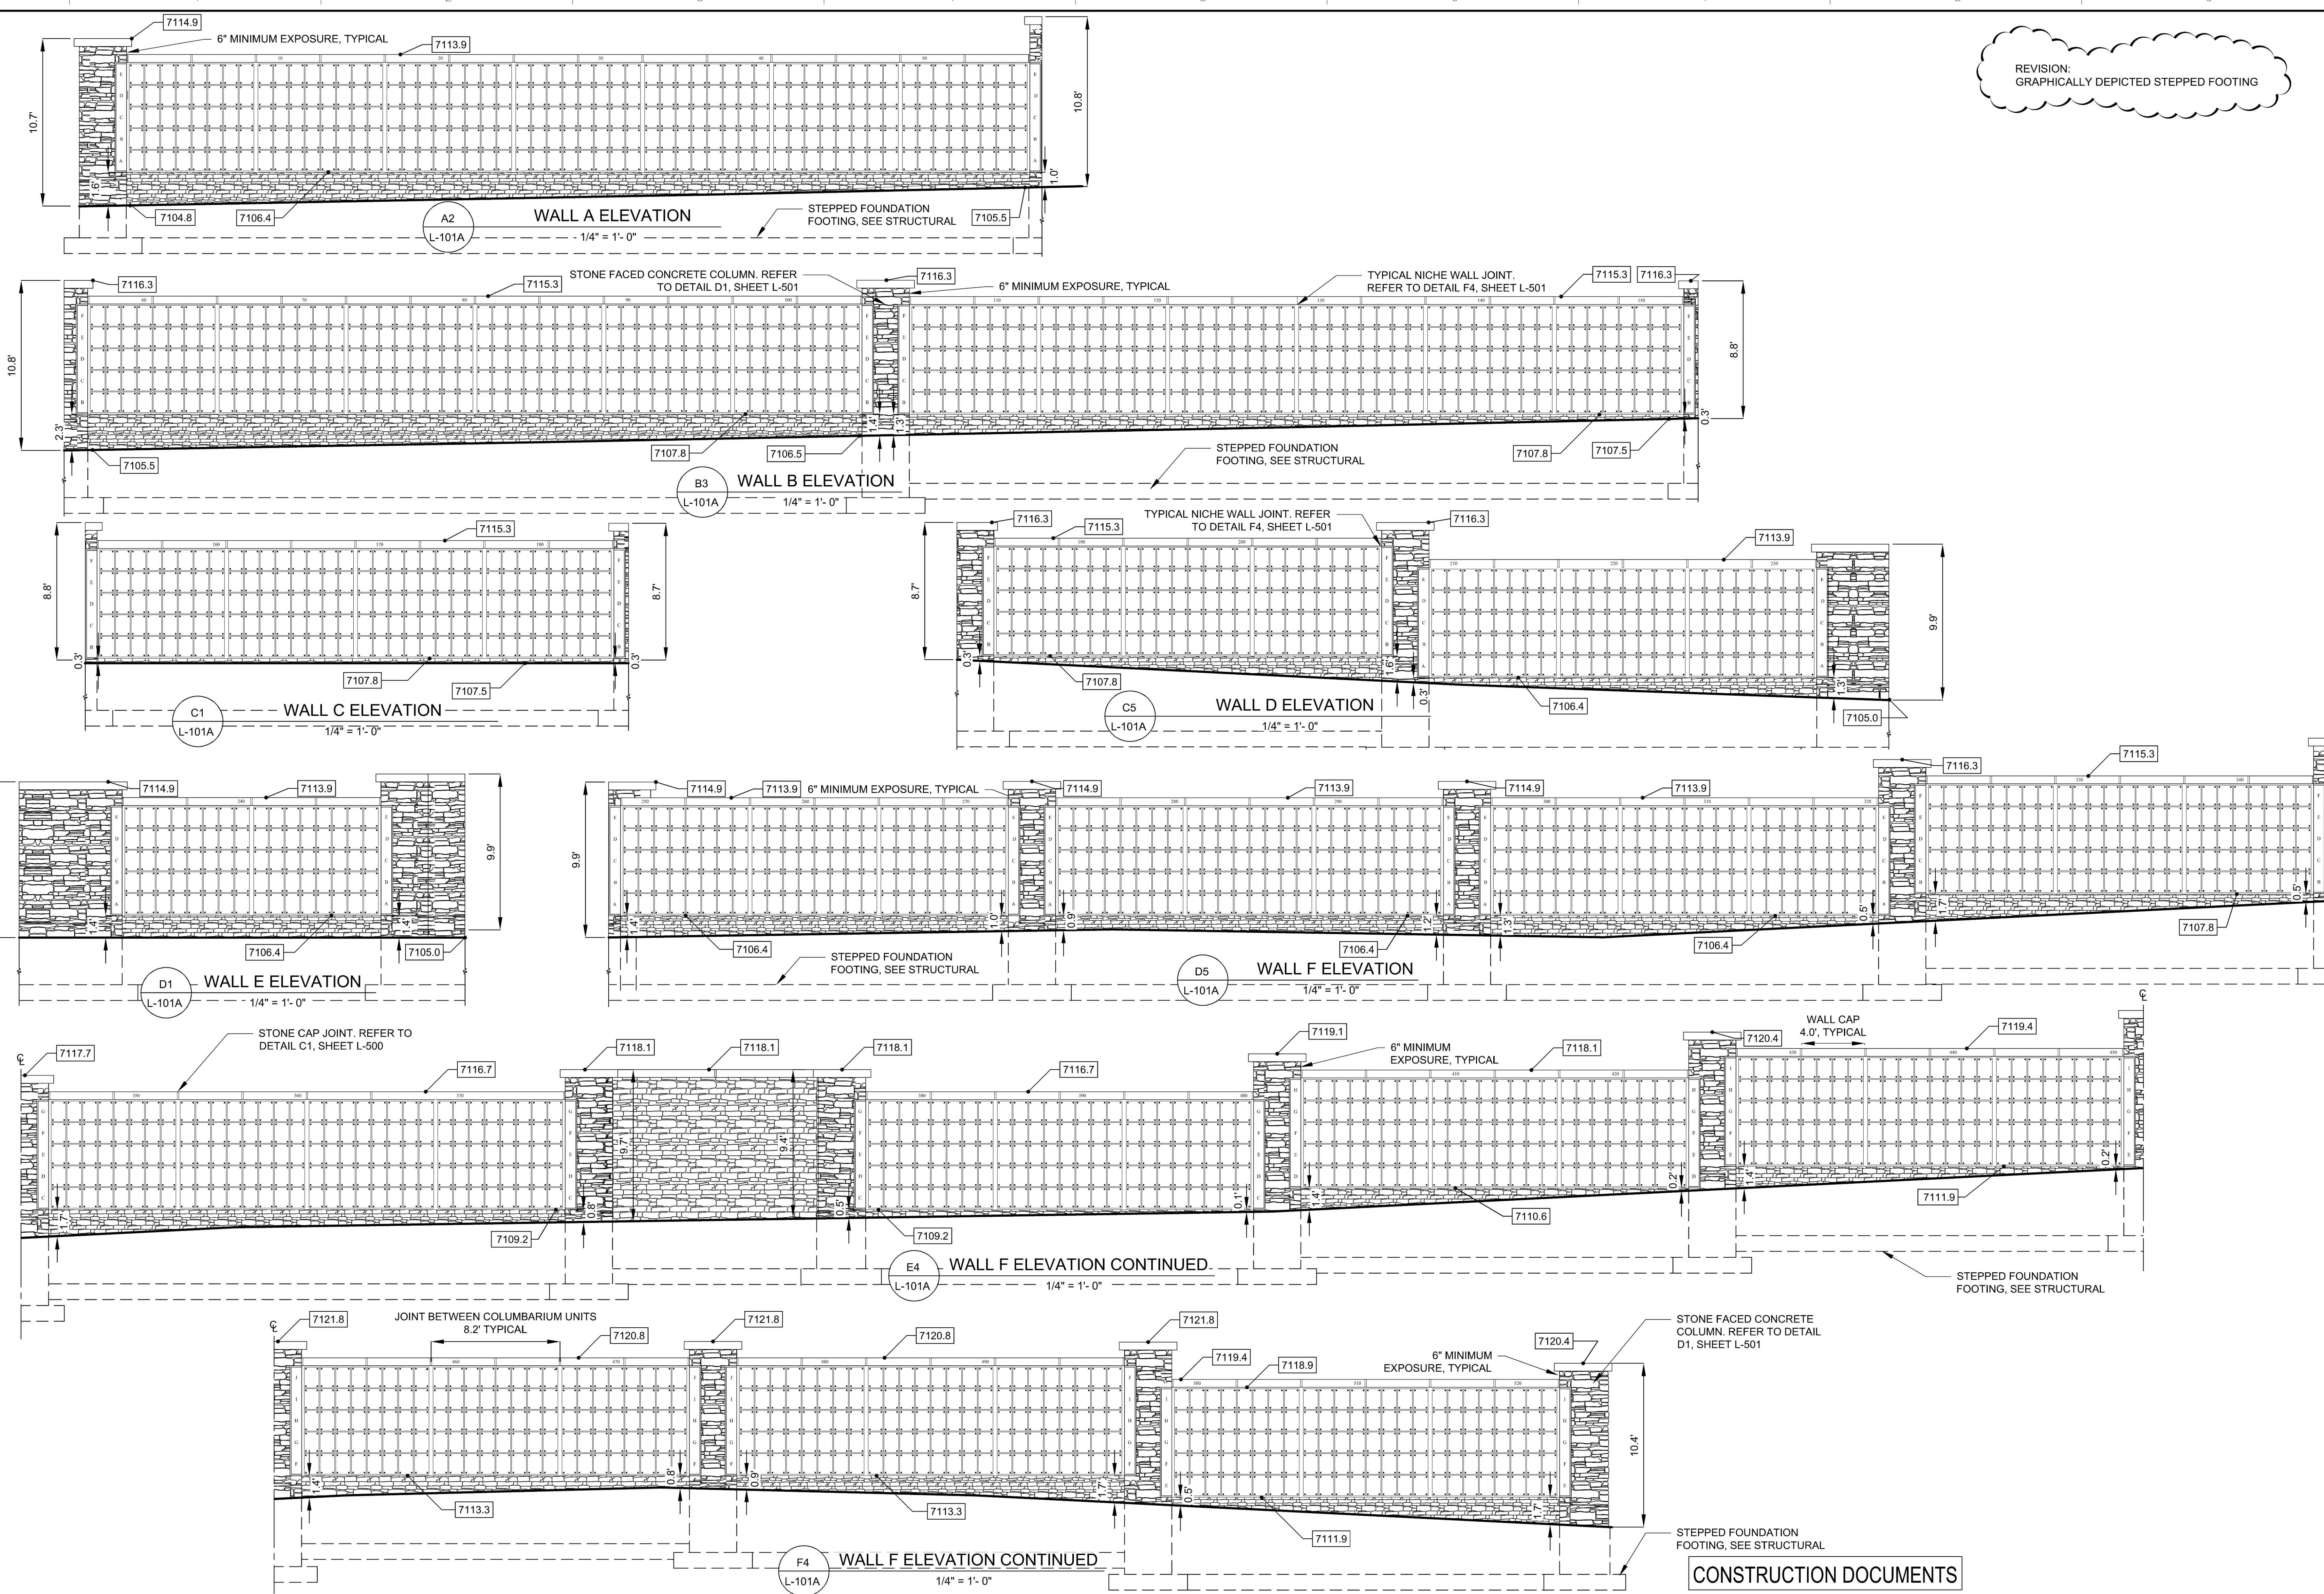

CONSTRUCTION DOCUMENTS

--	--	