
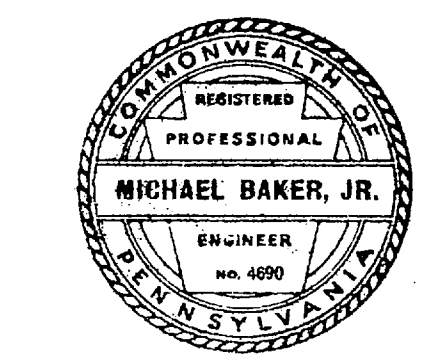


BASEMENT FLOOR PLAN
SCALE 1/8" = 1'-0"

- NOTES**
1. CONTRACTOR SHALL FIELD CHECK CLEARANCE BEFORE INSTALLING NEW O.A. DUCTWORK AND IF NECESSARY, MOVE AND/OR INSTALL NEW EXHAUST DUCTS TO ACCOMMODATE NEW O.A. DUCTS.
 2. FOR SCHEDULE OF A.C. ROOM UNITS SEE SH. 1-H2
 3. DROP NEW 1/2" COND. DRAIN DOWN BELOW FLOOR AND RUN NEW 2" DRAIN UNDER FLOOR - CONNECT TO EXIST. DOWN SPOUT DRAIN AS SHOWN.
 4. STUB-UP & CONN. TO COND. DRAIN LINE DROPPING DN. FROM FIRST FLOOR

CONDITIONS AT SITE OF WORK
CONTRACTORS MUST VISIT THE SITE TO ASCERTAIN PERTINENT LOCAL CONDITIONS READILY DETERMINED BY INSPECTION AND INQUIRY, SUCH AS THE LOCATION, ACCESSIBILITY AND GENERAL CHARACTER OF THE SITE, LABOR CONDITIONS, THE CHARACTER AND EXTENT OF EXISTING WORK WITHIN OR ADJACENT THERETO, AND ANY OTHER WORK PERFORMED THEREON.

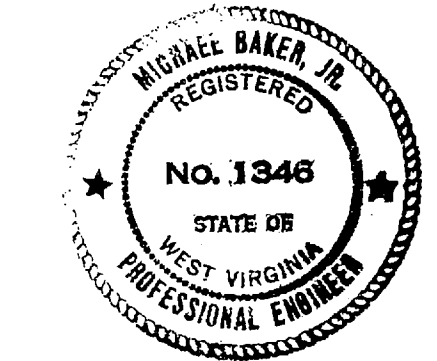

REVISION	DATE	BY	DESCRIPTION
1	10-64	AS BUILT	REVISION
BASEMENT FLOOR PLAN - SECTIONS & DETS. AIR CONDITION MAIN HOSPITAL BLDG. NO. 1 VETERANS ADMINISTRATION CLARKSBURG, W. VA.			
DRAWN: R.L.B.	PROJ. MGR: R.B.	CHECKED: R.A.S.	DATE: 4-23-65
MICHAEL BAKER JR. INC. CONSULTING ENGINEERS BAKER BUILDING ROCHESTER, PENN.			
DRAWING NUMBER 1-H3			SHEET 3 OF 10
APPROVED: ACT & DIR. COORD. & EVAL. STAFF PROJECT NO. 47-5138			