


REVISIONS				
ZONE	REV	DESCRIPTION	DATE	APPROVED
		Added new note 8 & 9. Modified existing notes. Added existing electrical items.	07/15/14	SR

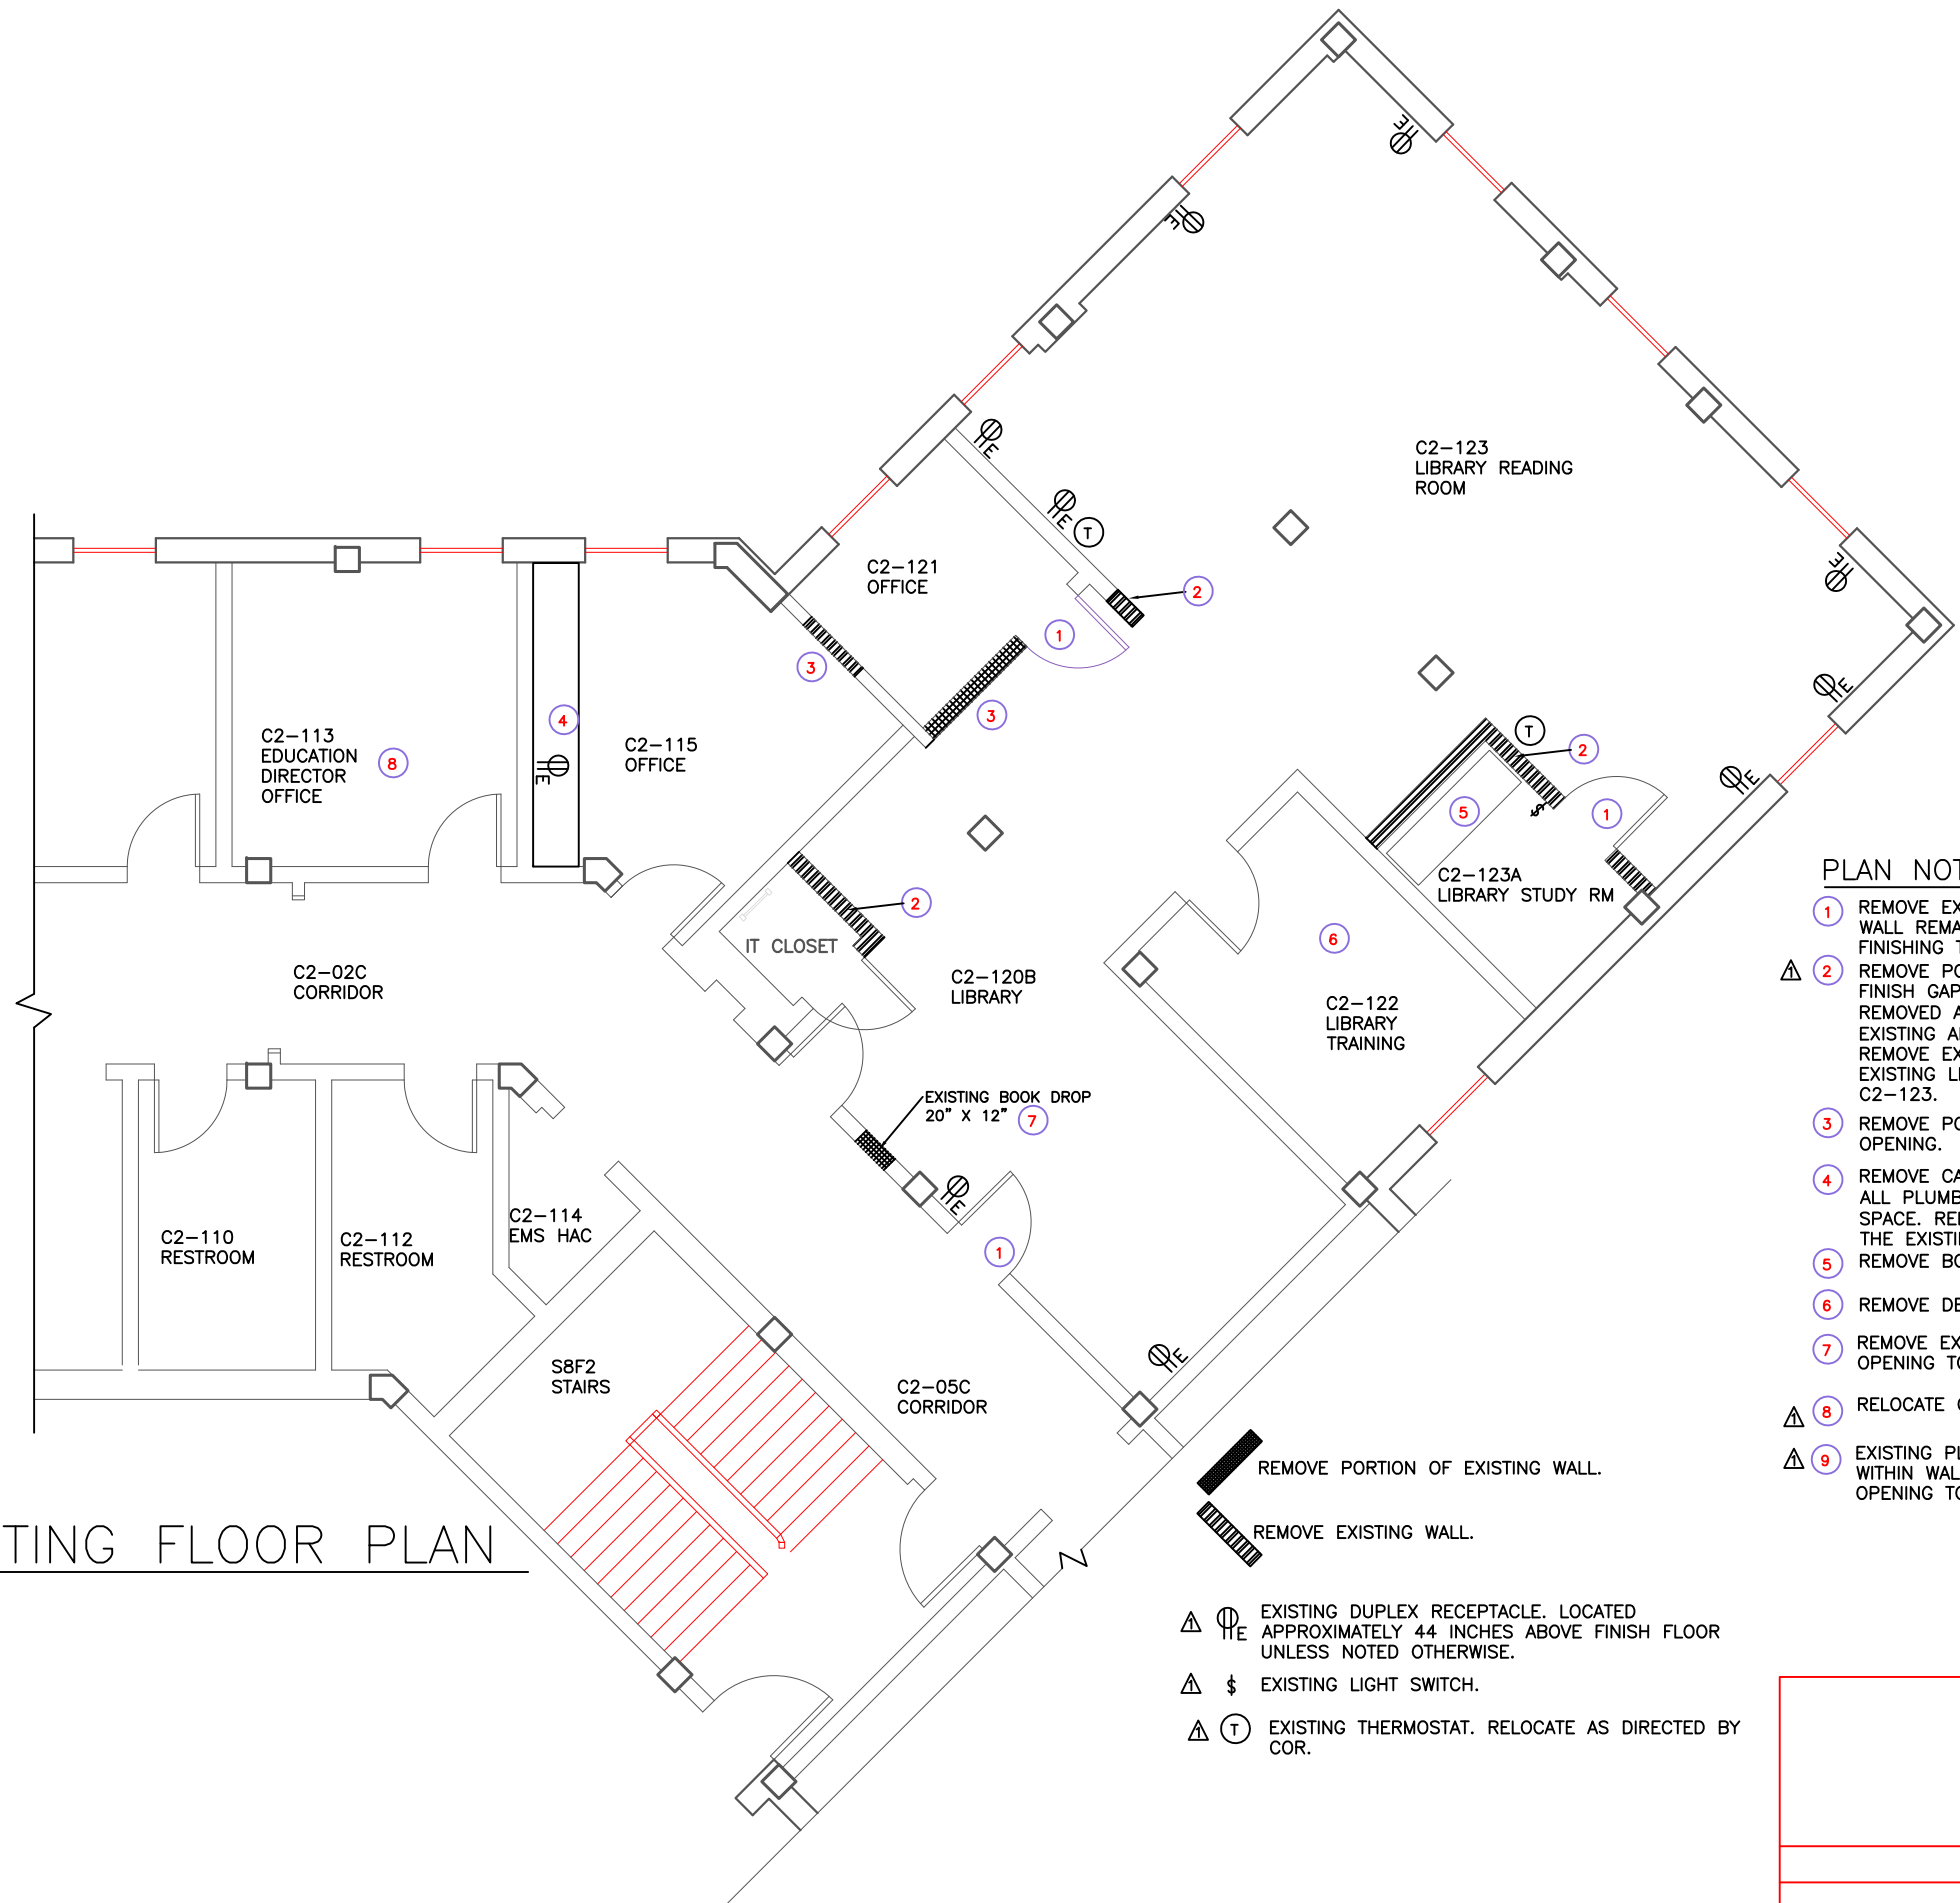

PLAN NOTES

- 1 REMOVE EXISTING DOOR FRAME. WHERE EXISTING WALL REMAINS, PROVIDE SHEATHING AND FINISHING TO MATCH EXISTING, ADJACENT WALL.
- 2 REMOVE PORTION OF EXISTING WALL. REPAIR AND FINISH GAP AT INTERSECTION OF WHERE WALL IS REMOVED AND EXISTING WALL/CEILING TO MATCH EXISTING ADJACENT SURFACES. IN ROOM C2-123A, REMOVE EXISTING LIGHT SWITCH AND WIRING. REWIRE EXISTING LIGHT IN TO LIGHTING SYSTEM FOR ROOM C2-123.
- 3 REMOVE PORTION OF EXISTING WALL FOR NEW OPENING.
- 4 REMOVE CABINETS, SHELF AND COUNTERTOP. CAP ALL PLUMBING/UTILITY PIPES WITHIN THE WALL SPACE. RELOCATE AND REINSTALL ELECTRICAL IN THE EXISTING WALL.
- 5 REMOVE BOOKCASE. RELOCATE TO ROOM C2-113.
- 6 REMOVE DESKS. RELOCATE TO ROOM C2-113.
- 7 REMOVE EXISTING BOOK DROP. PATCH & FINISH OPENING TO MATCH EXISTING, ADJACENT WALL.
- 8 RELOCATE OFFICE FURNITURE TO ROOM C2-122.
- 9 EXISTING PLUMBING STUB OUT TO BE CAPPED WITHIN WALL SPACE. FINISH RESULTANT WALL OPENING TO MATCH EXISTING, ADJACENT WALL.

- EXISTING DUPLEX RECEPTACLE. LOCATED APPROXIMATELY 44 INCHES ABOVE FINISH FLOOR UNLESS NOTED OTHERWISE.
- EXISTING LIGHT SWITCH.
- EXISTING THERMOSTAT. RELOCATE AS DIRECTED BY COR.

REMOVE PORTION OF EXISTING WALL.

REMOVE EXISTING WALL.

EXISTING FLOOR PLAN

DEPARTMENT OF VETERAN AFFAIRS VETERANS HEALTH ADMINISTRATION			
REMODEL CENTER FOR EMPLOYEE DEVELOPMENT & TRAINING SIMULATION ROOM			
SIZE	FSCM NO.	SHEET TITLE	REV
		EXISTING FLOOR PLAN	
DATE: MARCH 26, 2014		SHEET	2 OF 4