


REVISIONS			
ZONE	REV	DESCRIPTION	DATE
	1	Revised room C3-79A layout. Add new access panel. Delete removal of switches located in hallway. Delete notes 3 & 7. Modify note 8. Added note 9.	07/09/14
			SR

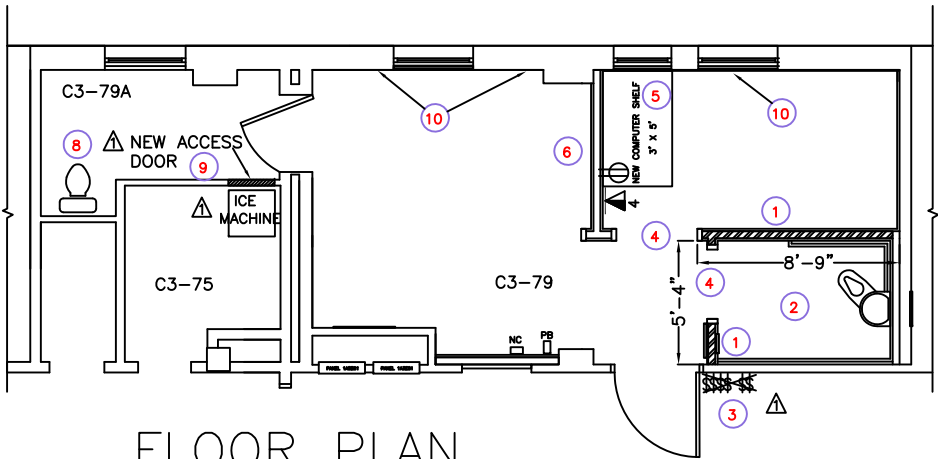


FLOOR PLAN
TRAINING SIMULATION ROOM

REMOVE EXISTING WALL.

- NEW DATA OUTLET - SUBSCRIPT INDICATES NUMBER OF CABLE/JACKS. INSTALL NEW CABLE (CAT 6) FROM IT ROOM. MOUNTING HEIGHT & LOCATION TO BE DETERMINED AT TIME OF INSTALLATION. CERTIFY ALL CAT 6 CABLE. SEE DETAIL, THIS SHEET.
- NEW DUPLEX RECEPTACLE. CONNECT TO EXISTING POWER. LOCATIONS TO BE DETERMINED AT TIME OF INSTALLATION.

PLAN NOTES

- REMOVE EXISTING WALL. REPAIR AND FINISH GAP AT INTERSECTION OF WHERE WALL IS REMOVED AND EXISTING WALL/CEILING TO MATCH EXISTING ADJACENT SURFACES.
- REMOVE EXISTING TOILET ASSEMBLY, HAND RAILS, TILE FLOORING. INSTALL NEW FLOORING TO MATCH EXISTING, ADJACENT FLOORING. INSTALL NEW COVE BASE.
- REMOVE EXISTING ELECTRICAL SWITCHES AND WALL MOUNTED CONDUIT/WIRING. INSTALL NEW SWITCHES AND REWIRE TO EXISTING FIXTURES. LOCATE NEW SWITCHES IN ROOM INTERIOR, AS DIRECTED.
- REMOVE EXISTING DOOR FRAME. WHERE EXISTING WALL REMAINS, PROVIDE SHEATHING AND FINISHING TO MATCH EXISTING, ADJACENT WALL.
- CONSTRUCT NEW COMPUTER SHELF. SHELF SHALL BE CONSTRUCTED TO SUPPORT 500 LBS. PROVIDE LAMINATE FINISH, COLOR TO BE SELECTED BY VA.
- CONSTRUCT NEW ONE WAY MIRROR IN EXISTING OPENING. MIRROR SIZE 4 FT. HIGH X 5 FT. WIDE.
- NEW WALL: METAL STUDS W/ 5/8" FR. GYPSUM BOARD, BOTH SIDES. FULL DEPTH ACOUSTIC BATT INSULATION (STC 45), FRICTION-FIT IN STUD SPACE, FULL HEIGHT OF ASSEMBLY.
- REMOVE EXISTING WATER CLOSET. INSTALL NEW FLOOR DRAIN. RELOCATE ICE MACHINE FROM ROOM C3-75. CONNECT ICE MACHINE DRAIN LINE TO NEW FLOOR DRAIN. CONNECT WATER SUPPLY TO ICE MACHINE. INSTALL FLOOR DRAIN & ICE MACHINE DRAIN IN ACCORDANCE WITH THE INTERNATIONAL PLUMBING CODE. REPAIR FLOORING TO MATCH EXISTING.
- ACCESS DOOR SHALL BE CONSTRUCTED TO PROVIDE VENTILATION INTO THE ICE MACHINE (CONSTRUCT WITH A GRILL). INSTALLATION OF NEW DOOR WILL REQUIRE RELOCATING EXISTING WATER SUPPLY, AND REFINISHING EXISTING WALL SURFACES. ROOM C3-75 WALL FINISH IS CERAMIC TILE (HALF HEIGHT) & GYPSUM BOARD. DOOR HARDWARE: BUTT HINGES, WITH STOREROOM LOCK.
- WALL TO RECEIVE ACCENT PAINT. COLOR TO BE SELECTED.

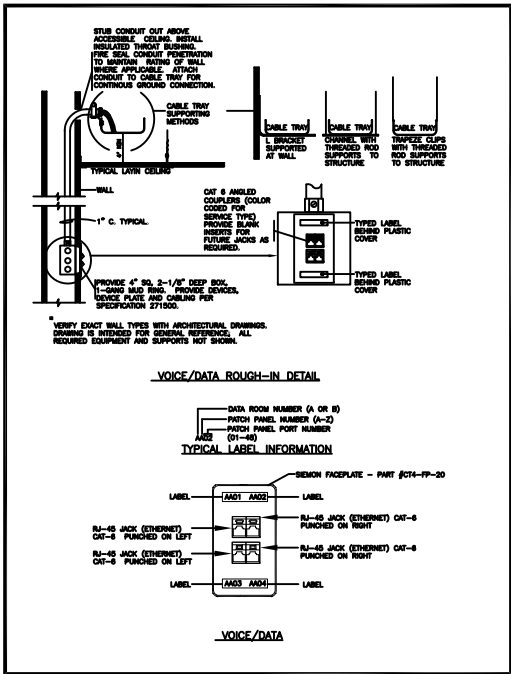

DEPARTMENT OF VETERAN AFFAIRS VETERANS HEALTH ADMINISTRATION			
REMODEL CENTER FOR EMPLOYEE DEVELOPMENT & TRAINING SIMULATION ROOM			
SIZE	FSCM NO.	SHEET TITLE:	REV
		FLOOR PLAN	
DATE: MARCH 26, 2014		SHEET 4 OF 4	