

A
three inches = one foot

B
one and one-half inches = one foot

C
one inch = one foot


D
three-quarters inch = one foot

one-half inch = one foot

three-eighths inch = one foot

— one-quarter inch = one foot

one-eighth inch = one foot

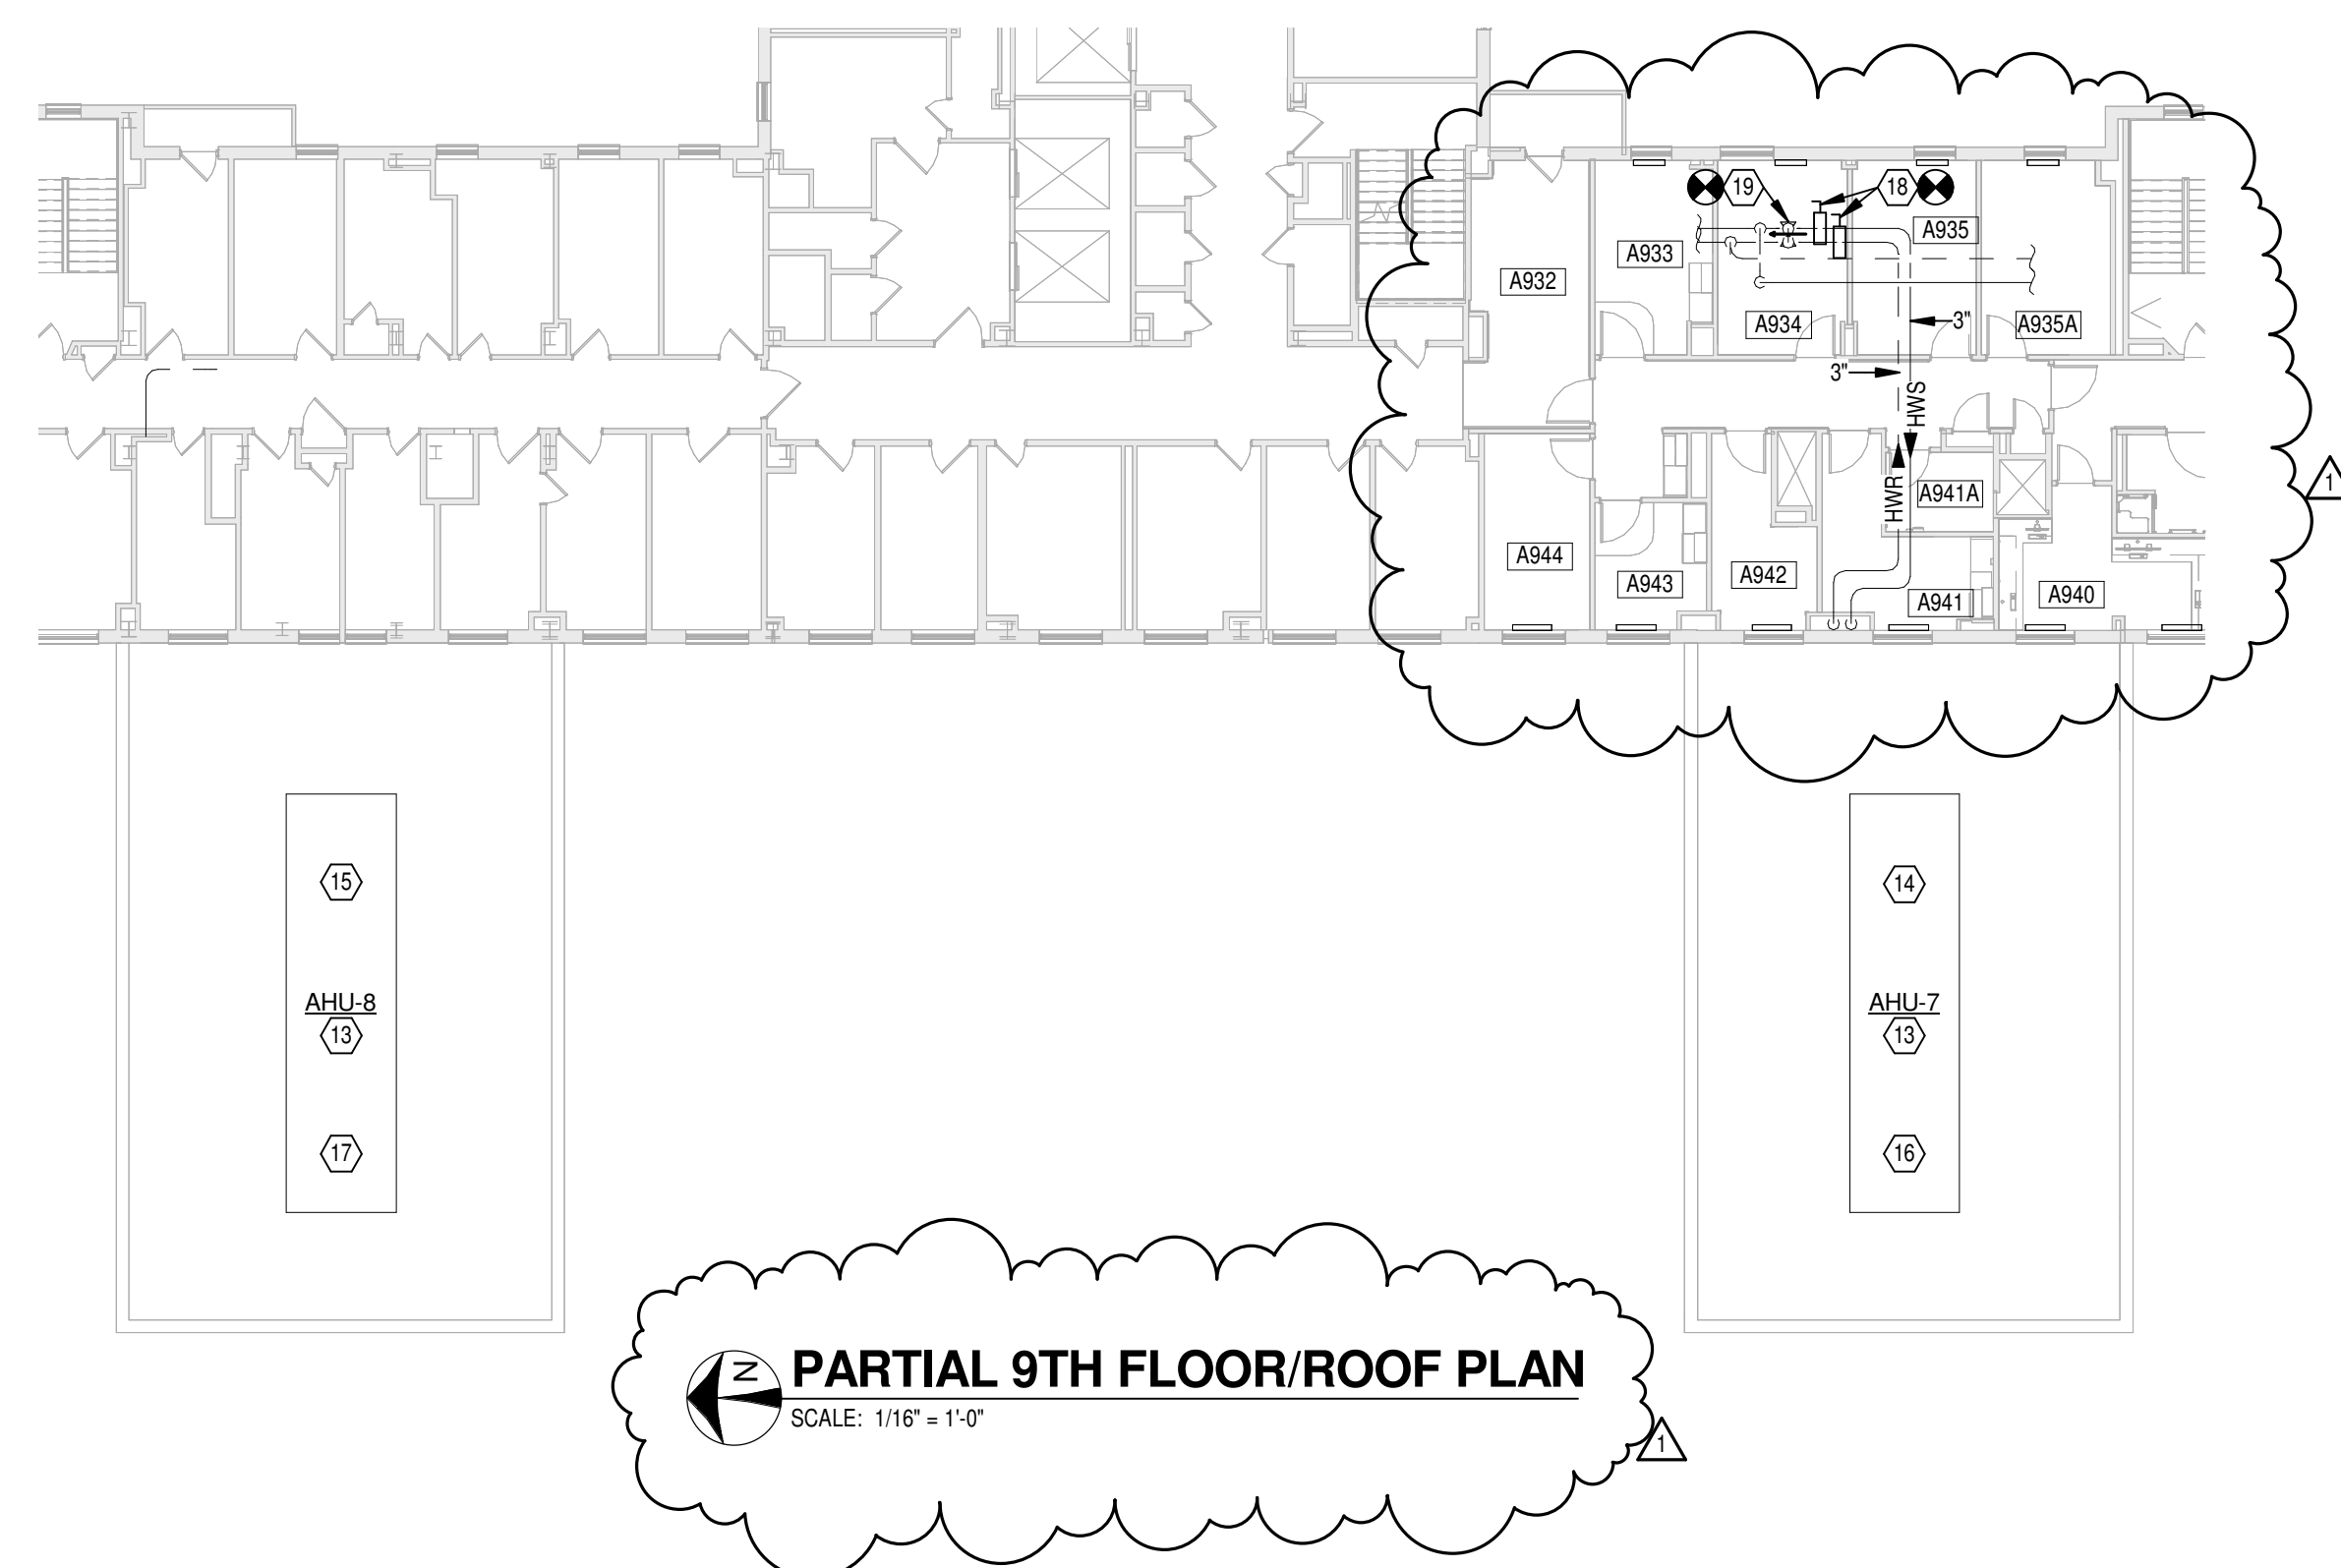



ROOM NAMES AND NUMBERS		
Number	Name	Station

GENERAL NOTES

A	REFER TO SHEET M001 FOR LEGEND, ABBREVIATIONS, AND ADDITIONAL GENERAL NOTES.
B	ALL HEATING HOT WATER SUPPLY AND RETURN RUNOUTS TO VAV BOXES SHALL BE 0.75" DIA. UNLESS NOTED OTHERWISE.
C	REFER TO AIR TERMINAL UNIT PIPING DETAILS ON SHEET M501 FOR SCOPE OF REPLACEMENT OF UNIT PIPING SPECIALTIES UNDER BID ITEM 1 AND BID ITEM 2.
D	BALANCING OF AIR DEVICES AND AIR HANDLER FANS SHALL BE DELETED FROM THIS PROJECT UNDER BID ITEM 3. TAB OF VAV BOXES SHALL REMAIN IN THE PROJECT EVEN IF BID ITEM 3 IS TAKEN.


NOTES

1. EXISTING DUCTWORK TO REMAIN.
2. EXISTING RECESSED STEAM CONVECTOR TO REMAIN. RAISE EXISTING STEAM HEATING ELEMENT INSIDE CONVECTOR CABINET AND REPLACE SELF CONTAINED STEAM CONTROL VALVE WITH NEW DDC CONTROL VALVE. REFER TO DETAIL ON SHEET M602. STEAM CONTROL VALVE SHALL BE CONTROLLED BY INDICATED VAN BOX DDC CONTROLLER.
3. EXISTING AIR VALVE DEVICE TO REMAIN. BALANCE TO INDICATED CFM.
4. EXISTING PIPING TO REMAIN.
5. APPROXIMATE LOCATION OF TEMPORARY PLASTIC DUST BARRIER FOR REMOVAL AND REPLACEMENT OF EQUIPMENT INSIDE THIS AREA.
6. PROVIDE NEW WALL HUNG STEAM CONVECTOR. REFER TO SCHEDULE ON SHEET M601 AND DETAIL ON SHEET M602. STEAM CONTROL VALVE SHALL BE CONTROLLED BY INDICATED VAN BOX DDC CONTROLLER.
7. NEW PIPING RUNNINGS TO AIR TERMINAL UNIT AND ASSOCIATED SPECIALTIES TAKEN IN PROJECT EVEN IF BID ITEM 2 IS TAKEN.
8. EXISTING EXHAUST AIR DEVICE TO REMAIN.
9. EXISTING RECESSED STEAM CONVECTOR TO REMAIN. PROVIDE NEW SELF CONTAINED NON-ELECTRIC STEAM CONTROL VALVE WITH REMOTE SENSING ELEMENT MOUNTED BELOW EXISTING STEAM HEATING ELEMENT TO REPLACE CONTROL VALVE. REFER TO DETAIL ON SHEET M602.
10. SUPPLY DIFFUSER IN PLenum ABOVE CEILING TO REMAIN. CLEAN DEVICE AND INSTALL EXISTING CEILING SUPPORTED FROM EXISTING CEILING GRID. BALANCE DEVICE TO INDICATED CFM.
11. UTILIZE EXISTING SPARE 120V-20A IP BREAKER IN EXISTING PANEL "C8C" FOR NEW WORK.
12. PROVIDE DDC NETWORK AREA CONTROLLER, FULLY INTEGRATE ALL NEW DDC TERMINAL UNIT CONTROLLERS TO EXISTING HEAD END THROUGH THIS PANEL. PROVIDE GRAPHICS AS SPECIFIED.
13. EXISTING VARIABLE AIR VOLUME AIR HANDLING UNIT TO REMAIN.
18. PROVIDE ISOLATION BUTTERFLY VALVES IN EXISTING PIPING.
19. PROVIDE 1.25" BYPASS WITH MANUAL VALVE BALANCE VALVE. BALANCE TO 10 GPM FOR TEMPORARY BYPASS DURING 8TH FLOOR SHUTDOWN. CLOSE BYPASS VALVE AT COMPLETION OF CONSTRUCTION. HAVE PROJECT ENGINEER LOCKOUT/TAGOUT WHEN VALVE IS TO BE CLOSED.

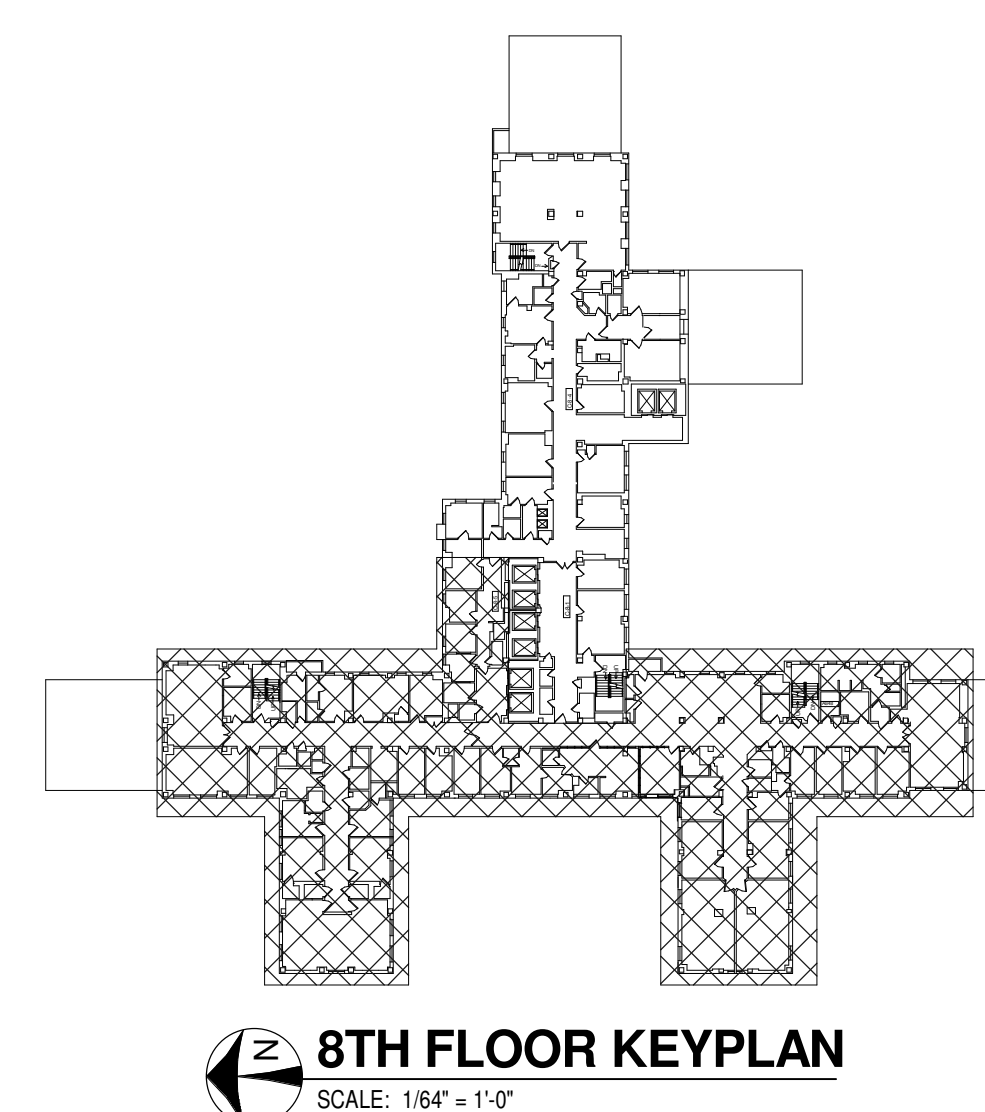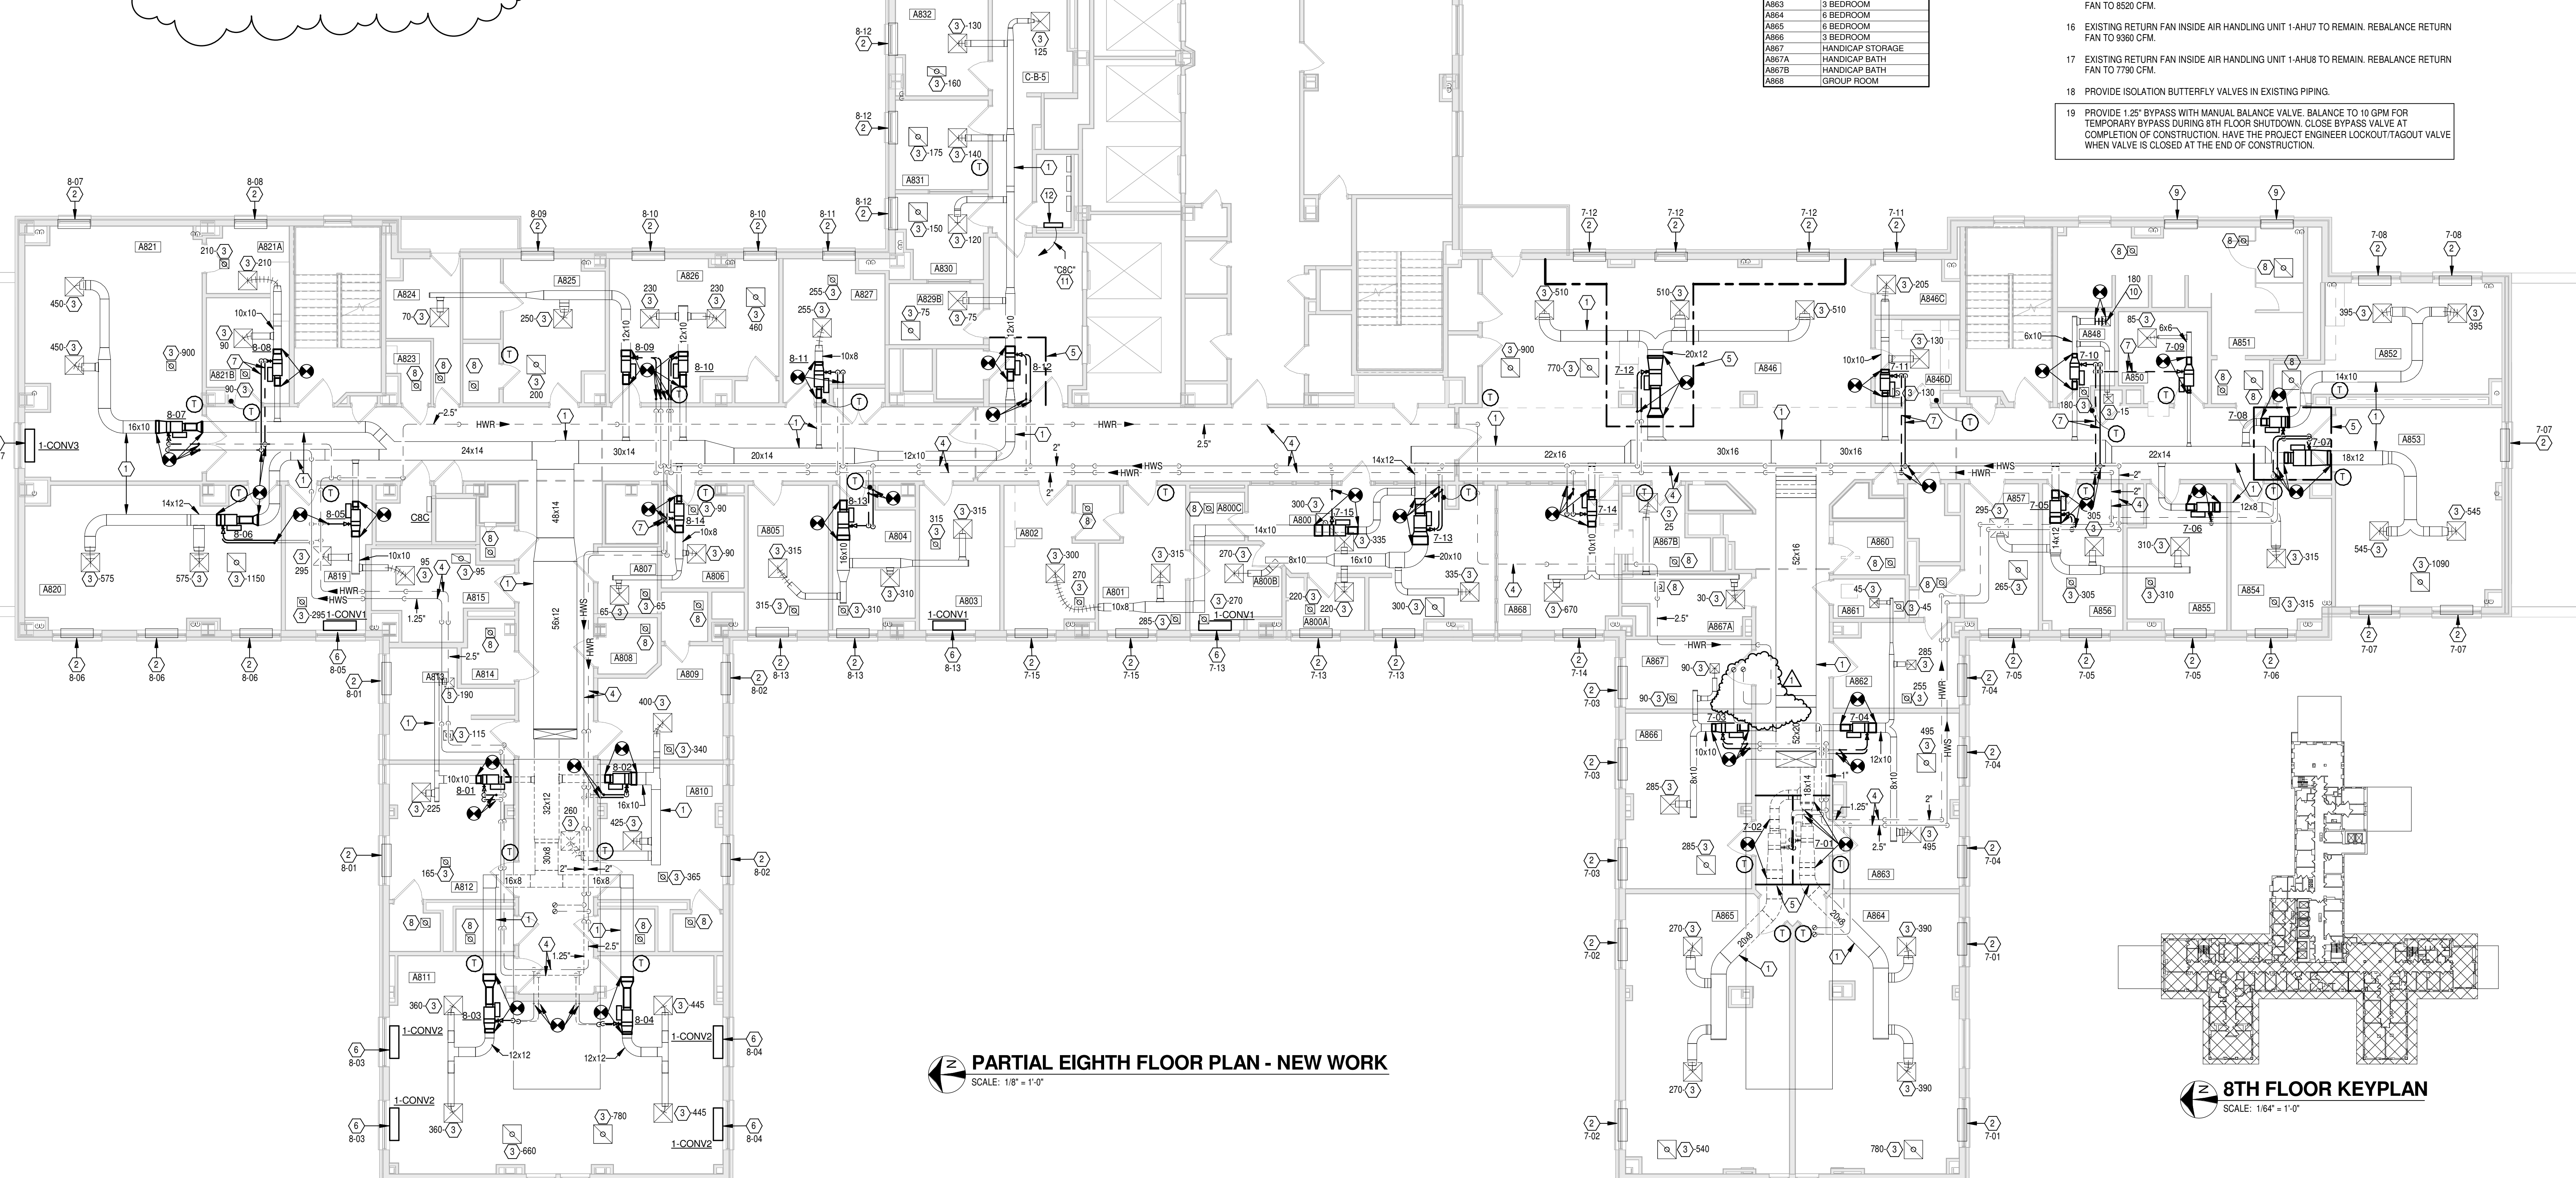

1	Amendment 1	07-24-2014
Revisions		Date

CONSULTANTS:

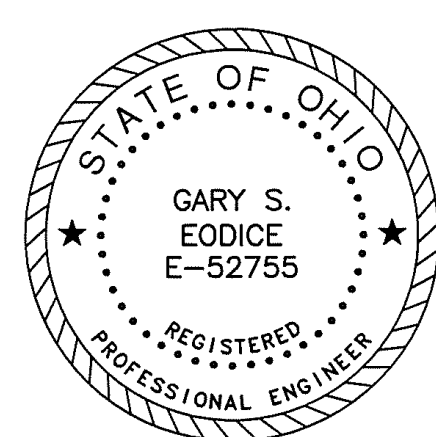

ARCHITECT/ENGINEERS:



Drawing Title

EIGHTH FLOOR PLAN - NEW WORK

Approved: Project Director

Project Title

REPLACE PNEUMATIC BOXES
ON 8TH FLOOR

Location

Cincinnati, Ohio

Date	05/22/2014
------	------------

Checked	JAC
---------	-----

Drawn
DBV

Project No.	539-15-203
-------------	------------

Building Number
1

Drawing Number
ML110

Page 5 of 8

Office of
Construction
and Facilities
Management

