


POPLAR AVENUE

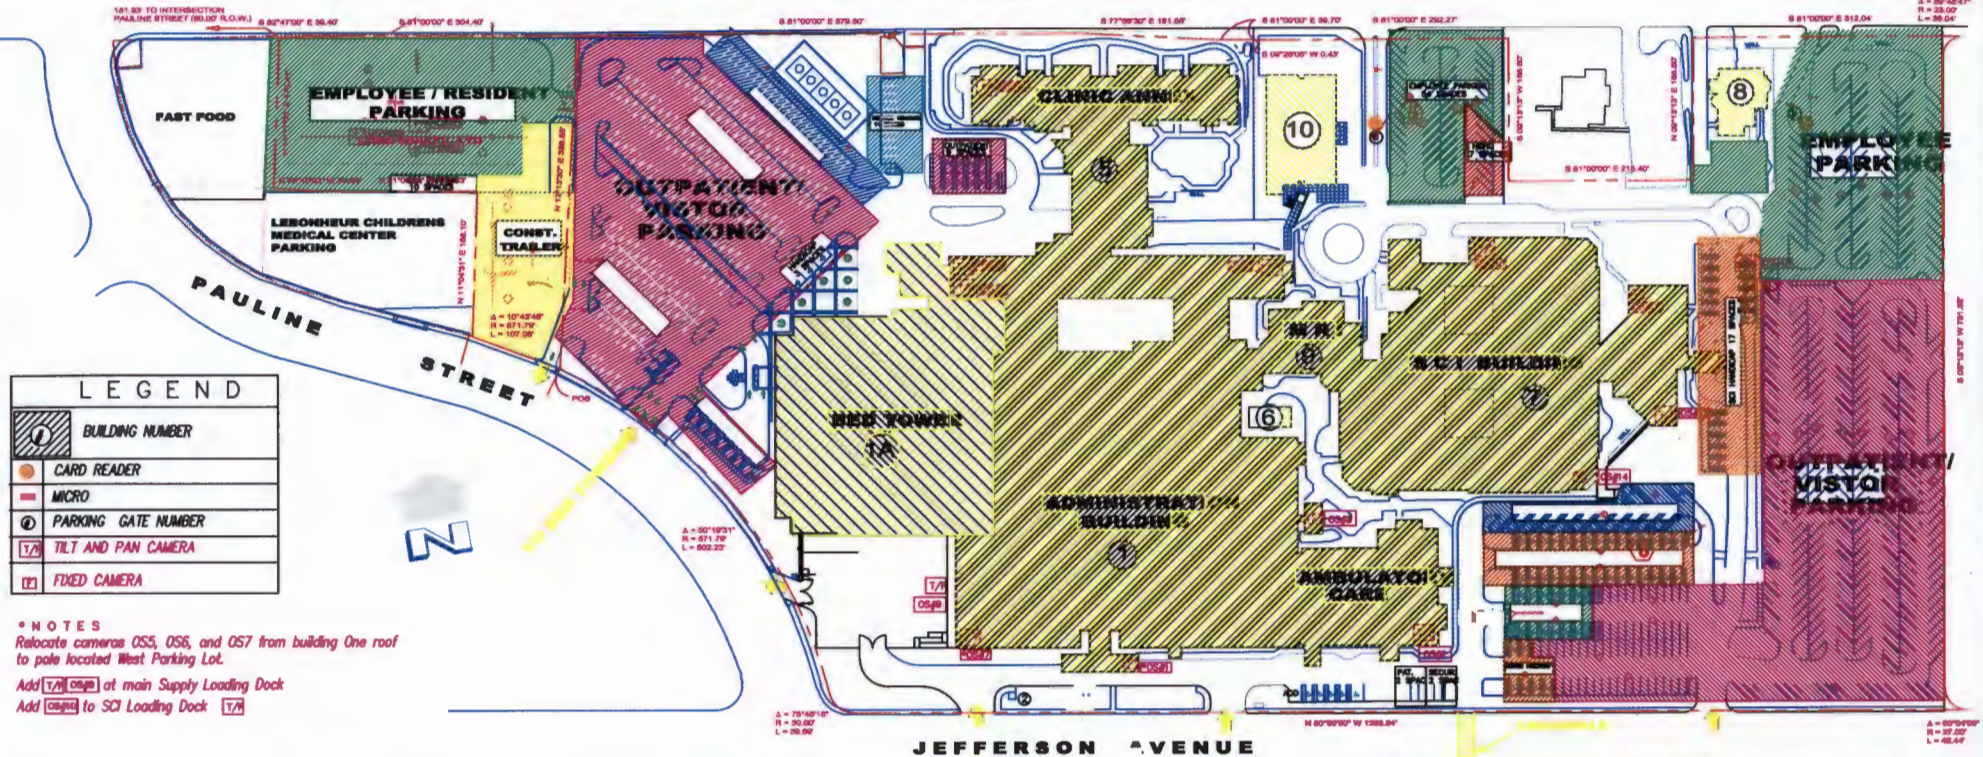

LEGEND		
1	BUILDING 1	Main Admin Bldg and Amb Care Addition
1A	BUILDING 1A	Bed Tower (Sclenic Addition)
5	BUILDING 5	Clinic Annex
6	BUILDING 6	Telephone Switch
7	BUILDING 7	Spinal Cord Injury Addition
8	BUILDING 8	(Property 10)
9	BUILDING 9	MRI
10	BUILDING 10	Engineering Shops


SITE PLAN VA MEDICAL CENTER 1000 AVENUE J MEMPHIS, TN 38104	Drawn by	C. Perry	Revisions	Date	Priority No.
	Checked by	B. Ramsey	Add Property Lines	3-3-00	
	Scale	1" = 50'-0"		3-3-00	
	Date	June 1999			

PAULINE STREET

JACKSON PERSON & ASSOCIATES, INC. 3/25/98 25.23 ACRES
 GRACE & ASSOCIATES, INC. 5/9/94 1.506 ACRES
 JACKSON PERSON & ASSOCIATES, INC. 5/31/98 4.768 ACRES
 LOSS J BOWERS 1
 J BOWERS 2



COURT AVENUE

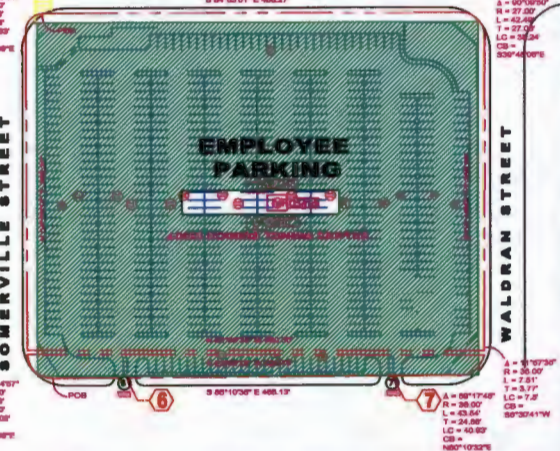

SITE PLAN VA MEDICAL CENTER 1000 AVENUE J MEMPHIS, TN 38104	Drawn by	C. Perry	Revisions	Date	Priority No.
	Checked by	B. Ramsey		3-3-00	
	Scale	1" = 50'-0"			
	Date	June 1999			